


PARENT PARCEL: 15-00-012-000-006,15-00-013-000-006, -007,15-00-029-000-001

CHILD PARCEL: 15-00-011-000-042, 15-00-012-000-026, 15-00-013-000-026,15-00-029-000-001

STARTING POINT: SOUTHEAST CORNER OF O.L.12



12-02489-D

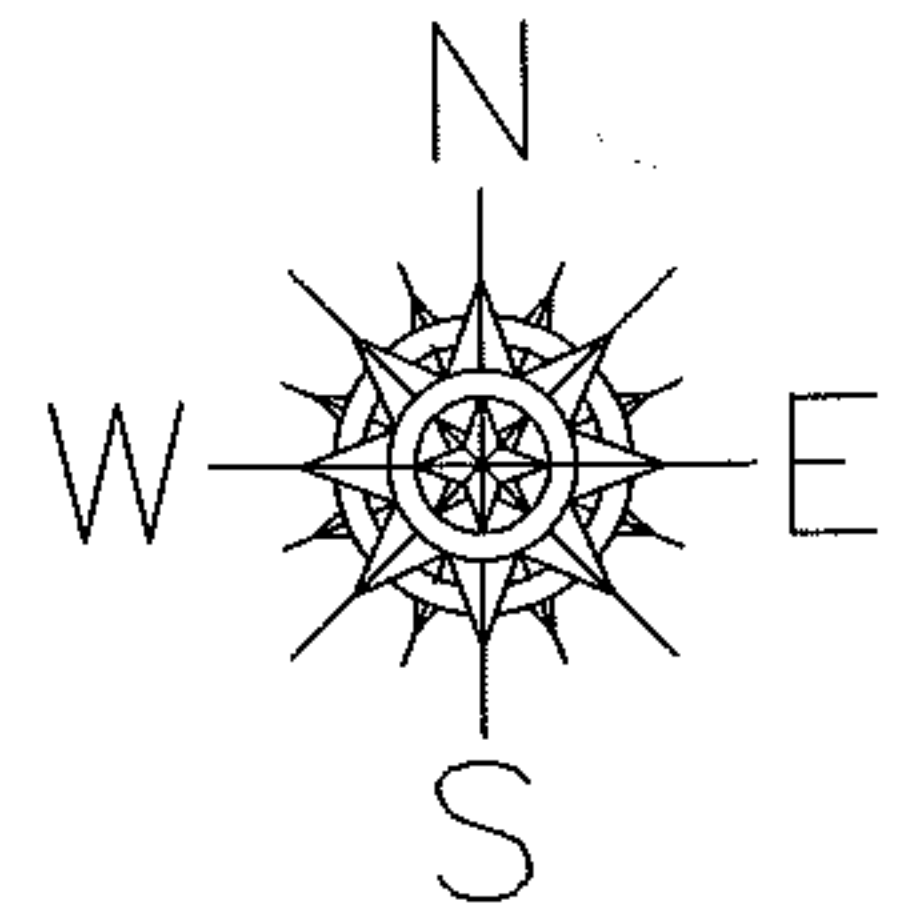

COMBINATION CORRECTION

PER SURV. D. HAYWOOD

SPLIT CORRECTION  
TO REFLECT ACERAGE BREAKDOWN  
PER SURV. D. HAYWOOD

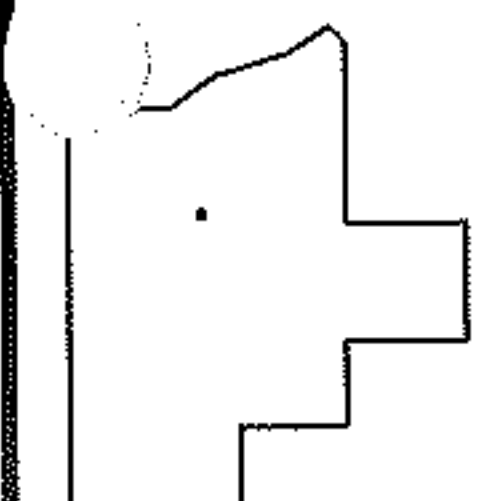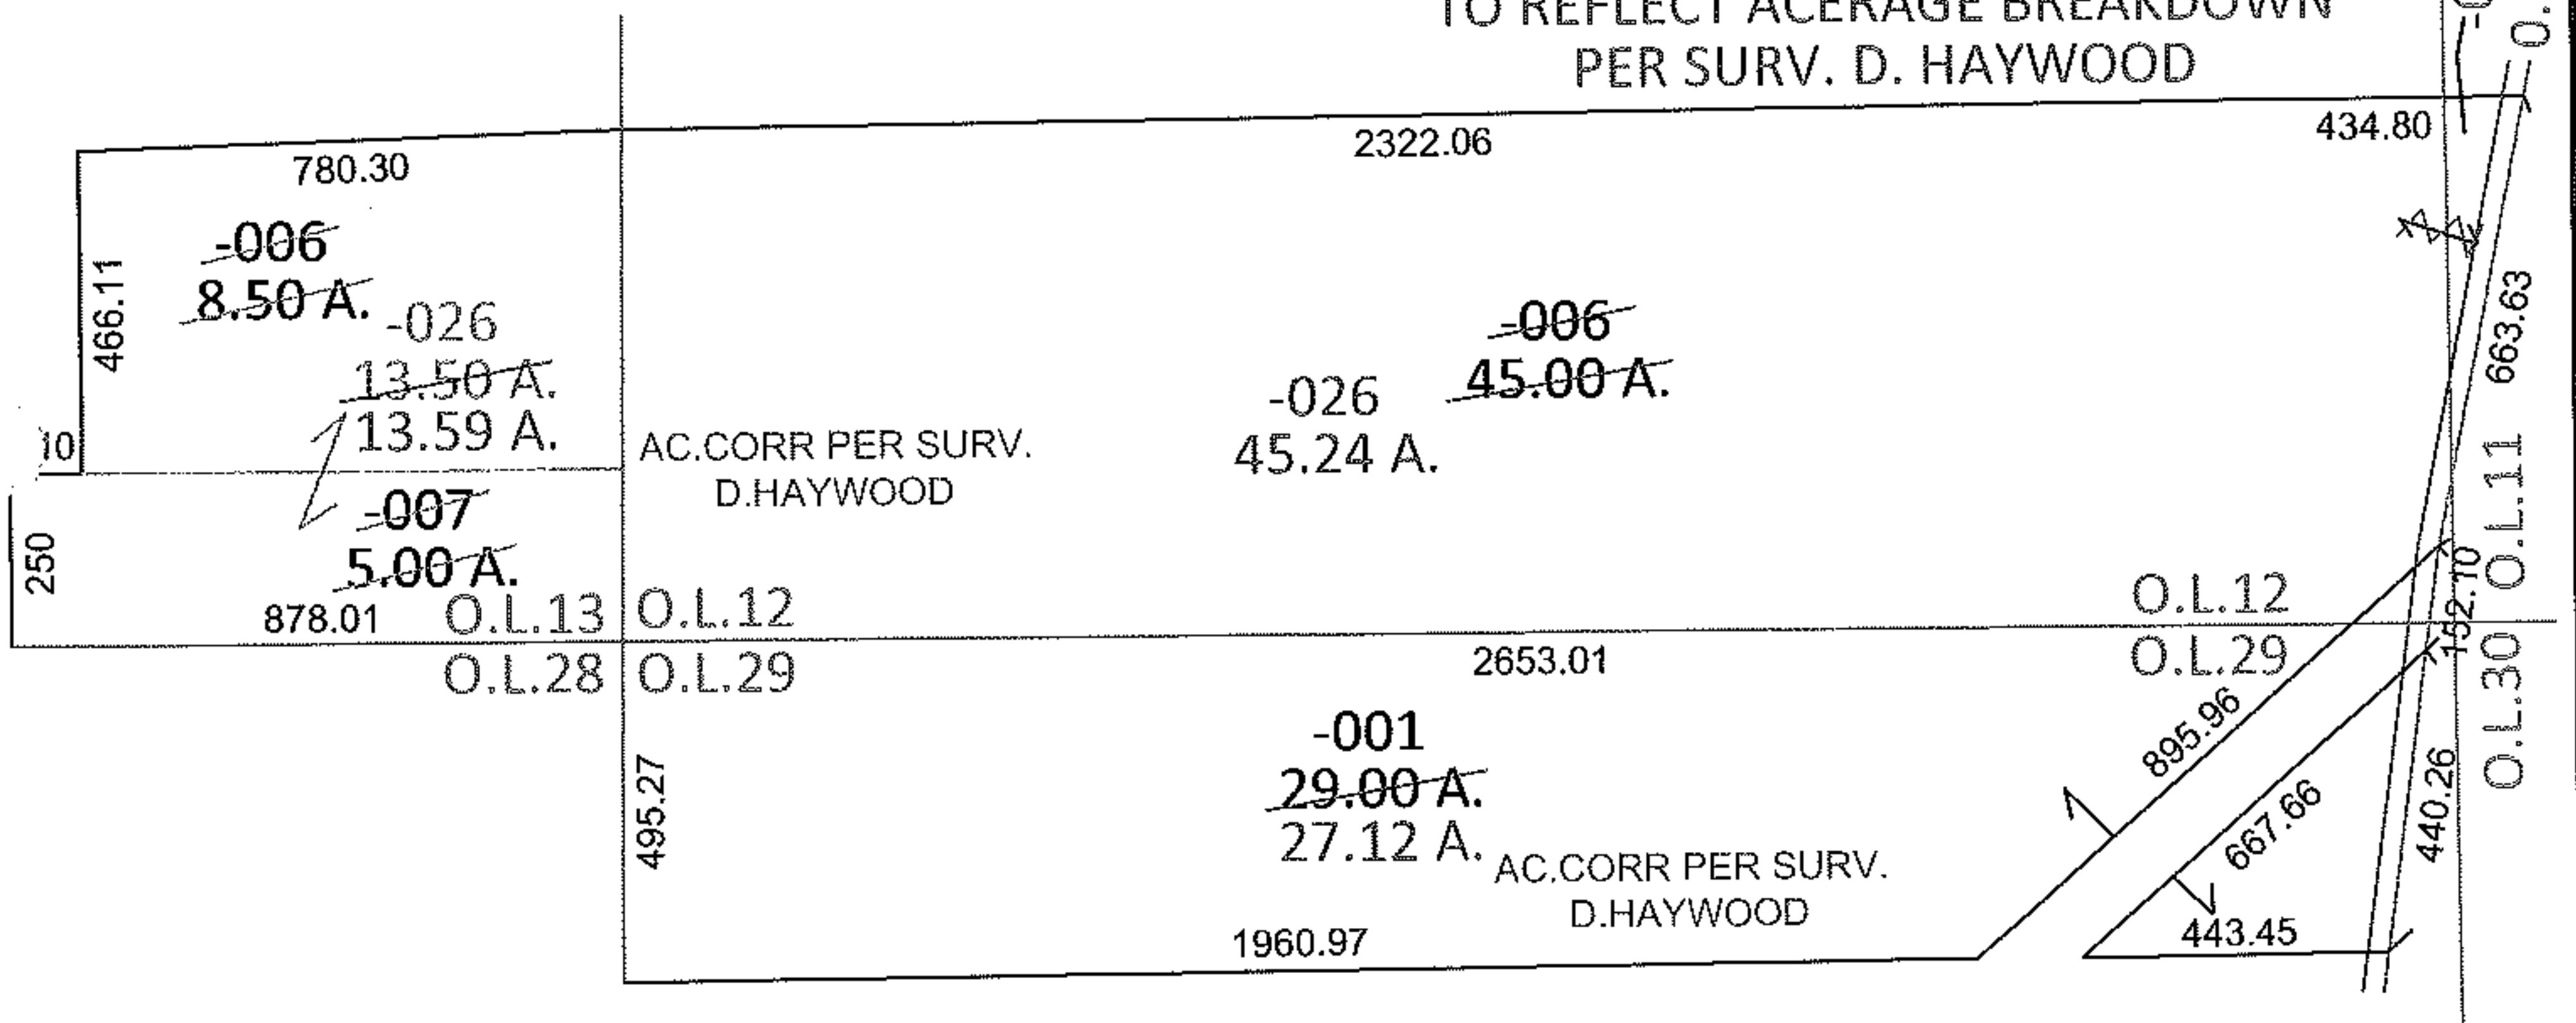

SPLITS/DEEDS PROCESSED

LORAIN COUNTY TAX MAP DEPARTMENT  
226 MIDDLE AVE. ELYRIA, OHIO

SURVEYED BY: DALE R. HAYWOOD

CLOSURE: .01:10,000

MAP PAGE(S): 15-D

APPROVED BY: RRM DATE: 4-26-12

SCALE: 1"= 500 PRIOR INST.: 20100345597