

PARENT PARCEL: 10-00-006-120-034

CHILD PARCEL: NONE

12-02490-C



STARTING POINT: CL OF GRAFTON RD. & CL OF BUTTERNUT RIDGE RD.

ACREAGE CORR. & MAP CORR.

10-00-006-120-034

~~100 X 270~~

0.60 A.

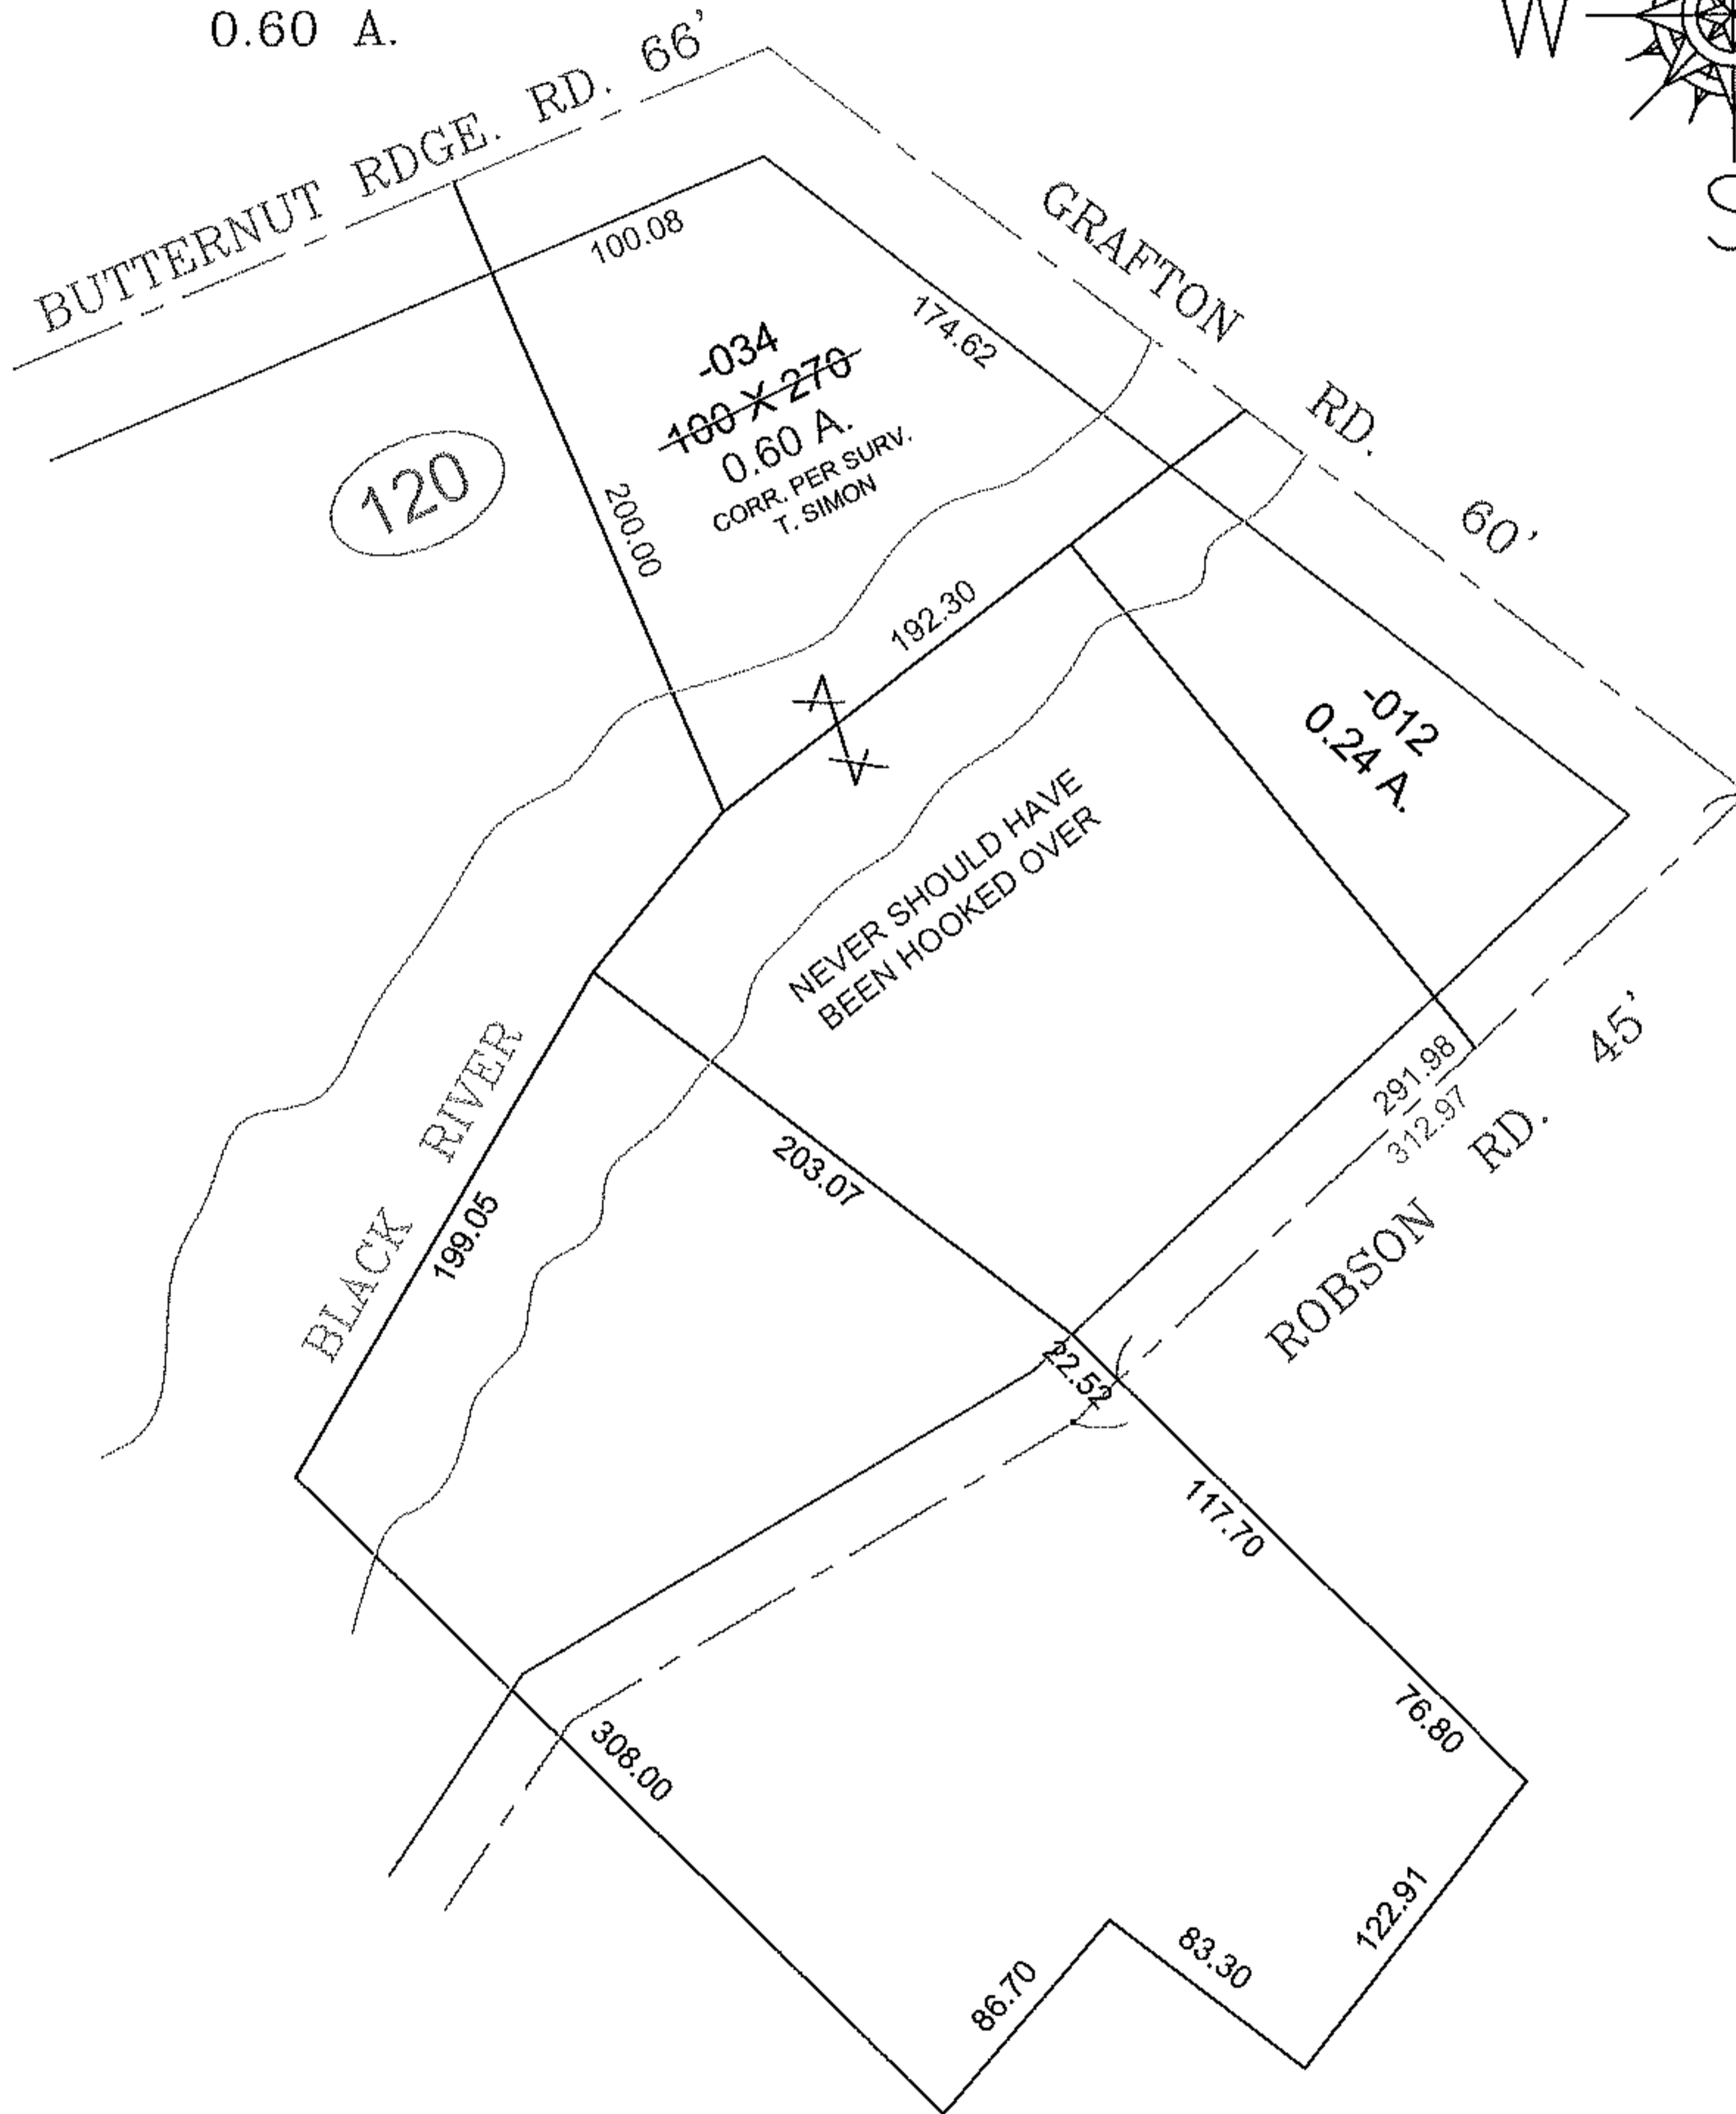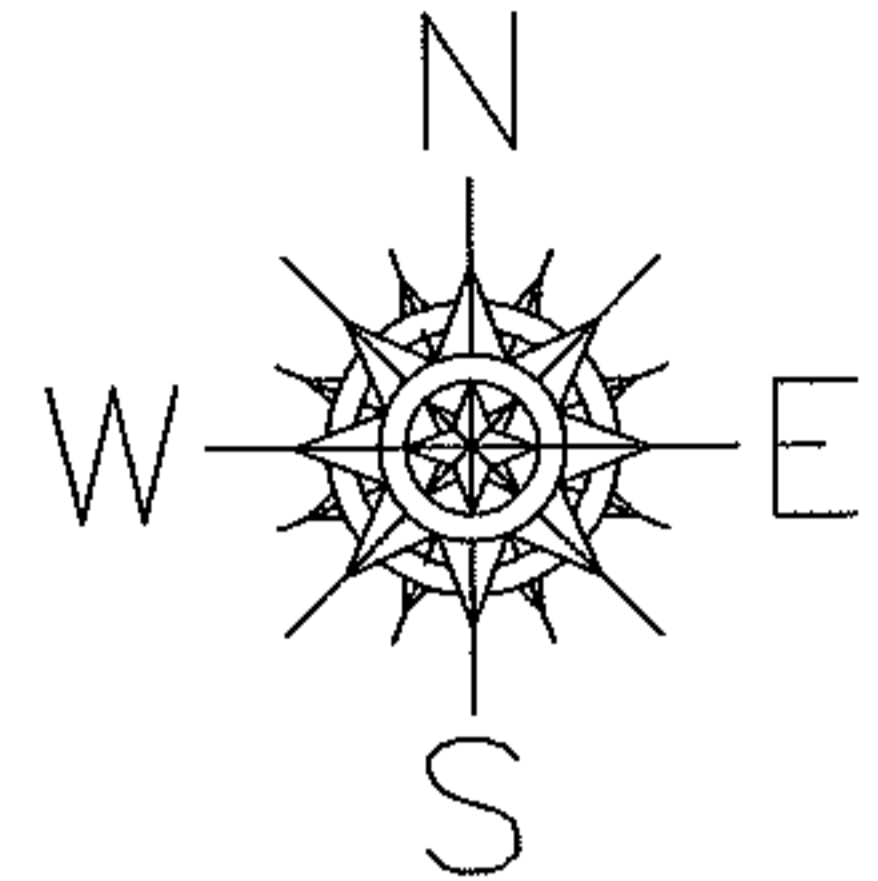

SPLITS/DEEDS PROCESSED

LORAIN COUNTY TAX MAP DEPARTMENT  
226 MIDDLE AVE. ELYRIA, OHIO

SURVEYED BY: THOMAS A. SIMON

CLOSURE: 0.01 : 10.000

MAP PAGE(S): 10-00-006-G

APPROVED BY: TJS DATE: 4/19/12

SCALE: 1" = 100 PRIOR INSTRUMENT: OR 958/813