


PARENT PARCEL: 19-02-006-000-005

CHILD PARCEL: _____

12-02492-D

STARTING POINT: SOUTHWEST CORNER OF TR.2 O.L.6

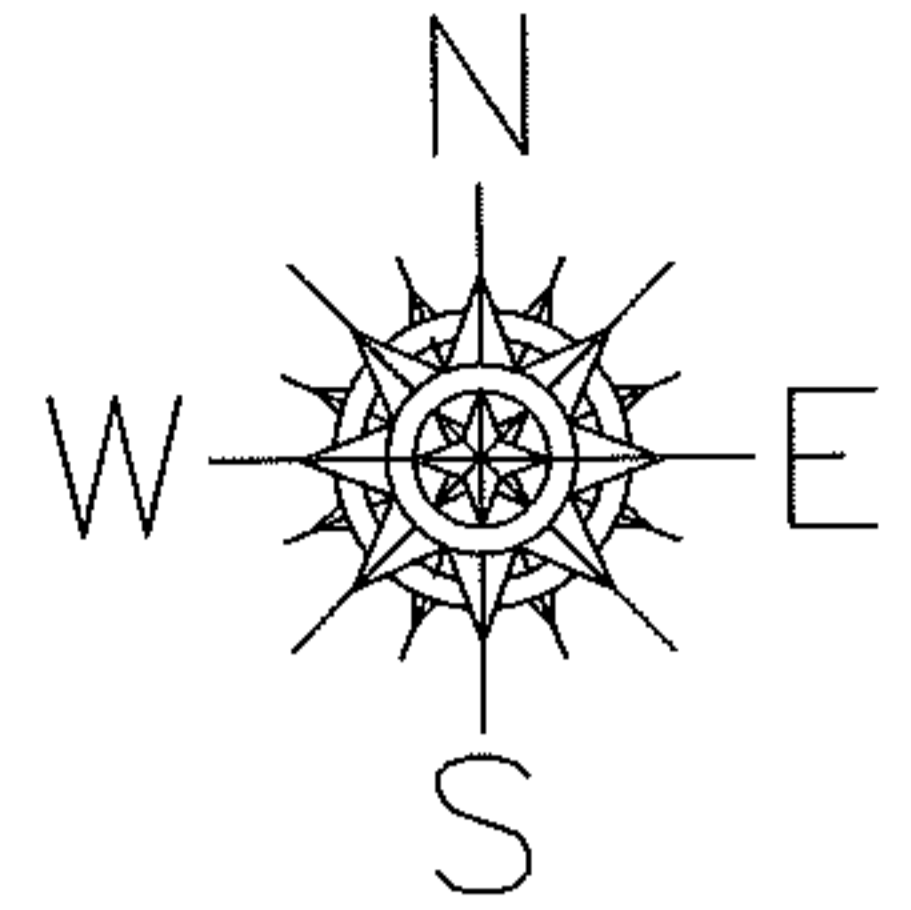

JONES RD.
1169.56

2538.35

-005
~~69.29 A.~~
68.30 A.

AC.CORR.PER SURV.
T.SIMON

2544.16

TR.2
O.L.7

TR.2
O.L.6

TR.2
O.L.6

TR.2
O.L.5


TR.1
O.L.7

TR.1
O.L.6

TR.1
O.L.6

TR.1
O.L.5

1172.10

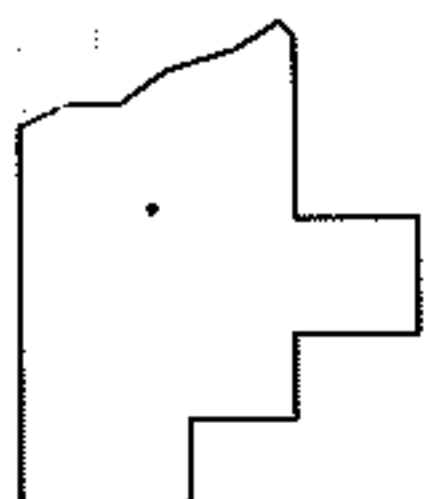

SPLITS/DEEDS PROCESSED

LORAIN COUNTY TAX MAP DEPARTMENT
226 MIDDLE AVE. ELYRIA, OHIO

SURVEYED BY: THOMAS A.SIMON

CLOSURE: .01:10,000

MAP PAGE(S): 19-E

APPROVED BY: RRM DATE: 4-23-12

SCALE: 1"= 400 PRIOR INST.: 20110382233