
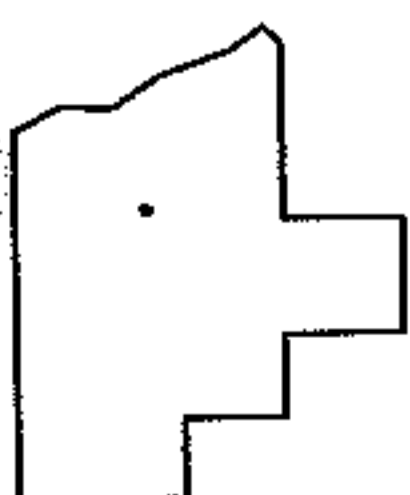
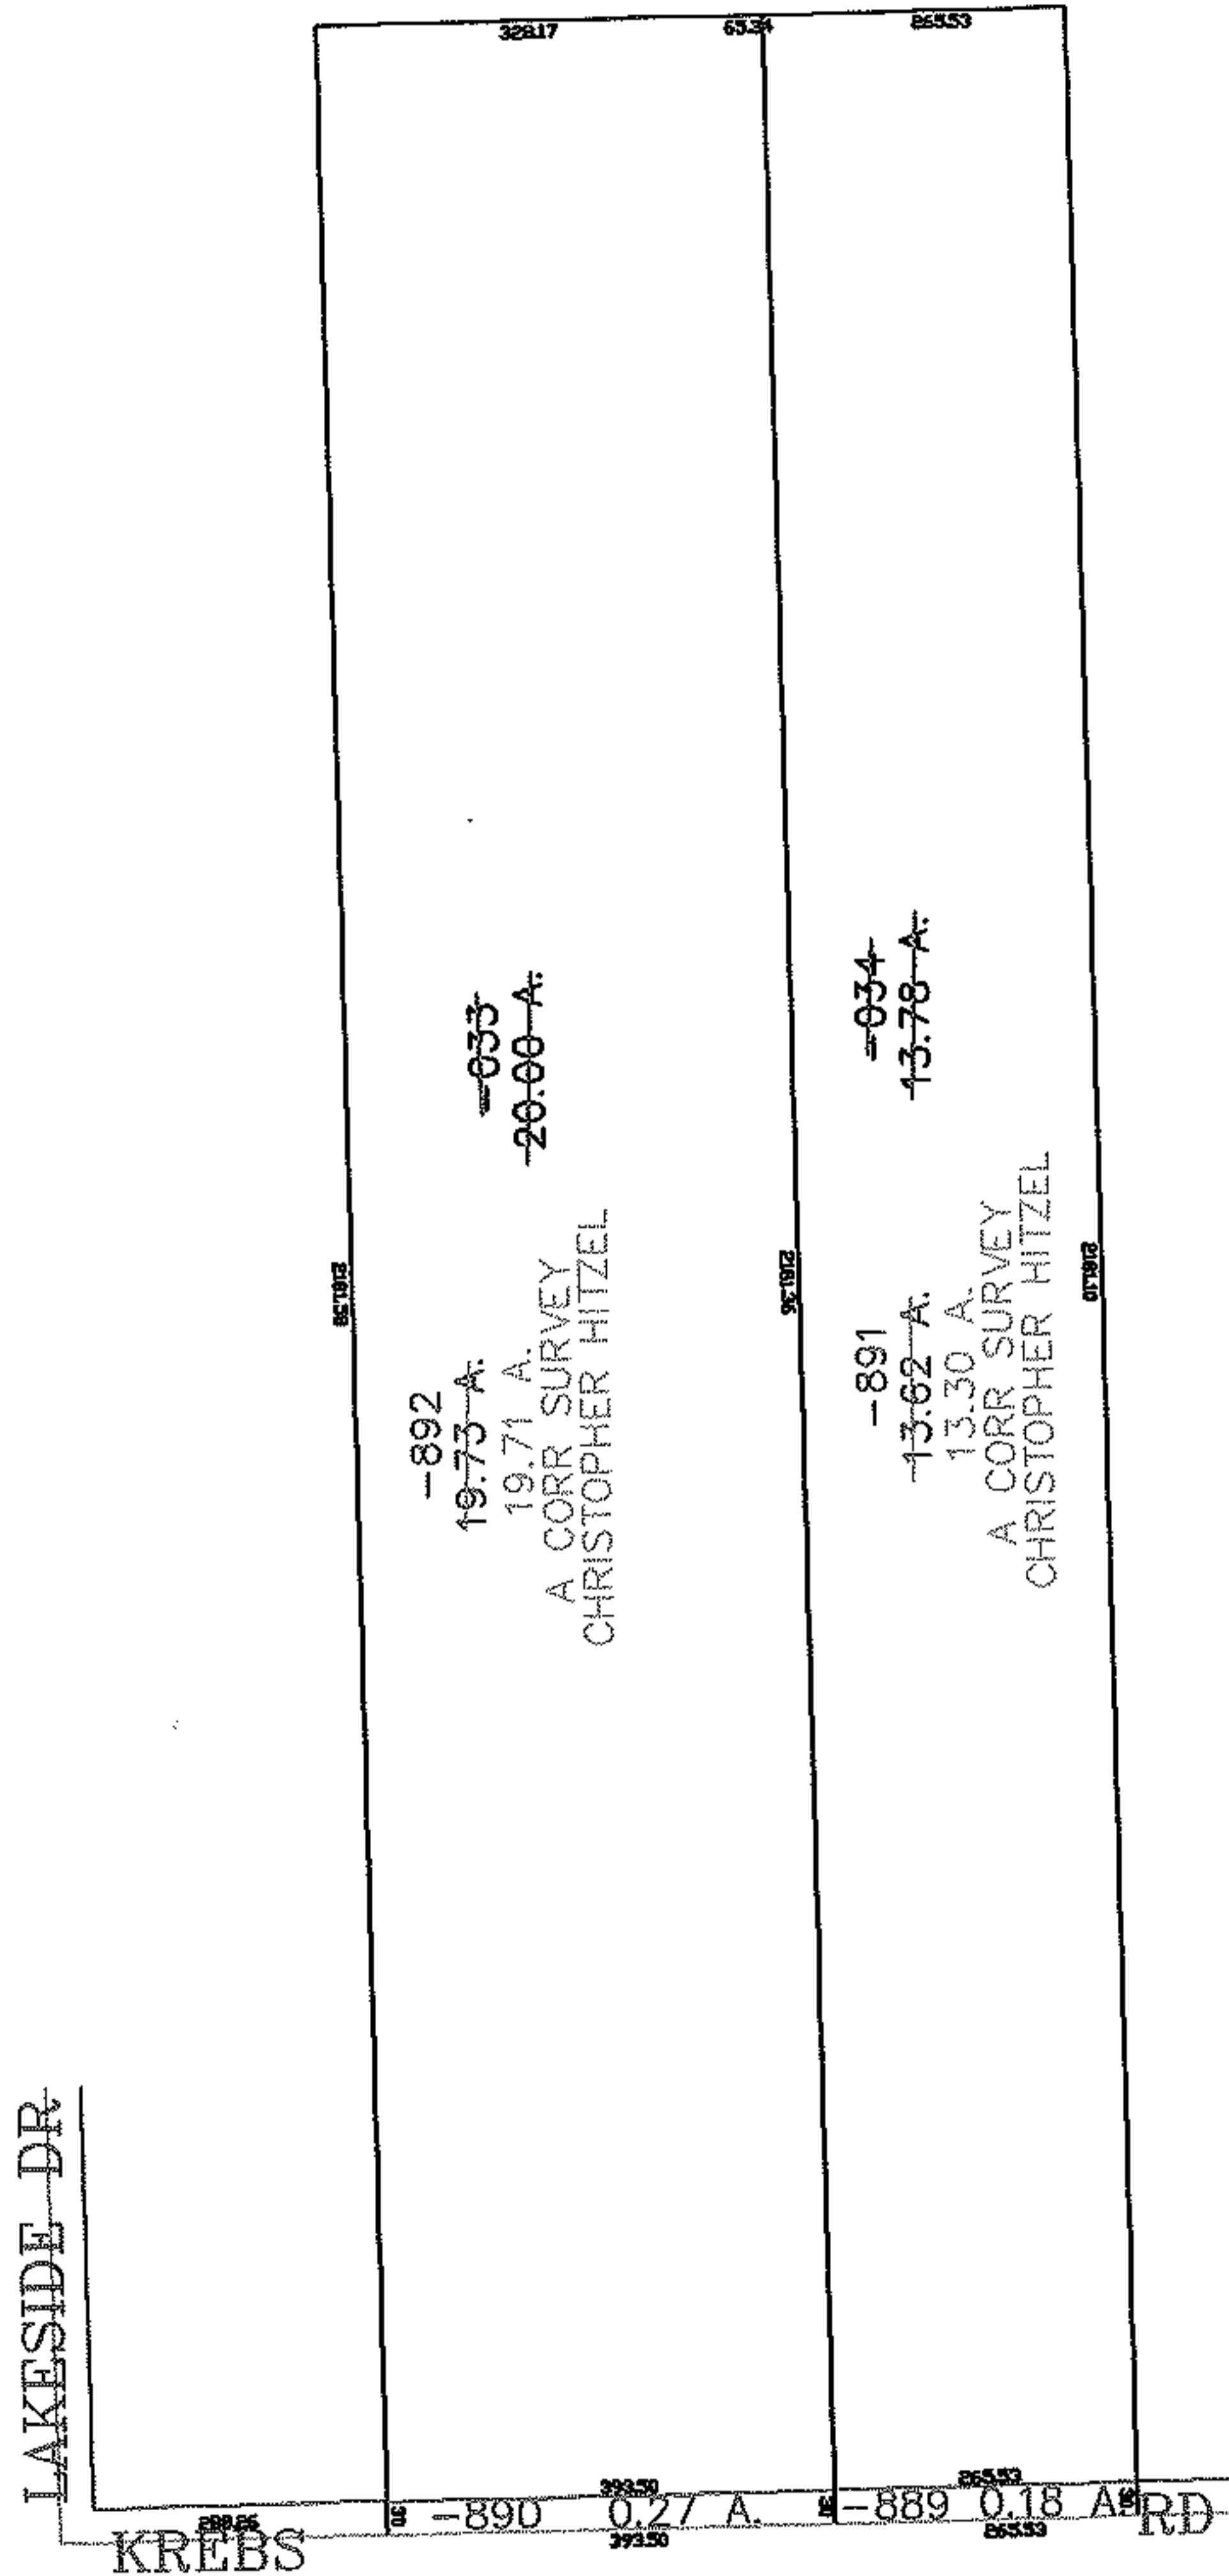


PARENT PARCEL: 04-00-029-000-033, -034
CHILD PARCEL: 04-00-029-000-889 THRU -892
STARTING POINT: CENTERLINE OF KREBS RD & LAKESIDE DR

07-02496

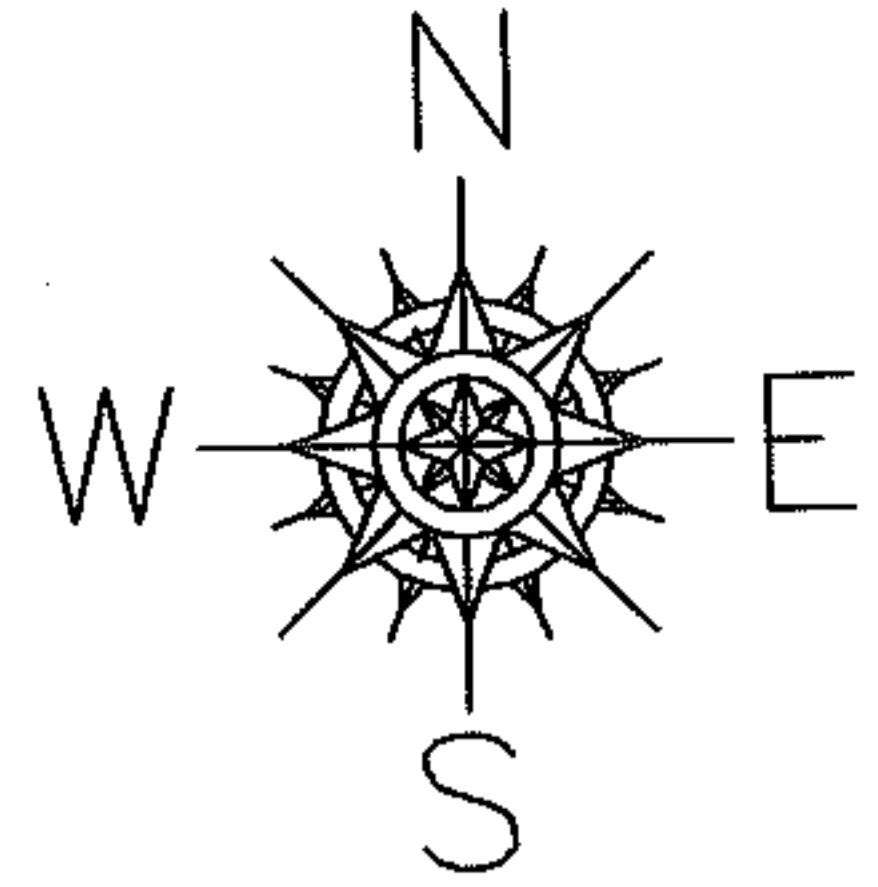

SPLITS/DEEDS PROCESSED
LORAIN COUNTY TAX MAP DEPARTMENT
226 MIDDLE AVE. ELYRIA, OHIO

SURVEYED BY: CHRISTOPHER HIRZEL
CLOSURE: 0.00 : 10.000
MAP PAGE(S): 04-00-029-B
APPROVED BY: JAH DATE: 11-15-07
SCALE: 1" = 300 PRIOR INSTRUMENT: DV 1316/349