


RASTER

PARENT PARCEL: 05-00-099-000-076, -072

CHILD PARCEL: 05-00-099-000-205

STARTING POINT: CENTERLINE OF COOPER FOSTER PARK RD & QUARRY RD

07-02497

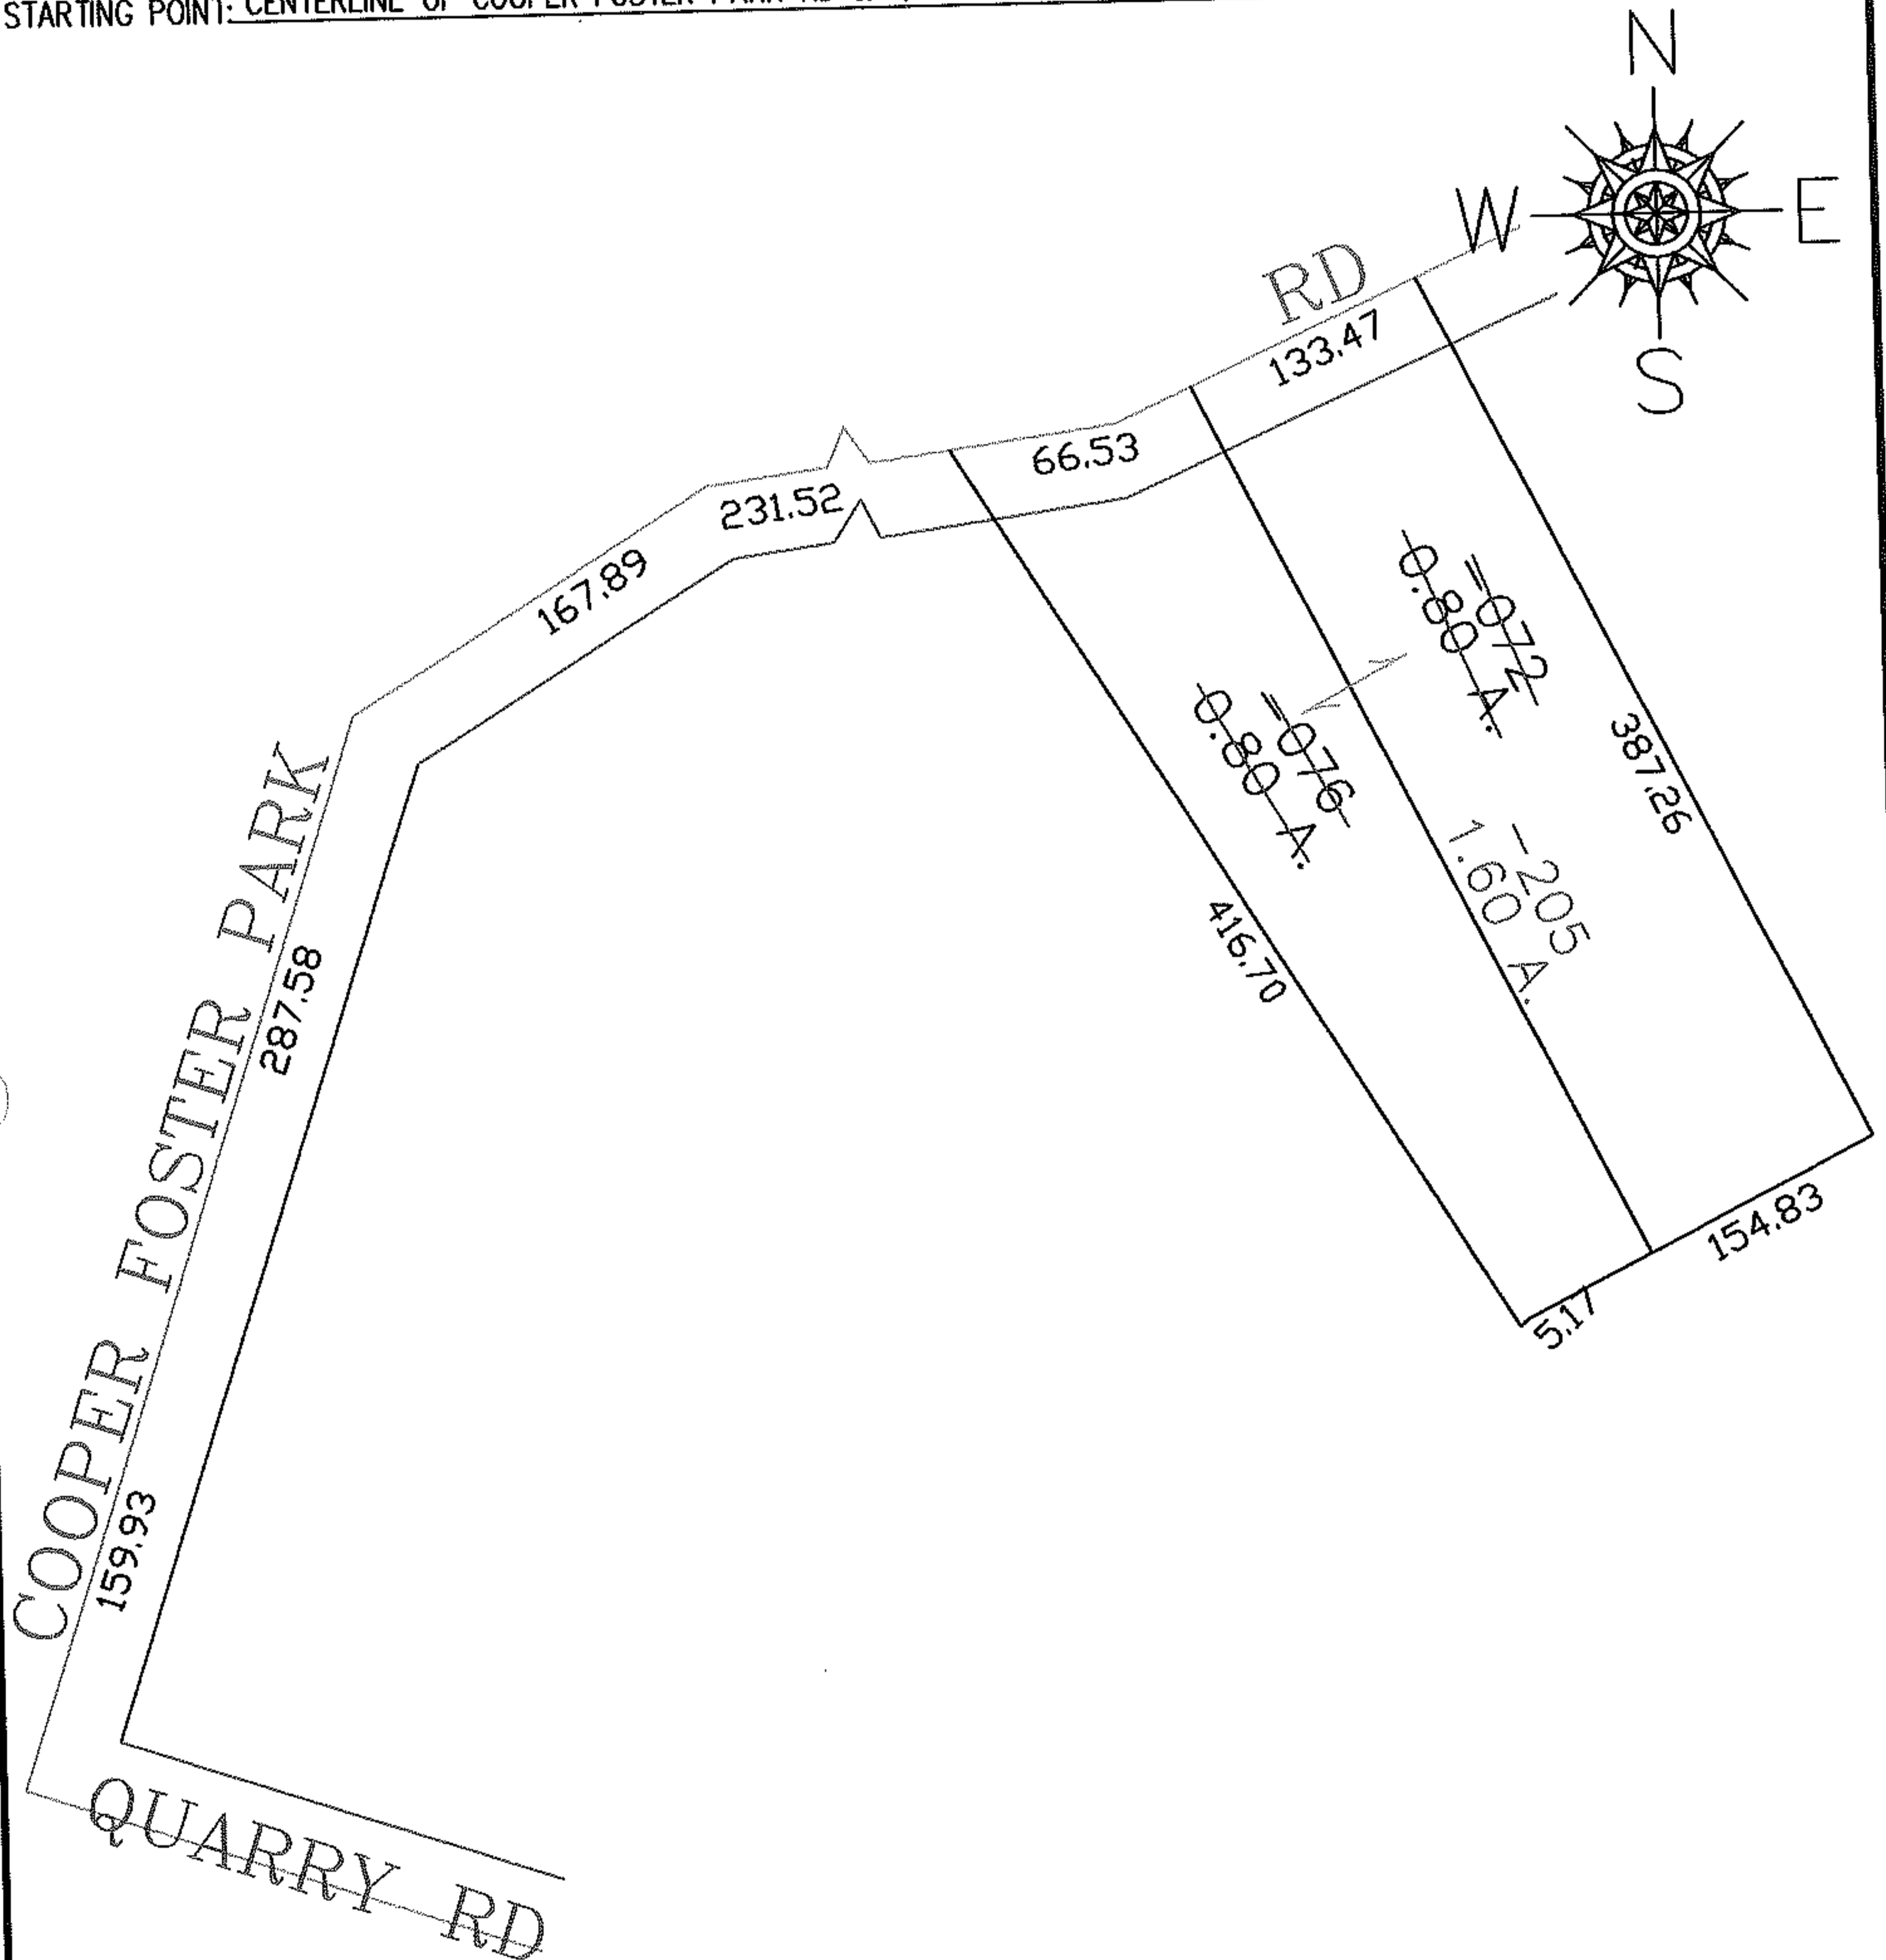

SPLITS/DEEDS PROCESSED

LORAIN COUNTY TAX MAP DEPARTMENT  
226 MIDDLE AVE. ELYRIA, OHIO

SURVEYED BY: THOMAS SIMON

CLOSURE: 0.00 : 10.000

MAP PAGE(S): 05-00-099-C

APPROVED BY: JAH DATE: 11-26-07

SCALE: 1" = 100 PRIOR INSTRUMENT: OR 371/793