
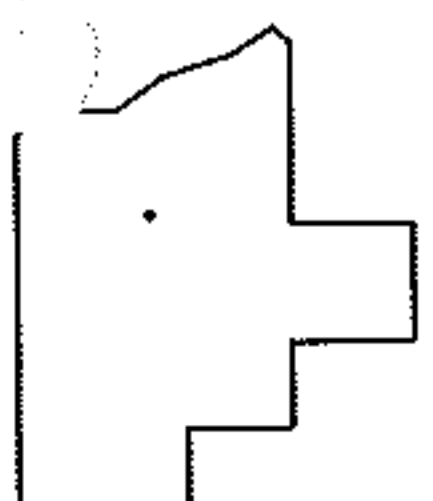
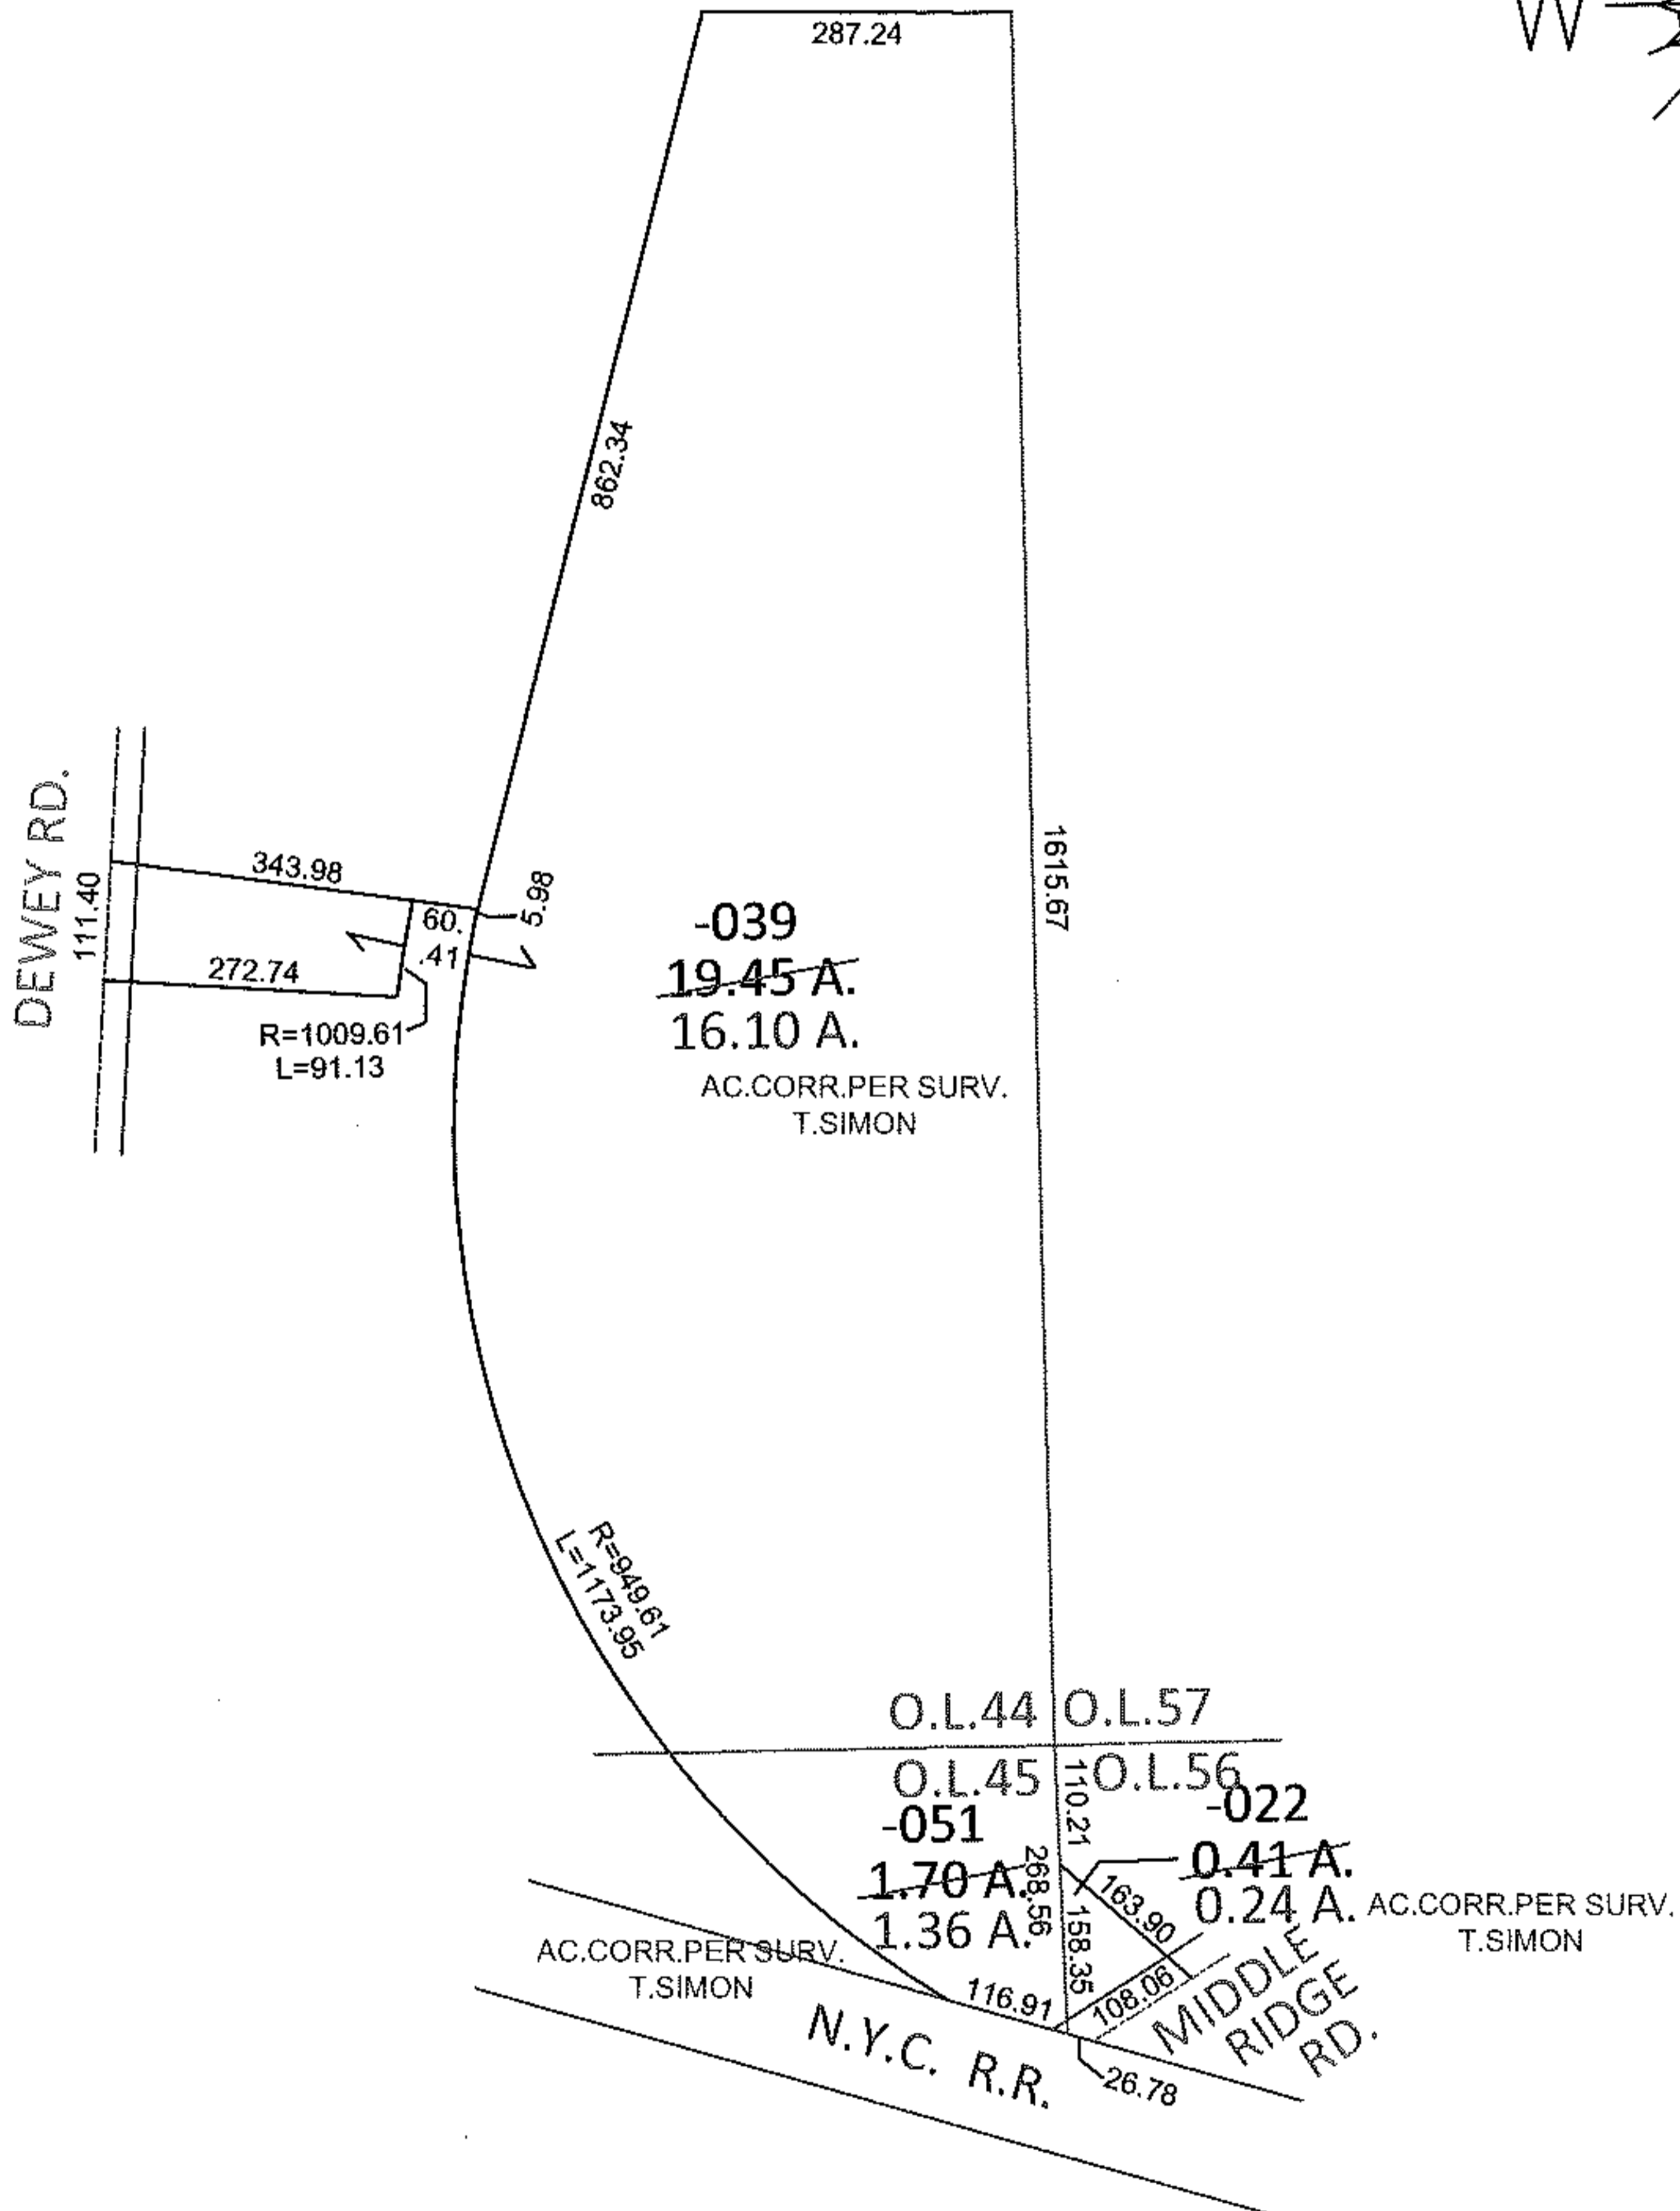


PARENT PARCEL: 05-00-044-000-039, 05-00-045-000-051, 05-00-056-000-022

12-02498-A

CHILD PARCEL: _____

STARTING POINT: SOUTHEAST CORNER OF O.L. 44

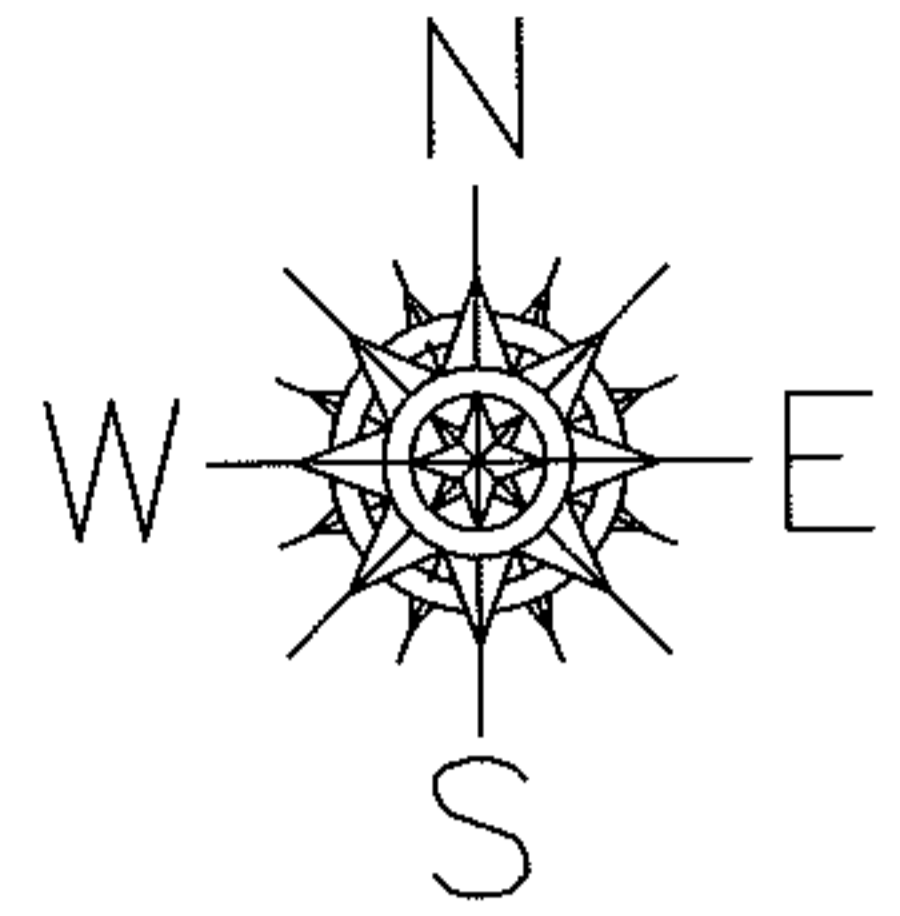

SPLITS/DEEDS PROCESSED

LORAIN COUNTY TAX MAP DEPARTMENT
226 MIDDLE AVE. ELYRIA, OHIO

SURVEYED BY: THOMAS A. SIMON

CLOSURE: .01:10,000

MAP PAGE(S): 5-00-044-B, 5-00-045-B, 5-00-056-A

APPROVED BY: RRM DATE: 4-24-12

SCALE: 1"= 300 PRIOR INST.: 20120397758