
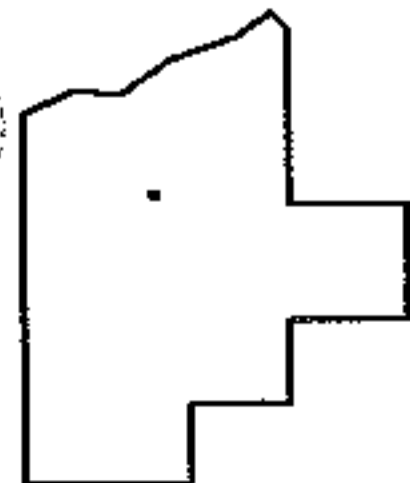
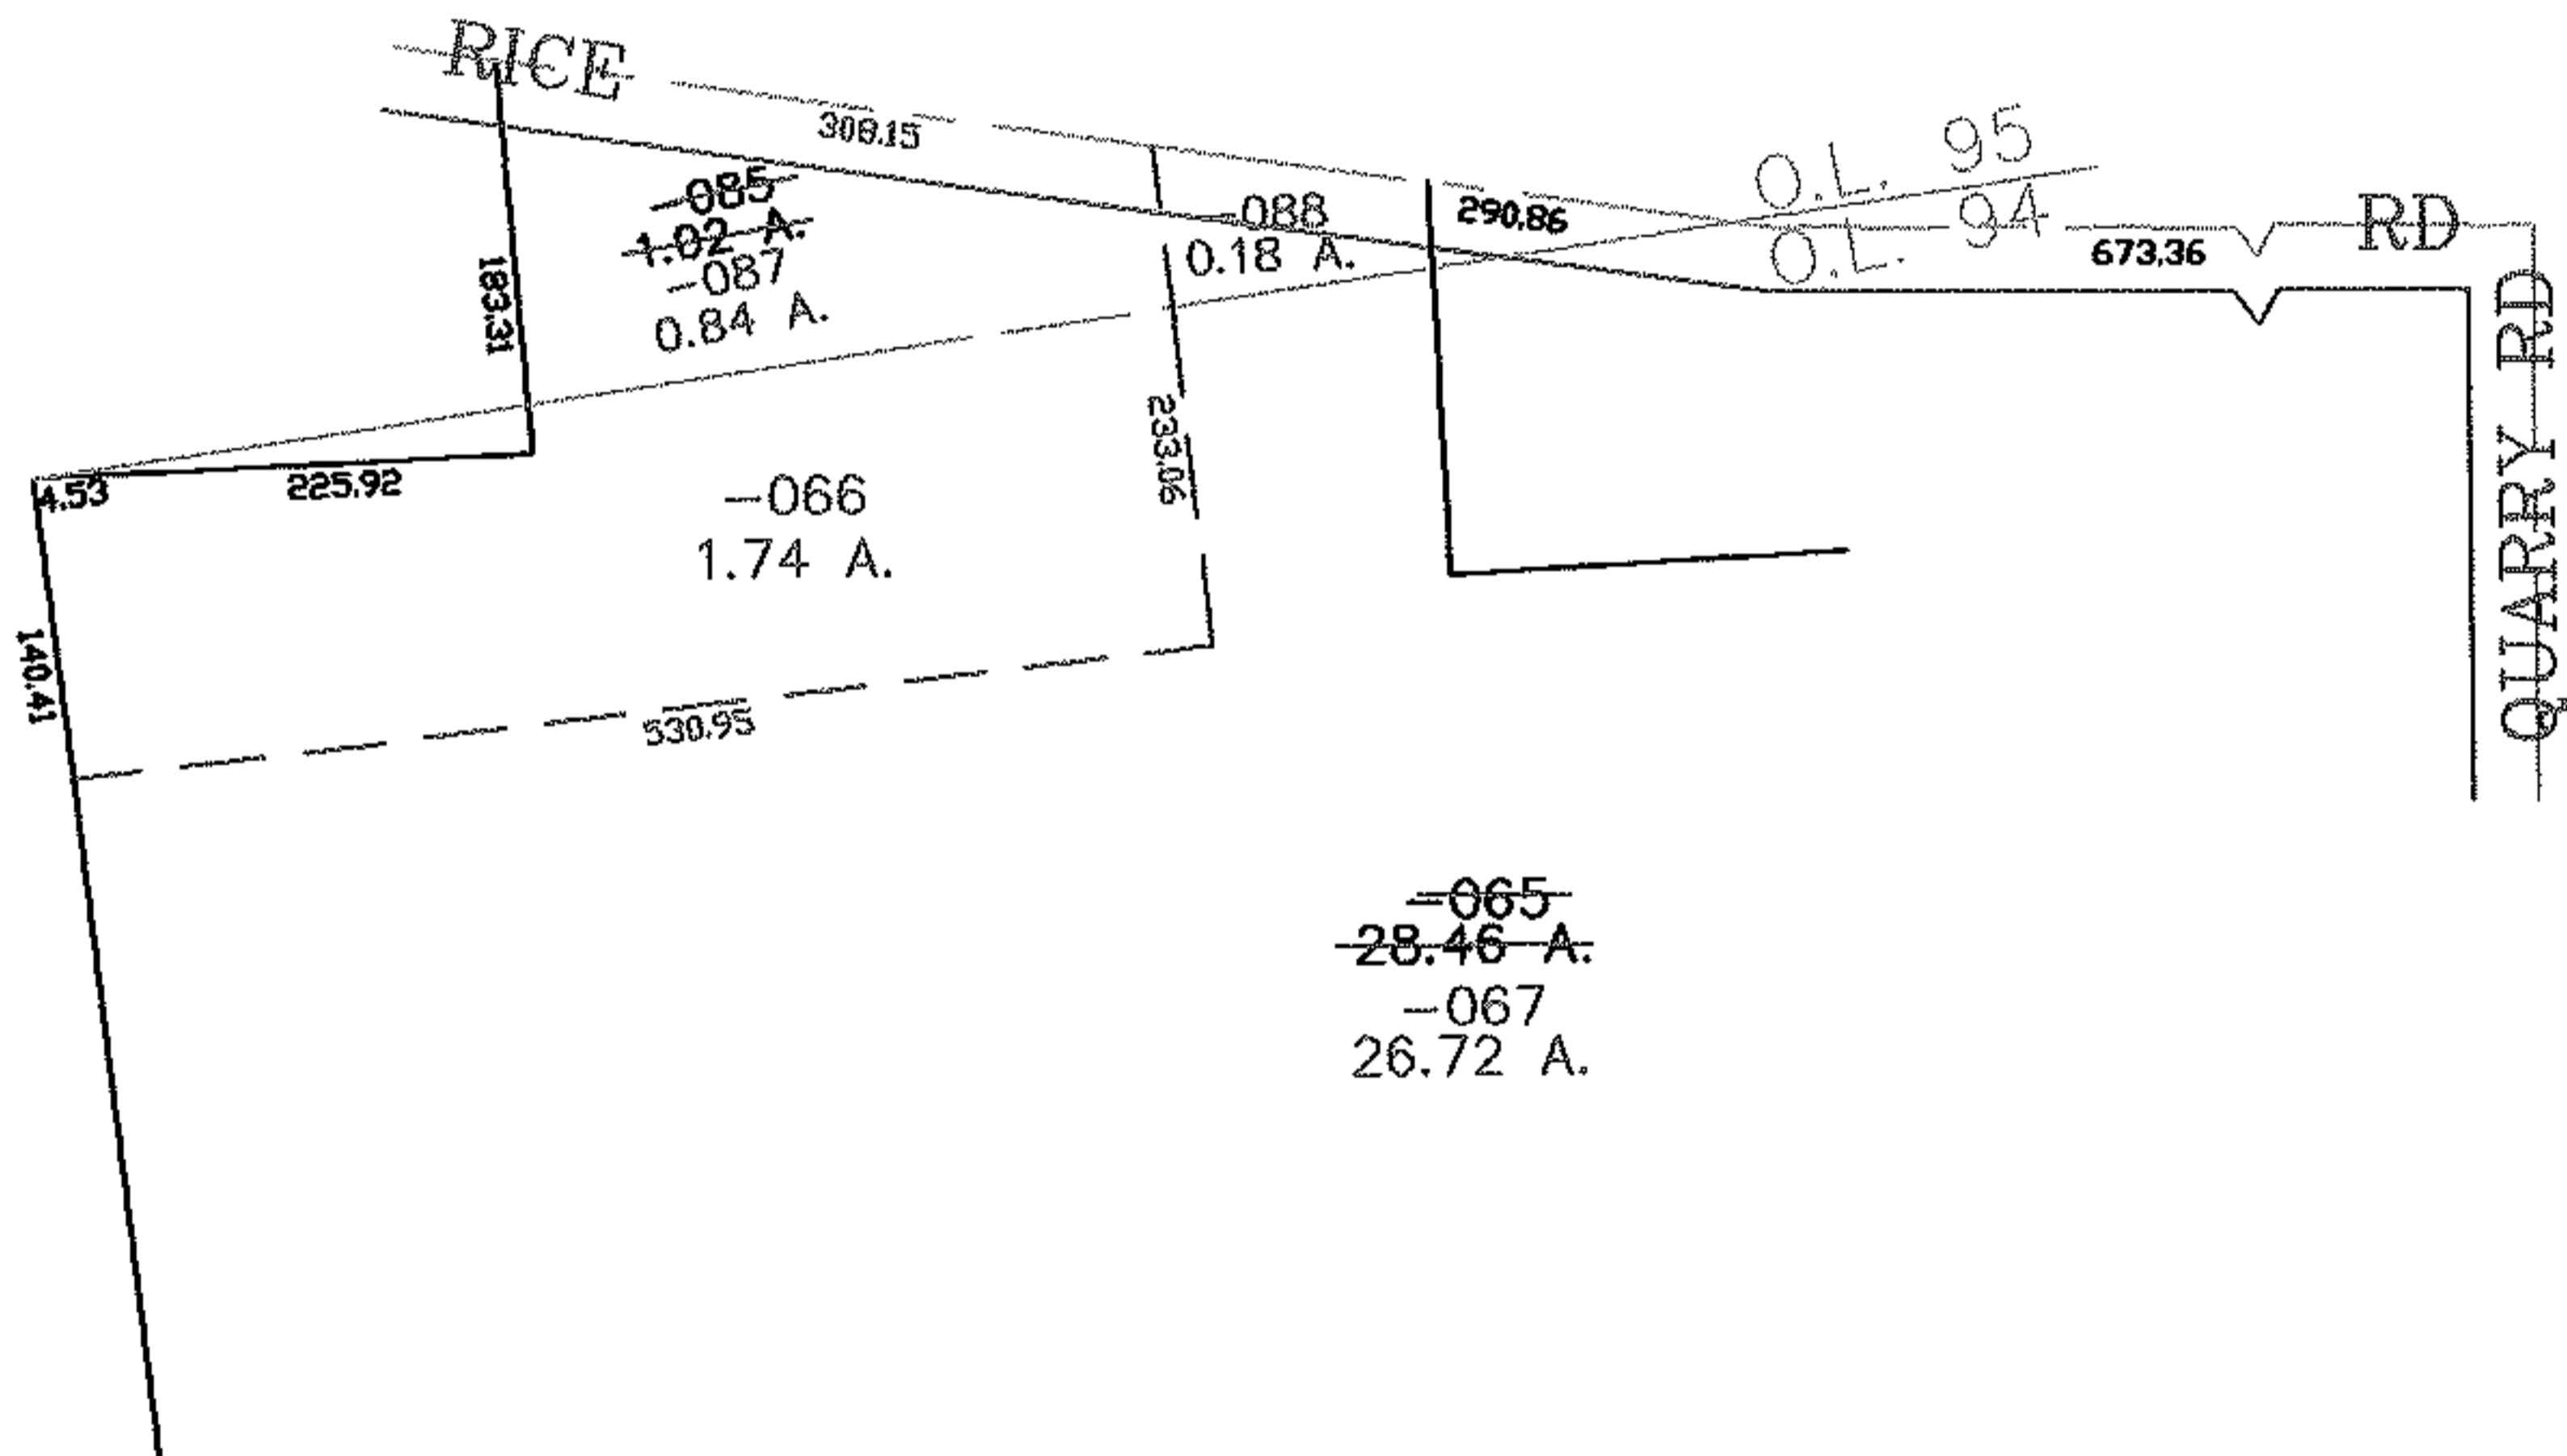


RASTER

PARENT PARCEL: 05-00-095-000-085, 05-00-094-103-065
CHILD PARCEL: 05-00-095-000-087, -088 05-00-094-103-066, -067
STARTING POINT: CENTERLINE OF QUARRY RD & RICE RD

07-02498

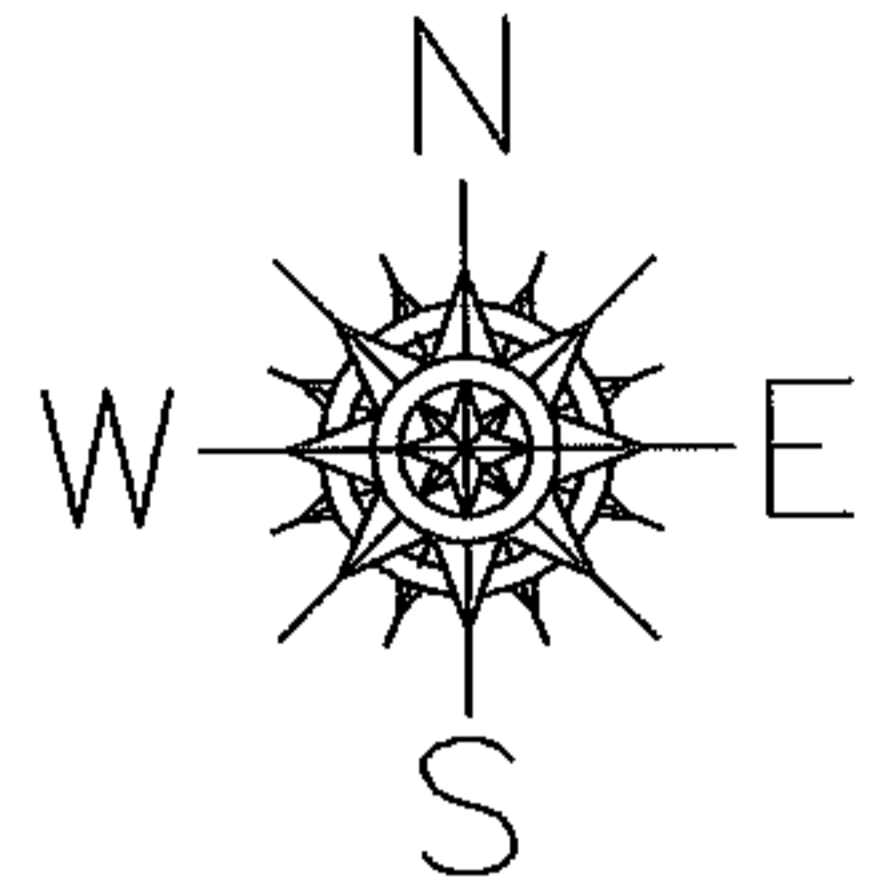

SPLITS/DEEDS PROCESSED

LORAIN COUNTY TAX MAP DEPARTMENT
226 MIDDLE AVE. ELYRIA, OHIO

SURVEYED BY: THOMAS SIMON
CLOSURE: 0.00 : 10.000
MAP PAGE(S): 05-00-095-A 05-00-094-B
APPROVED BY: JAH DATE: 11-26-07
SCALE: 1" = 200 PRIOR INSTRUMENT: 20040048354