
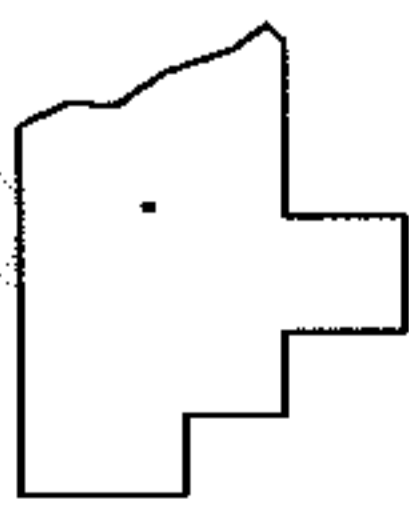
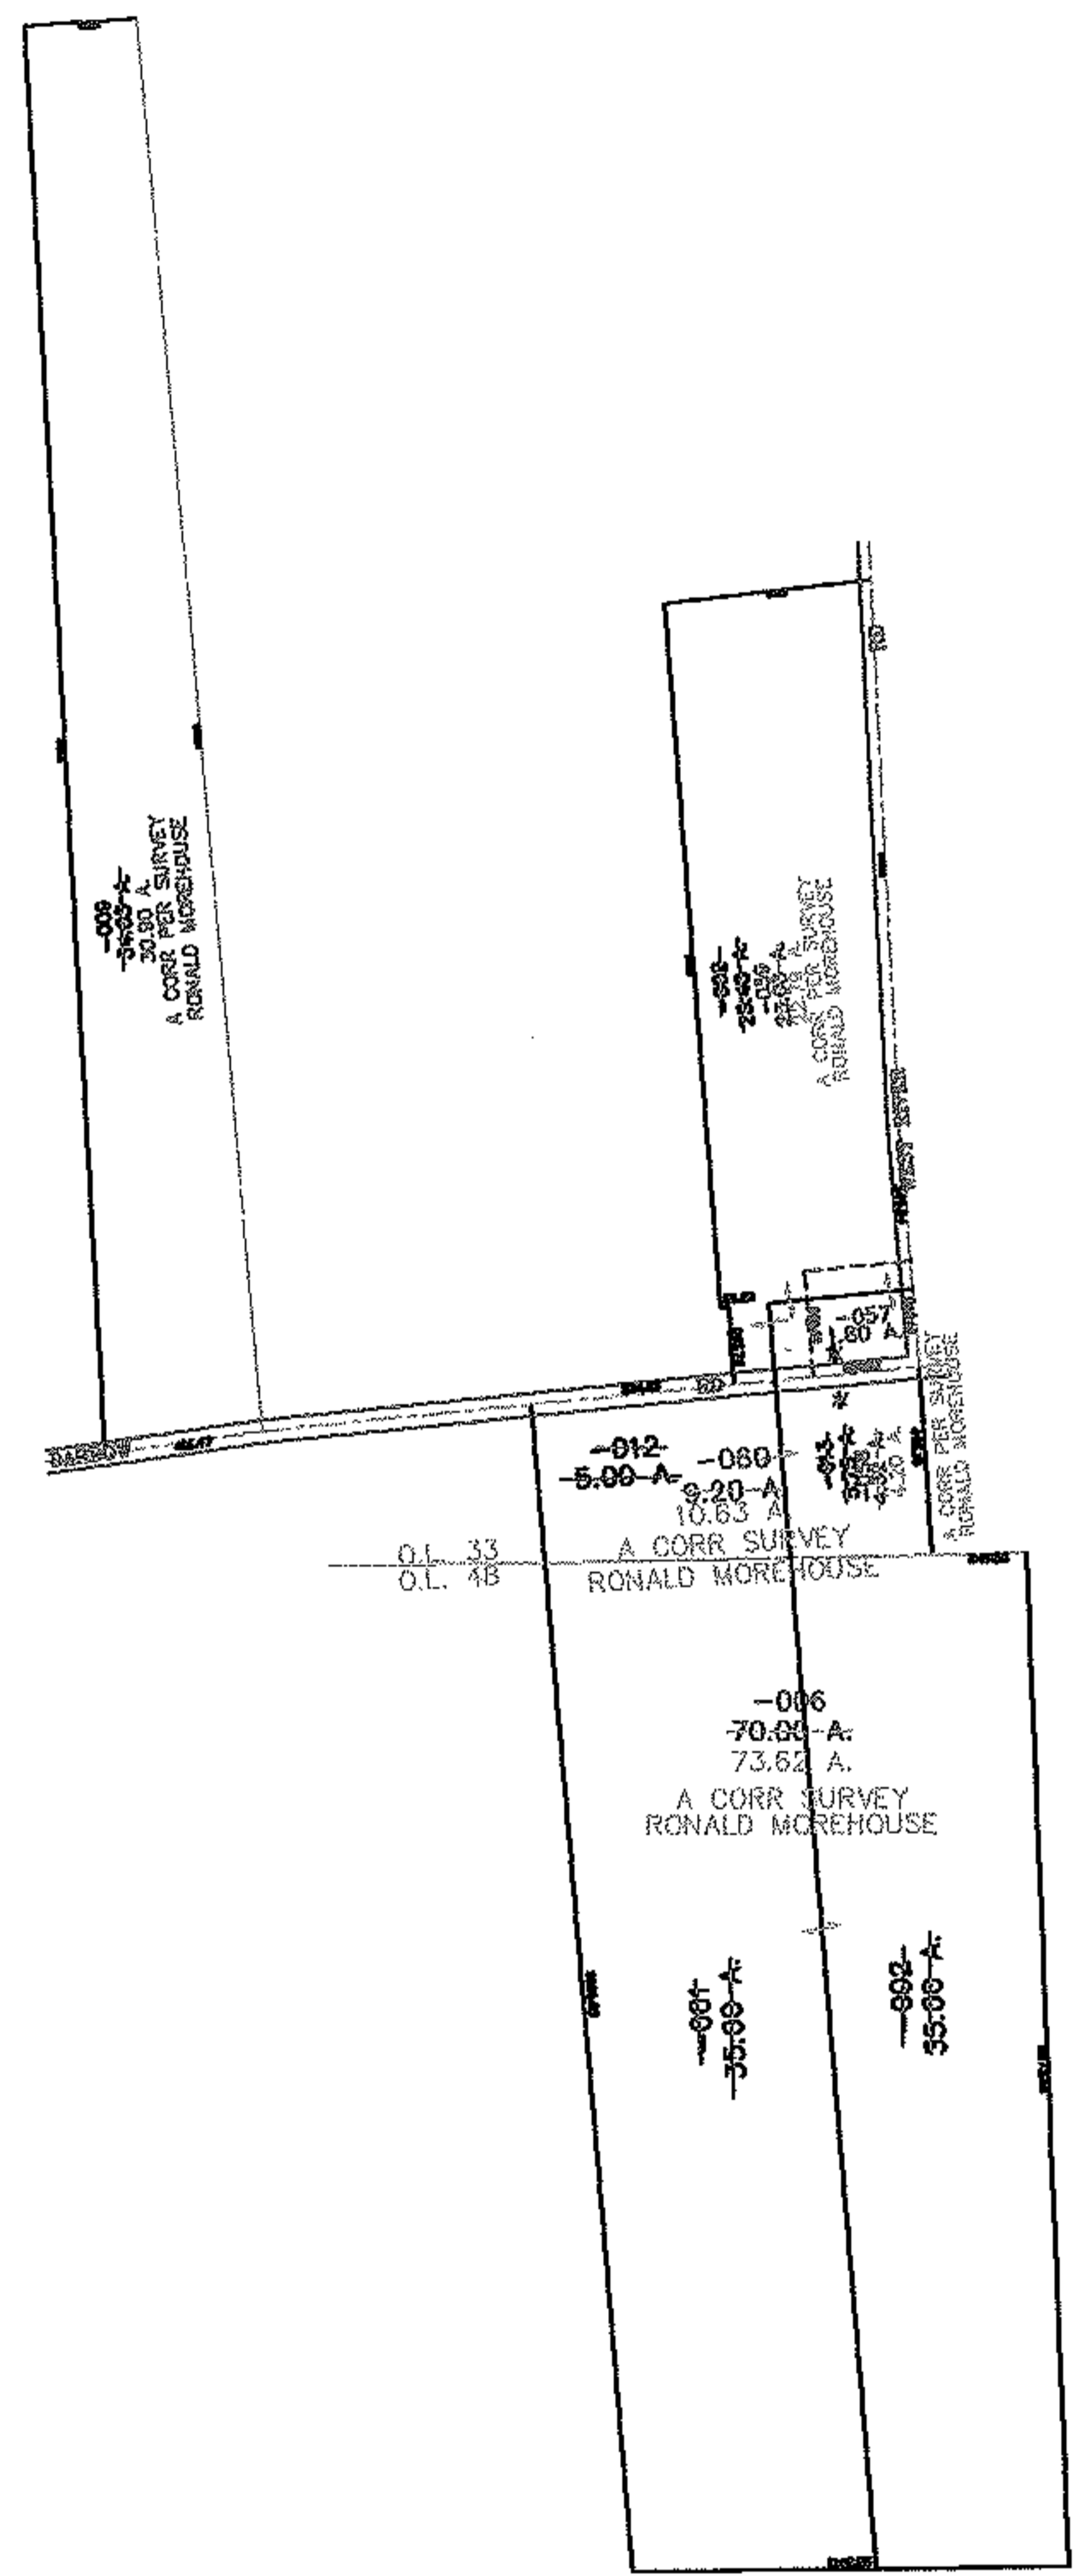


PARENT PARCEL: 01-00-033-000-013, -002, -012, 01-00-048-000-001, -002

07-02500

CHILD PARCEL: 01-00-033-000-057 THRU -060 01-00-048-000-006

STARTING POINT: INTERSECTION OF THE CENTERLINES OF DARROW RD & WEST RIVER RD

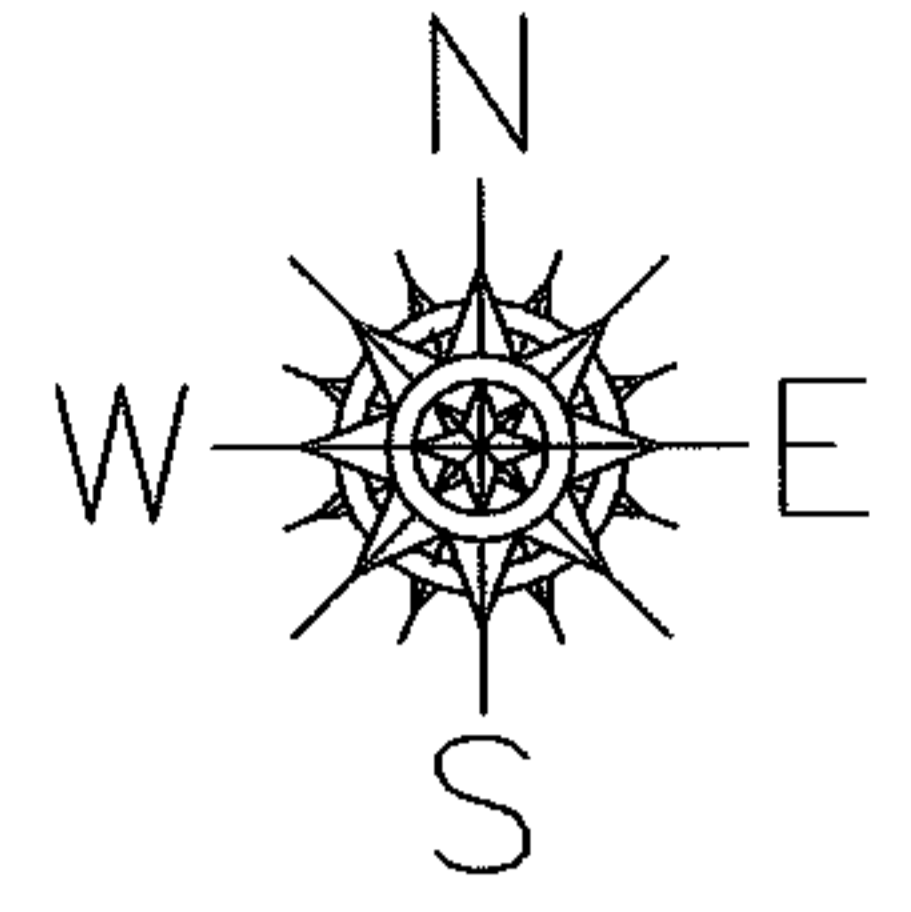

SPLITS/DEEDS PROCESSED

LORAIN COUNTY TAX MAP DEPARTMENT
226 MIDDLE AVE. ELYRIA, OHIO

SURVEYED BY: RONALD MOREHOUSE
CLOSURE: 0.00 : 10.000
MAP PAGE(S): 01-00-033-A
APPROVED BY: JAH DATE: 12-19-07
SCALE: 1" = 900 PRIOR INSTRUMENT: 200449852155