



PARENT PARCEL: 05-00-038-106-070 & -071

CHILD PARCEL: 05-00-038-106-098 THRU -101

STARTING POINT: N.W. CORNER OF S/L 22 & N.W. CORNER OF S/L 24 IN RICE ALLOT. NO.2

12-02501-U

UNCOMBINATION

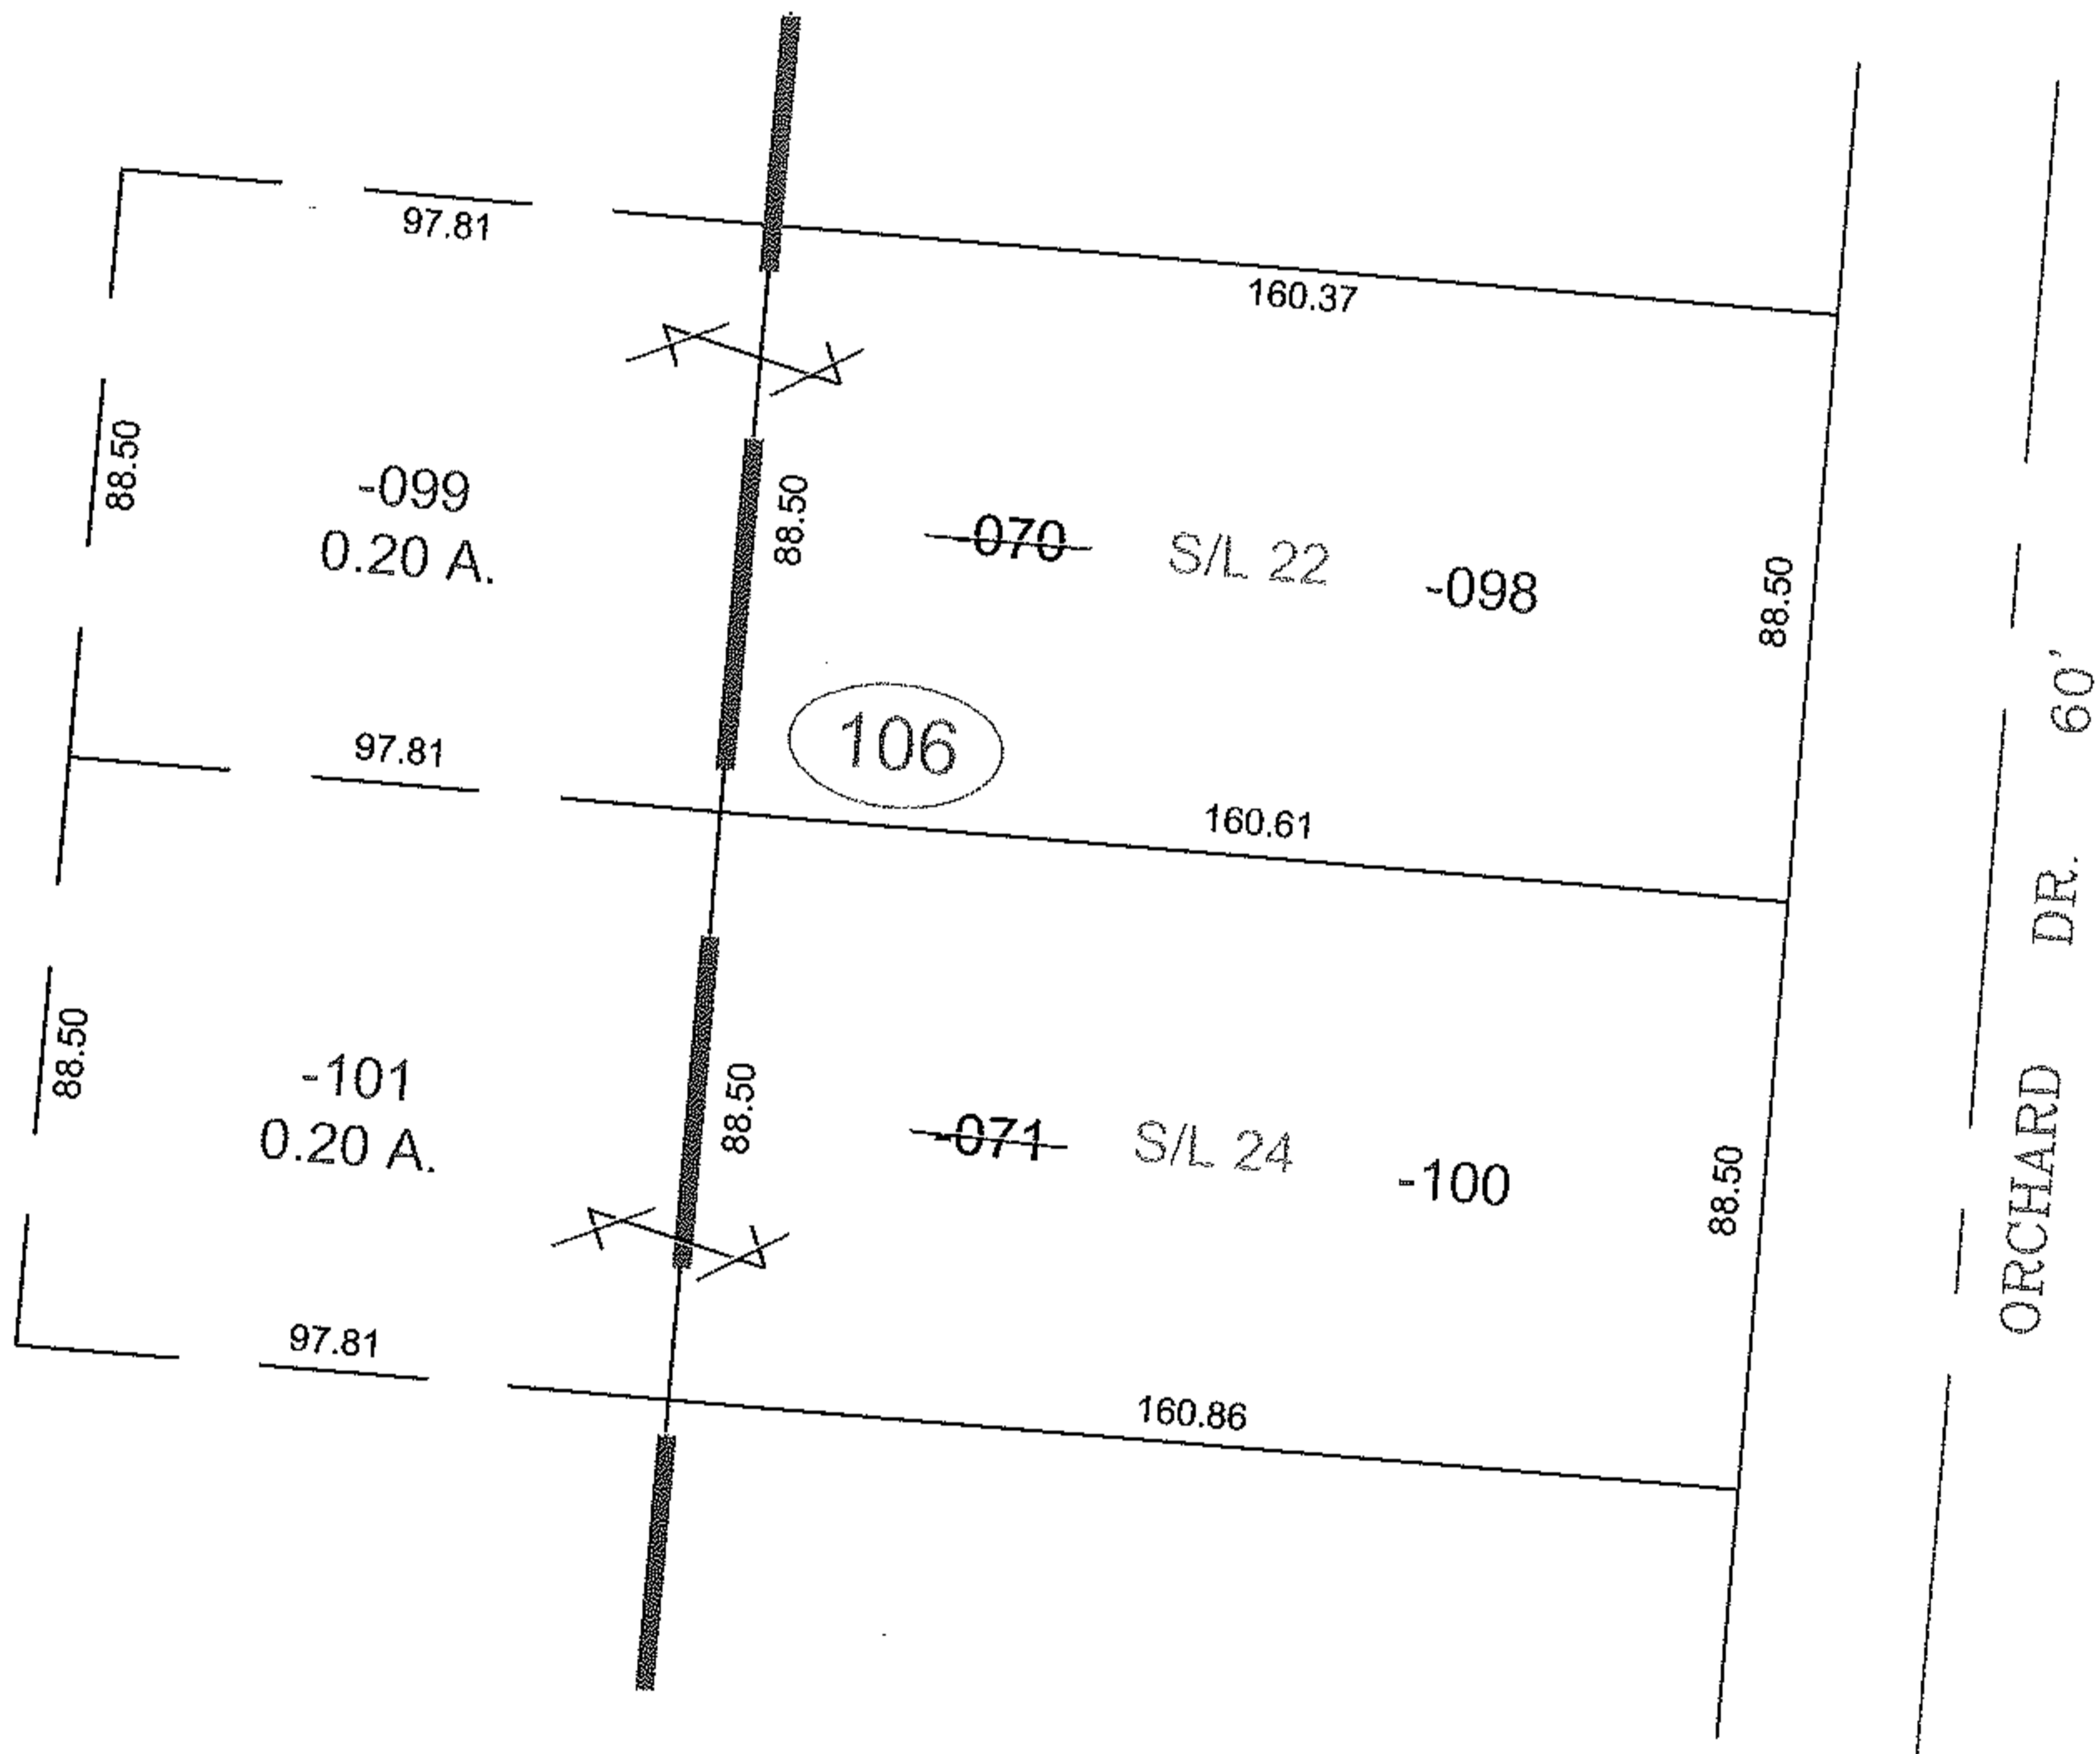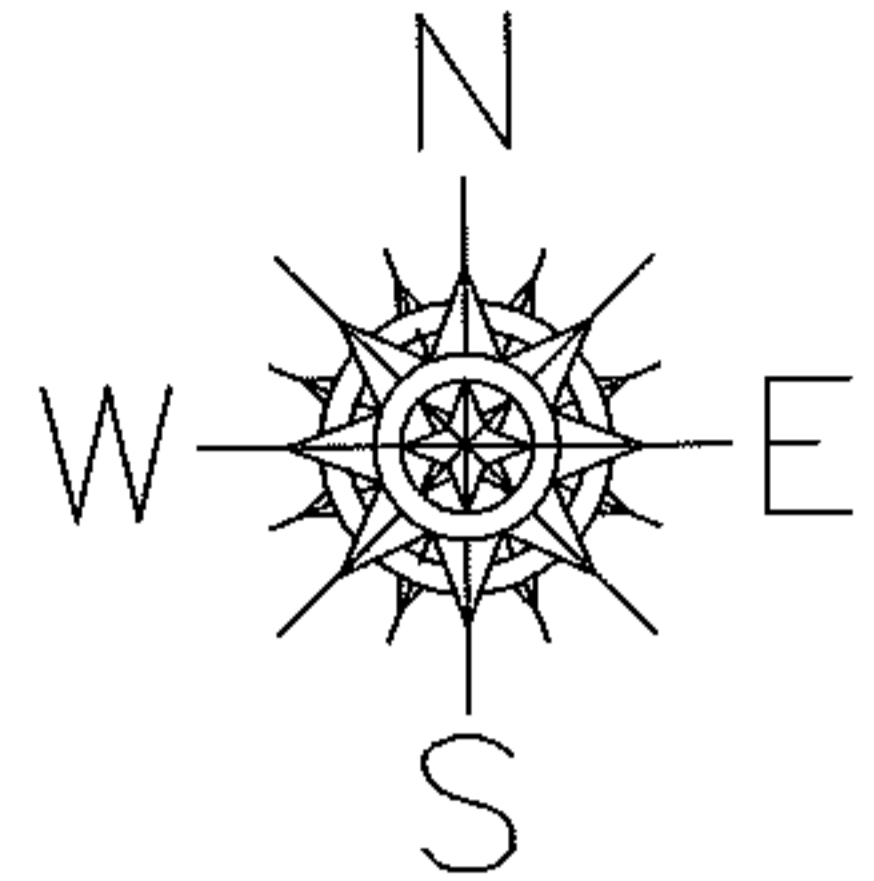

PRIOR INST.: 20100353463

PRIOR INST.: 20020820822

SPLITS/DEEDS PROCESSED

LORAIN COUNTY TAX MAP DEPARTMENT
226 MIDDLE AVE. ELYRIA, OHIO

SURVEYED BY: NA
CLOSURE: 0.00; 10,000
MAP PAGE(S): 05-00-038-B
APPROVED BY: TJS DATE: 5/7/12
SCALE: 1"= 50'