




RASTER

PARENT PARCEL: 11-00-086-000-008, -027

07-02502

CHILD PARCEL: 11-00-086-000-061

STARTING POINT: CENTERLINE OF ST RT 82 & DURKEE RD

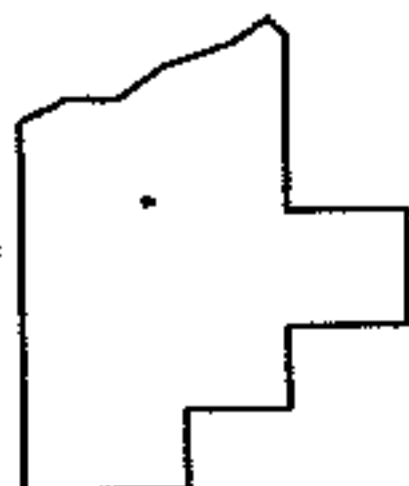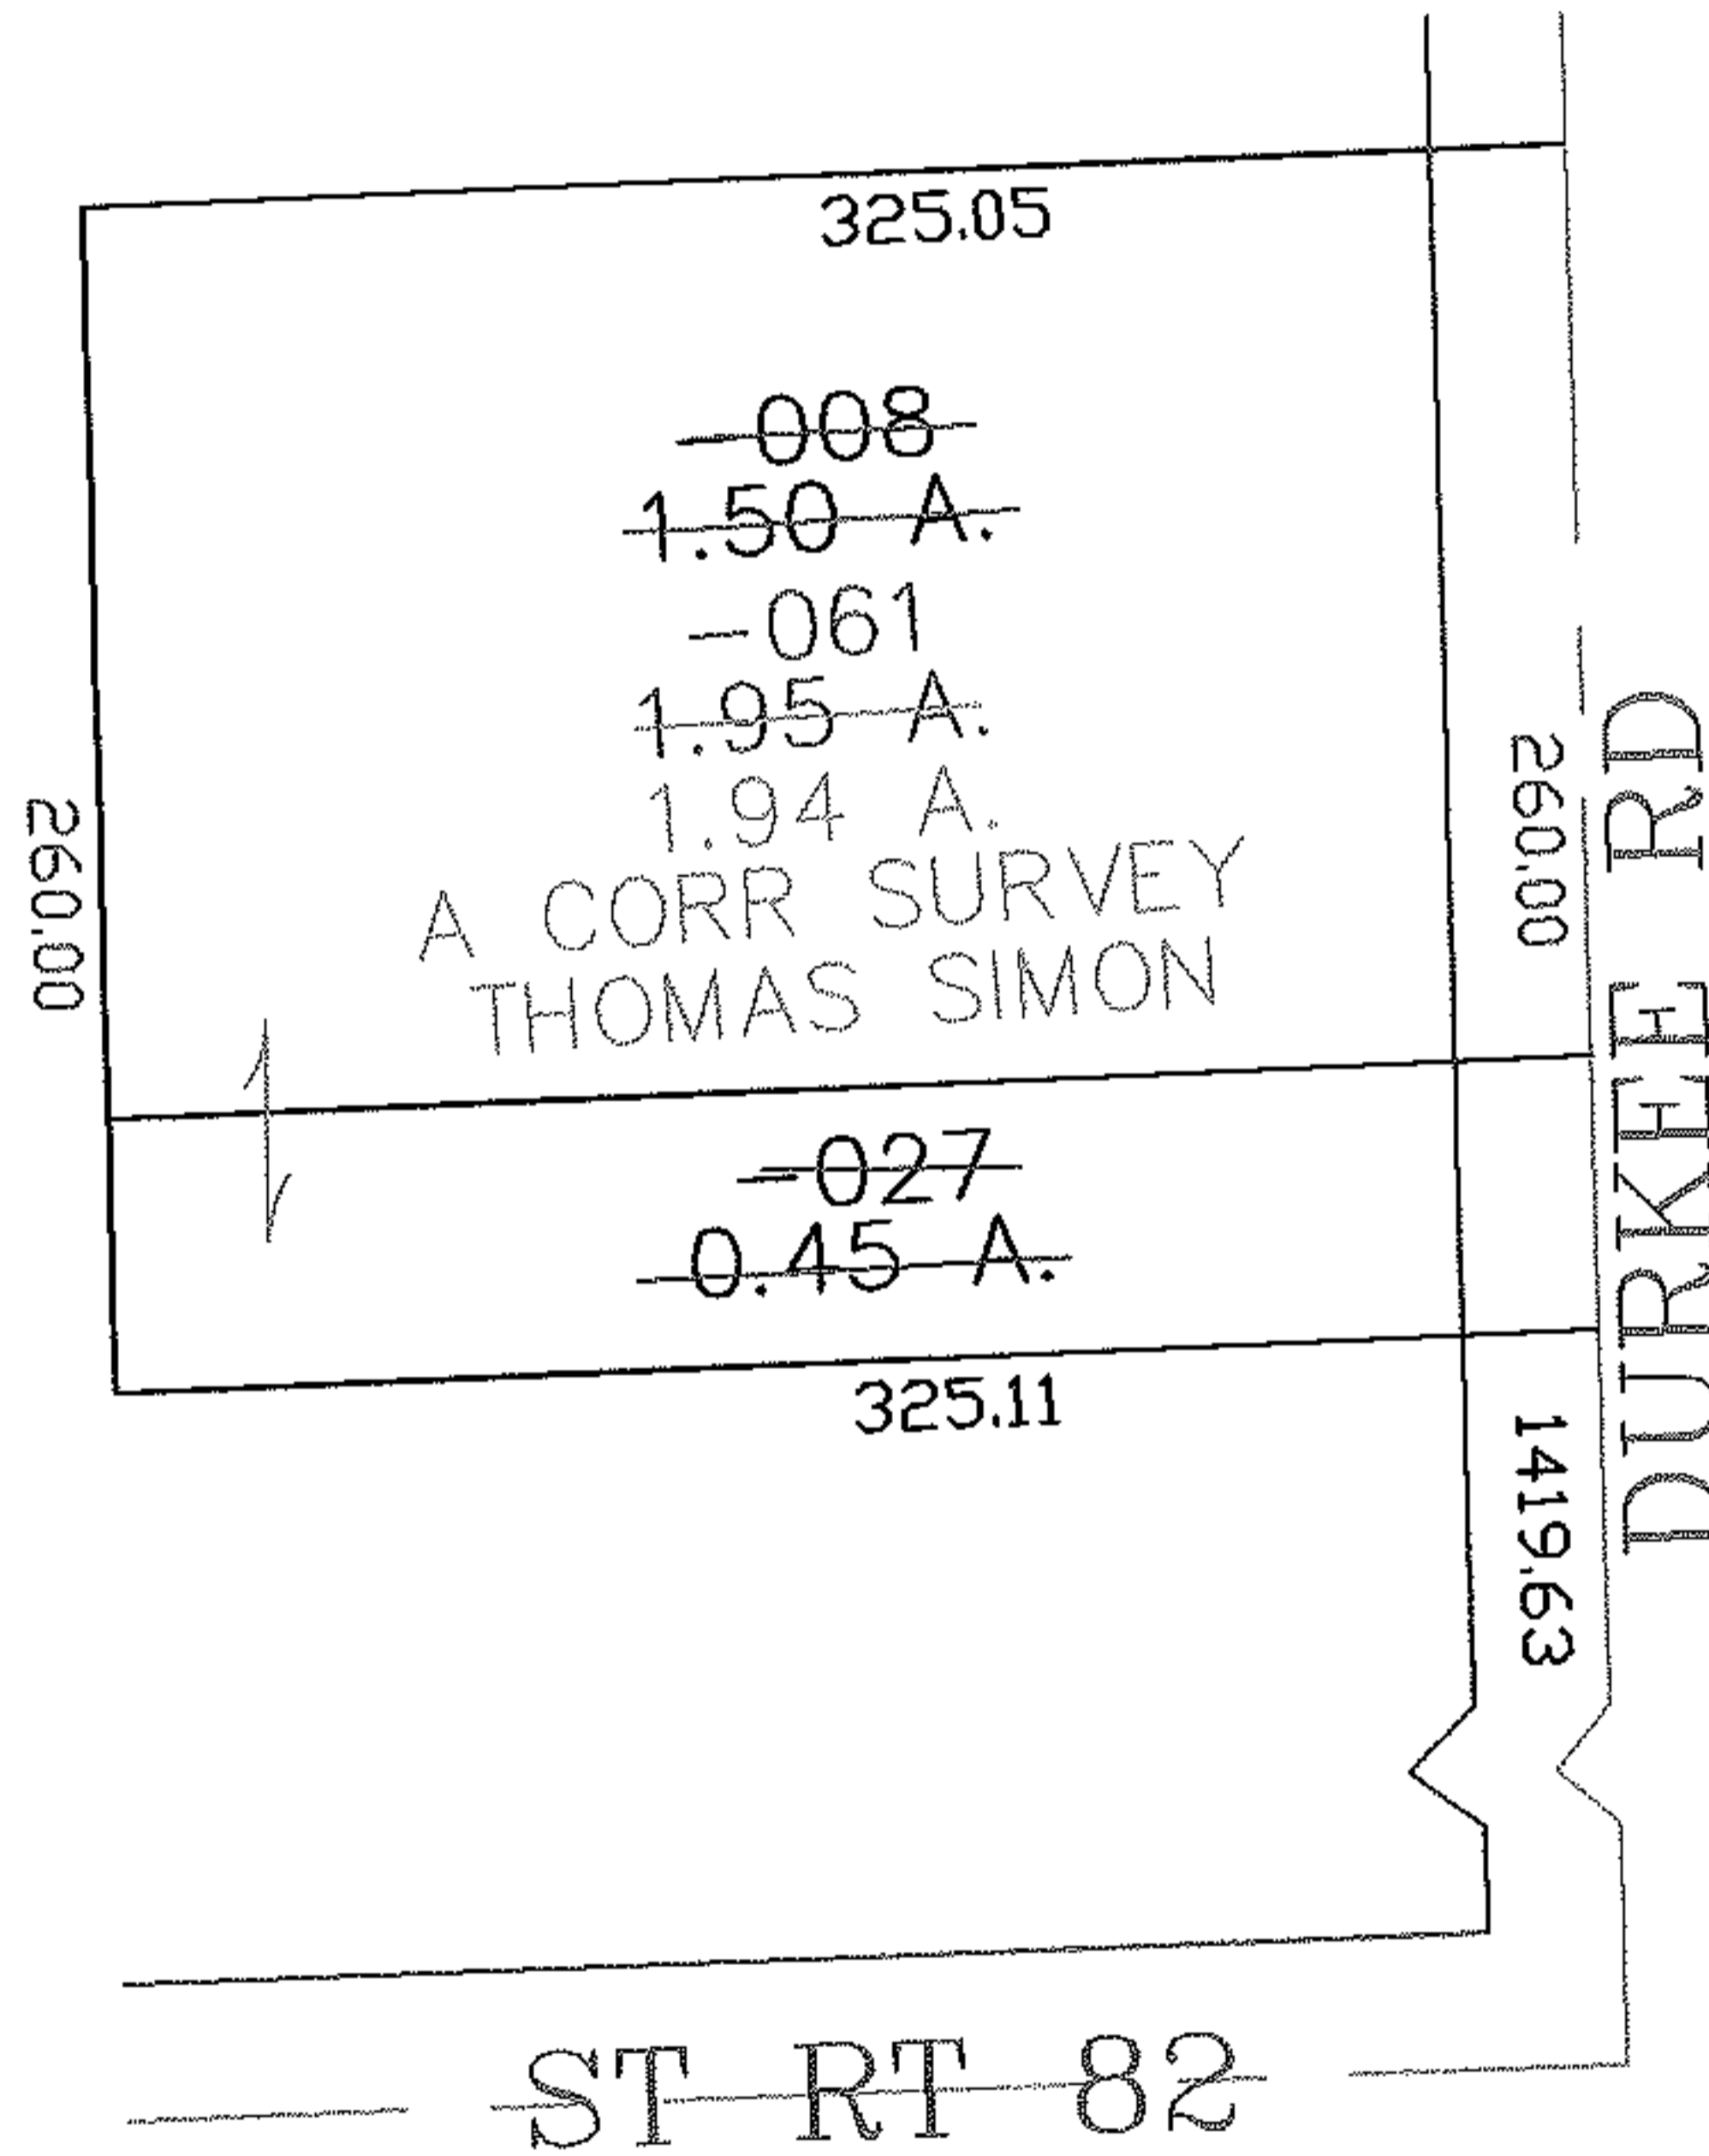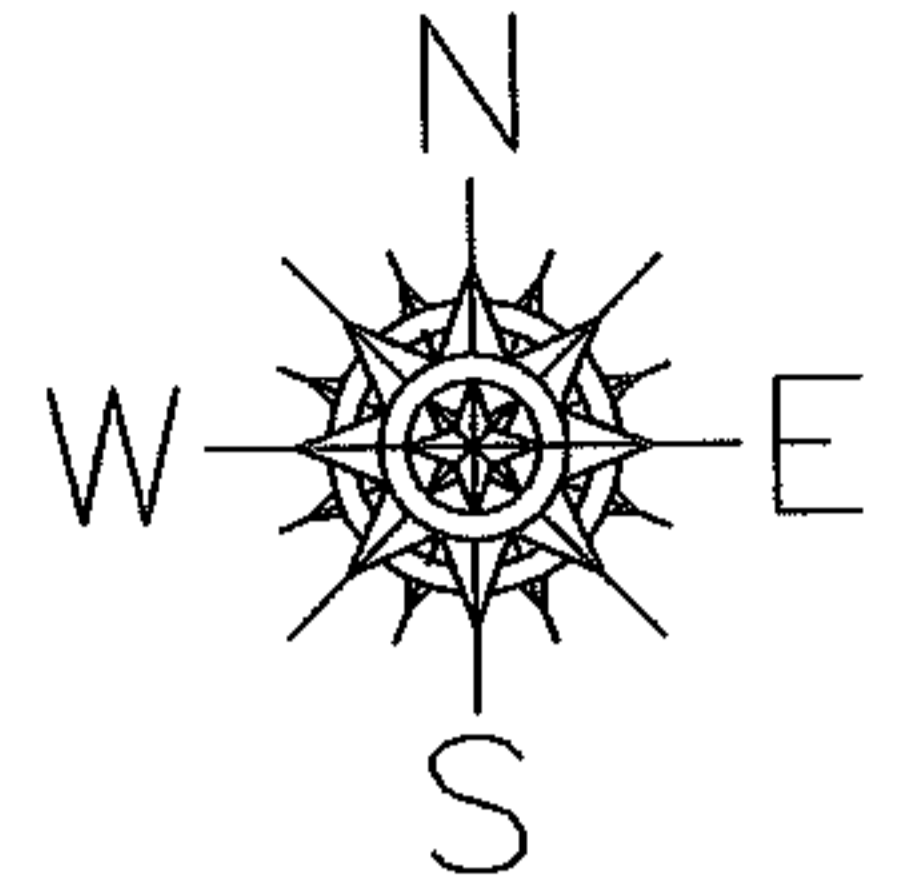

SPLITS/DEEDS PROCESSED

LORAIN COUNTY TAX MAP DEPARTMENT
226 MIDDLE AVE. ELYRIA, OHIO

SURVEYED BY: THOMAS SIMON

CLOSURE: 0.00 : 10.000

MAP PAGE(S): 11-00-086-B

APPROVED BY: JAH DATE: 11-6-07

SCALE: 1" = 100 PRIOR INSTRUMENT: OR 691/222