




MASTER

PARENT PARCEL: 04-00-021-000-233

CHILD PARCEL: 04-00-021-000-247, 248

STARTING POINT: CENTERLINES OF CHESTER RD & CENTER RD

07-02503

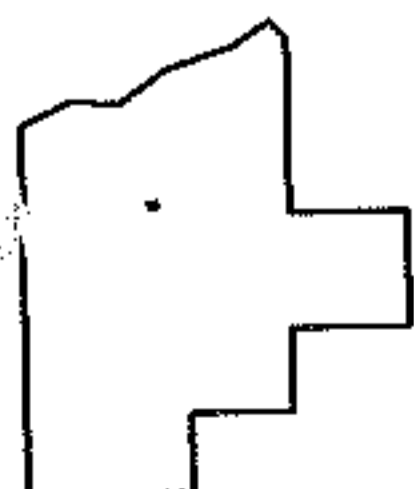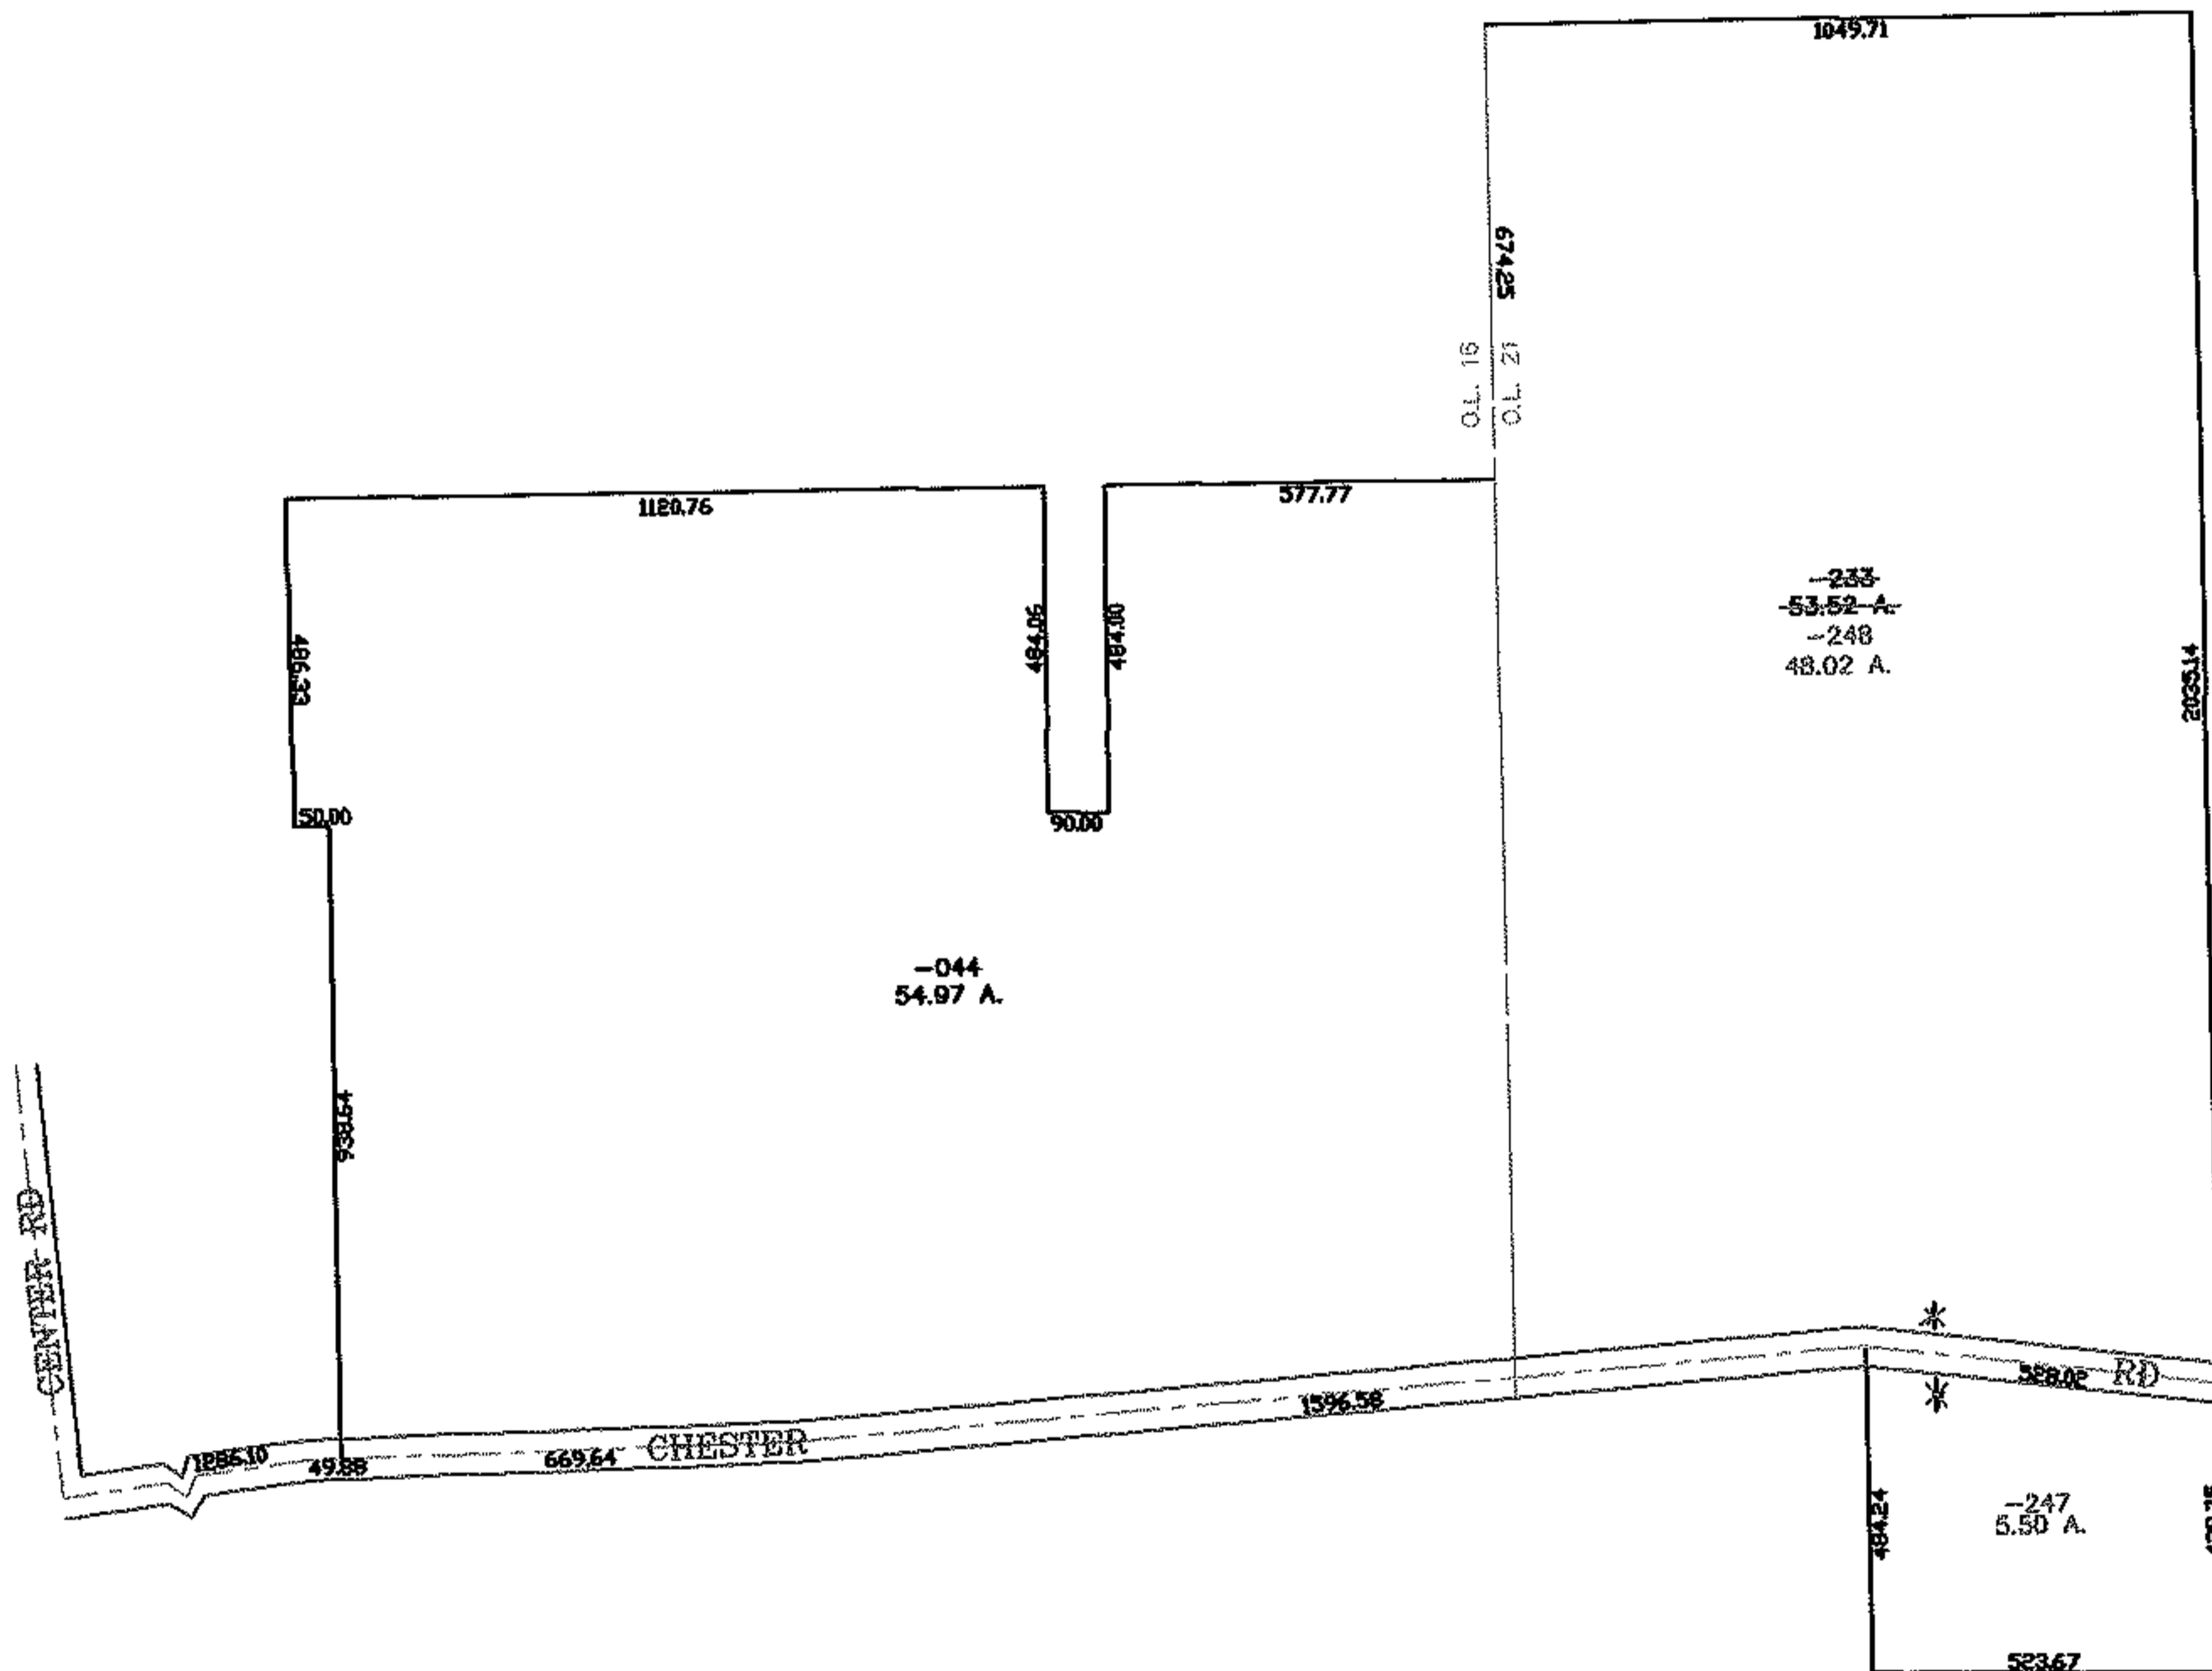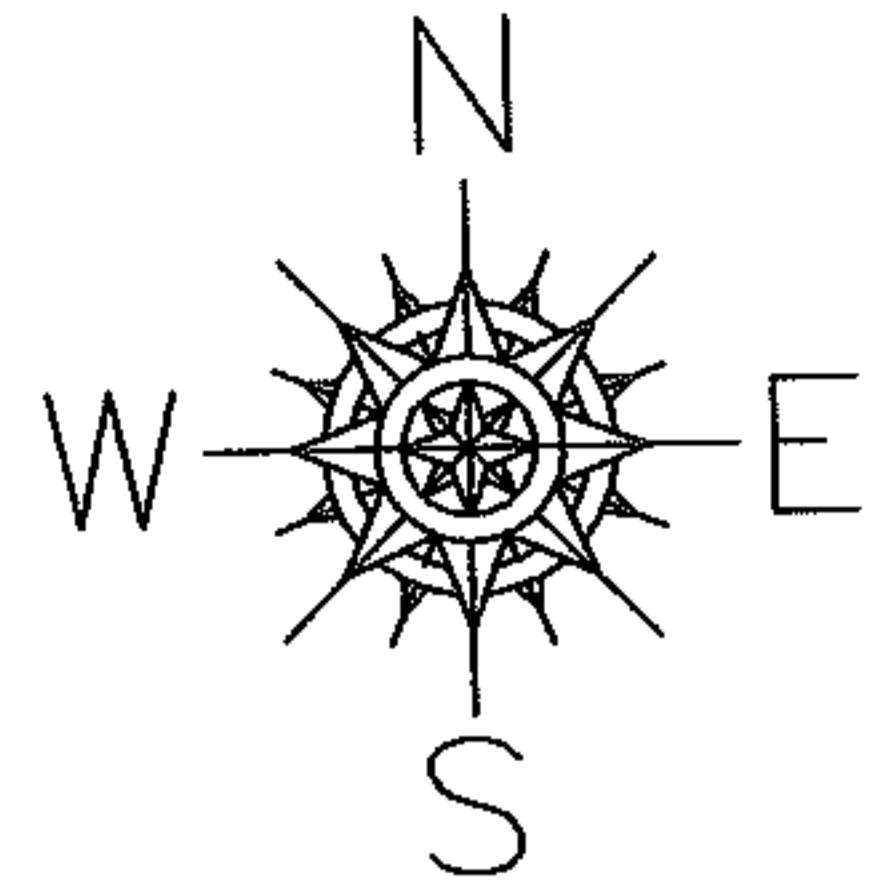

SPLITS/DEEDS PROCESSED

LORAIN COUNTY TAX MAP DEPARTMENT
226 MIDDLE AVE. ELYRIA, OHIO

SURVEYED BY: JOHN R ALBAN

CLOSURE: 0.00 : 10.000

MAP PAGE(S): 04-00-016-A, 04-00-021-E

APPROVED BY: JAH DATE: 12-19-07

SCALE: 1" = 500 PRIOR INSTRUMENT: DV 1384/817