


PARENT PARCEL: 09-00-096-103-030

CHILD PARCEL: _____

STARTING POINT: INTERSECTION OF C/L OF SMITH ST. AND C/L OF S. PLEASANT ST.

12-02504-C

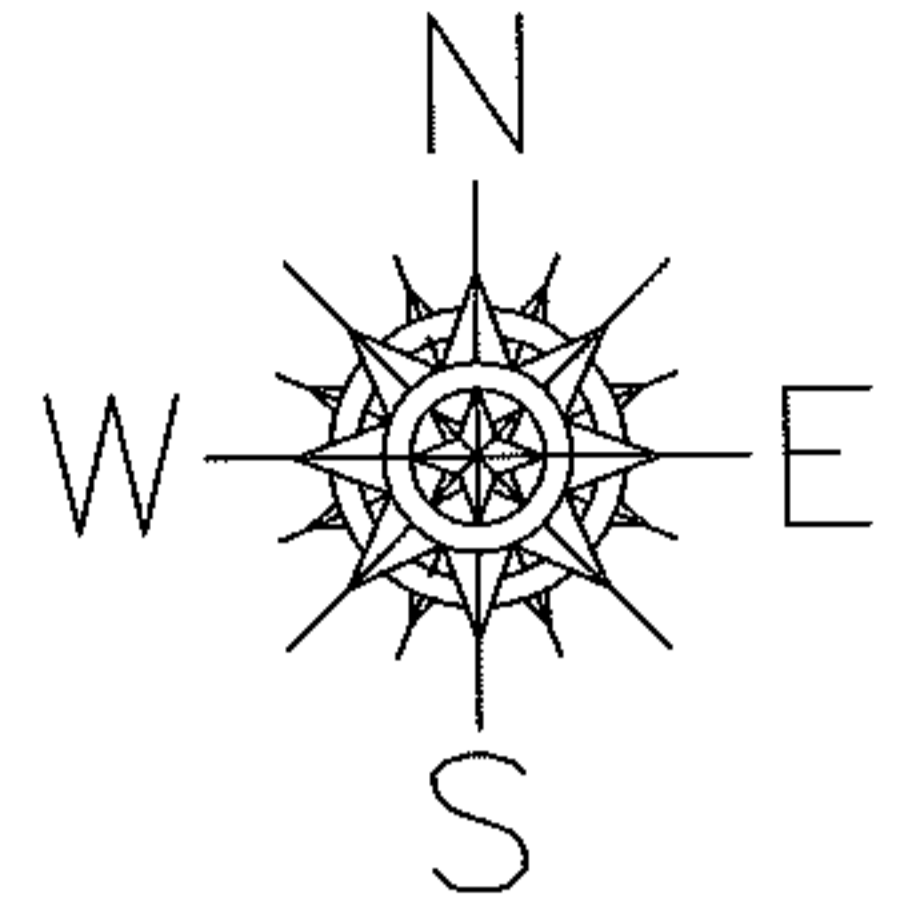

FRONTAGE AND DEPTH TO ACERAGE CORRECTION

09-00-096-103-030

0.37 A.

~~123.50 X 136~~

PER SURV. M. BRAMHALL

SPLITS/DEEDS PROCESSED

LORAIN COUNTY TAX MAP DEPARTMENT
226 MIDDLE AVE. ELYRIA, OHIO

SURVEYED BY: MICHAEL BRAMHALL

CLOSURE: .01:10,000

MAP PAGE(S): 9-00-096-A

APPROVED BY: RRM DATE: 5-9-12

SCALE: 1"= 50' PRIOR INST.: 20000667743