


PARENT PARCEL: 12-00-090-000-038



CHILD PARCEL: XX-XX-XXX-XXX-XXX

STARTING POINT: I.P. FD., CL OF CROCKER RD. & CL OF STATION RD.

12-02505-C

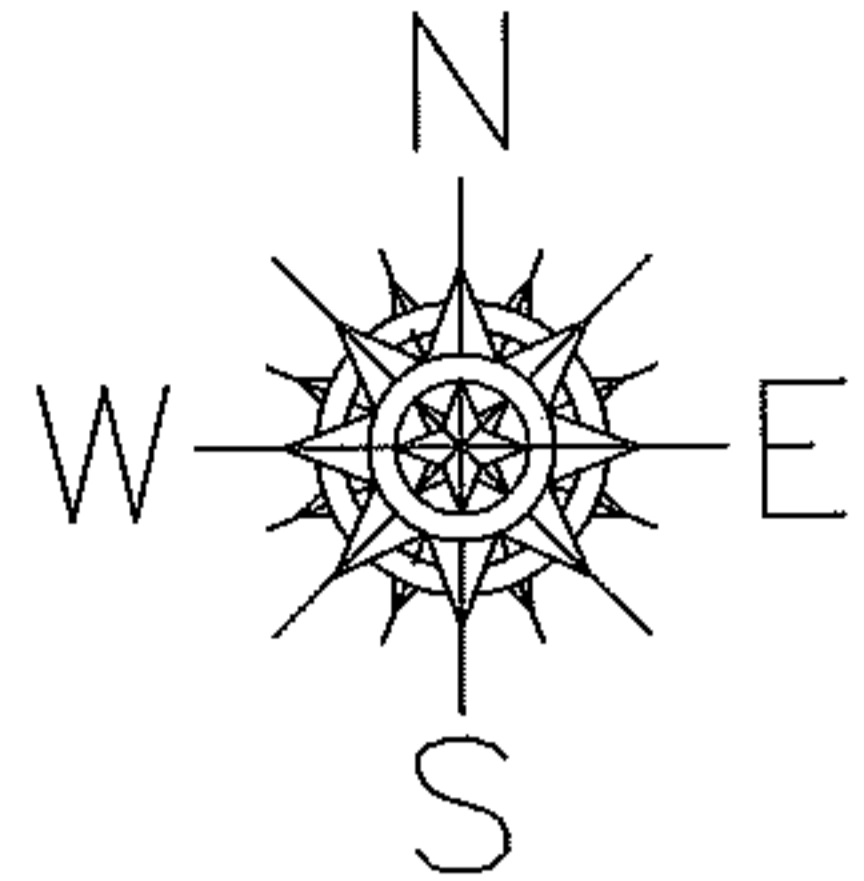

MAP CORRECTION ONLY

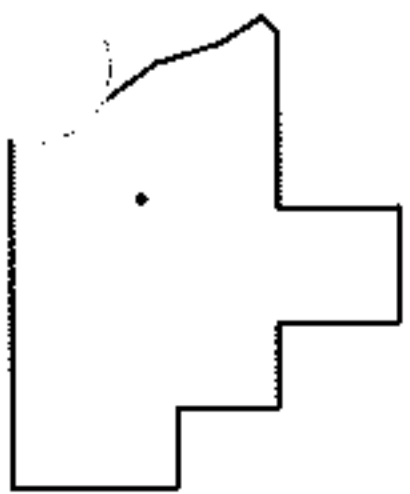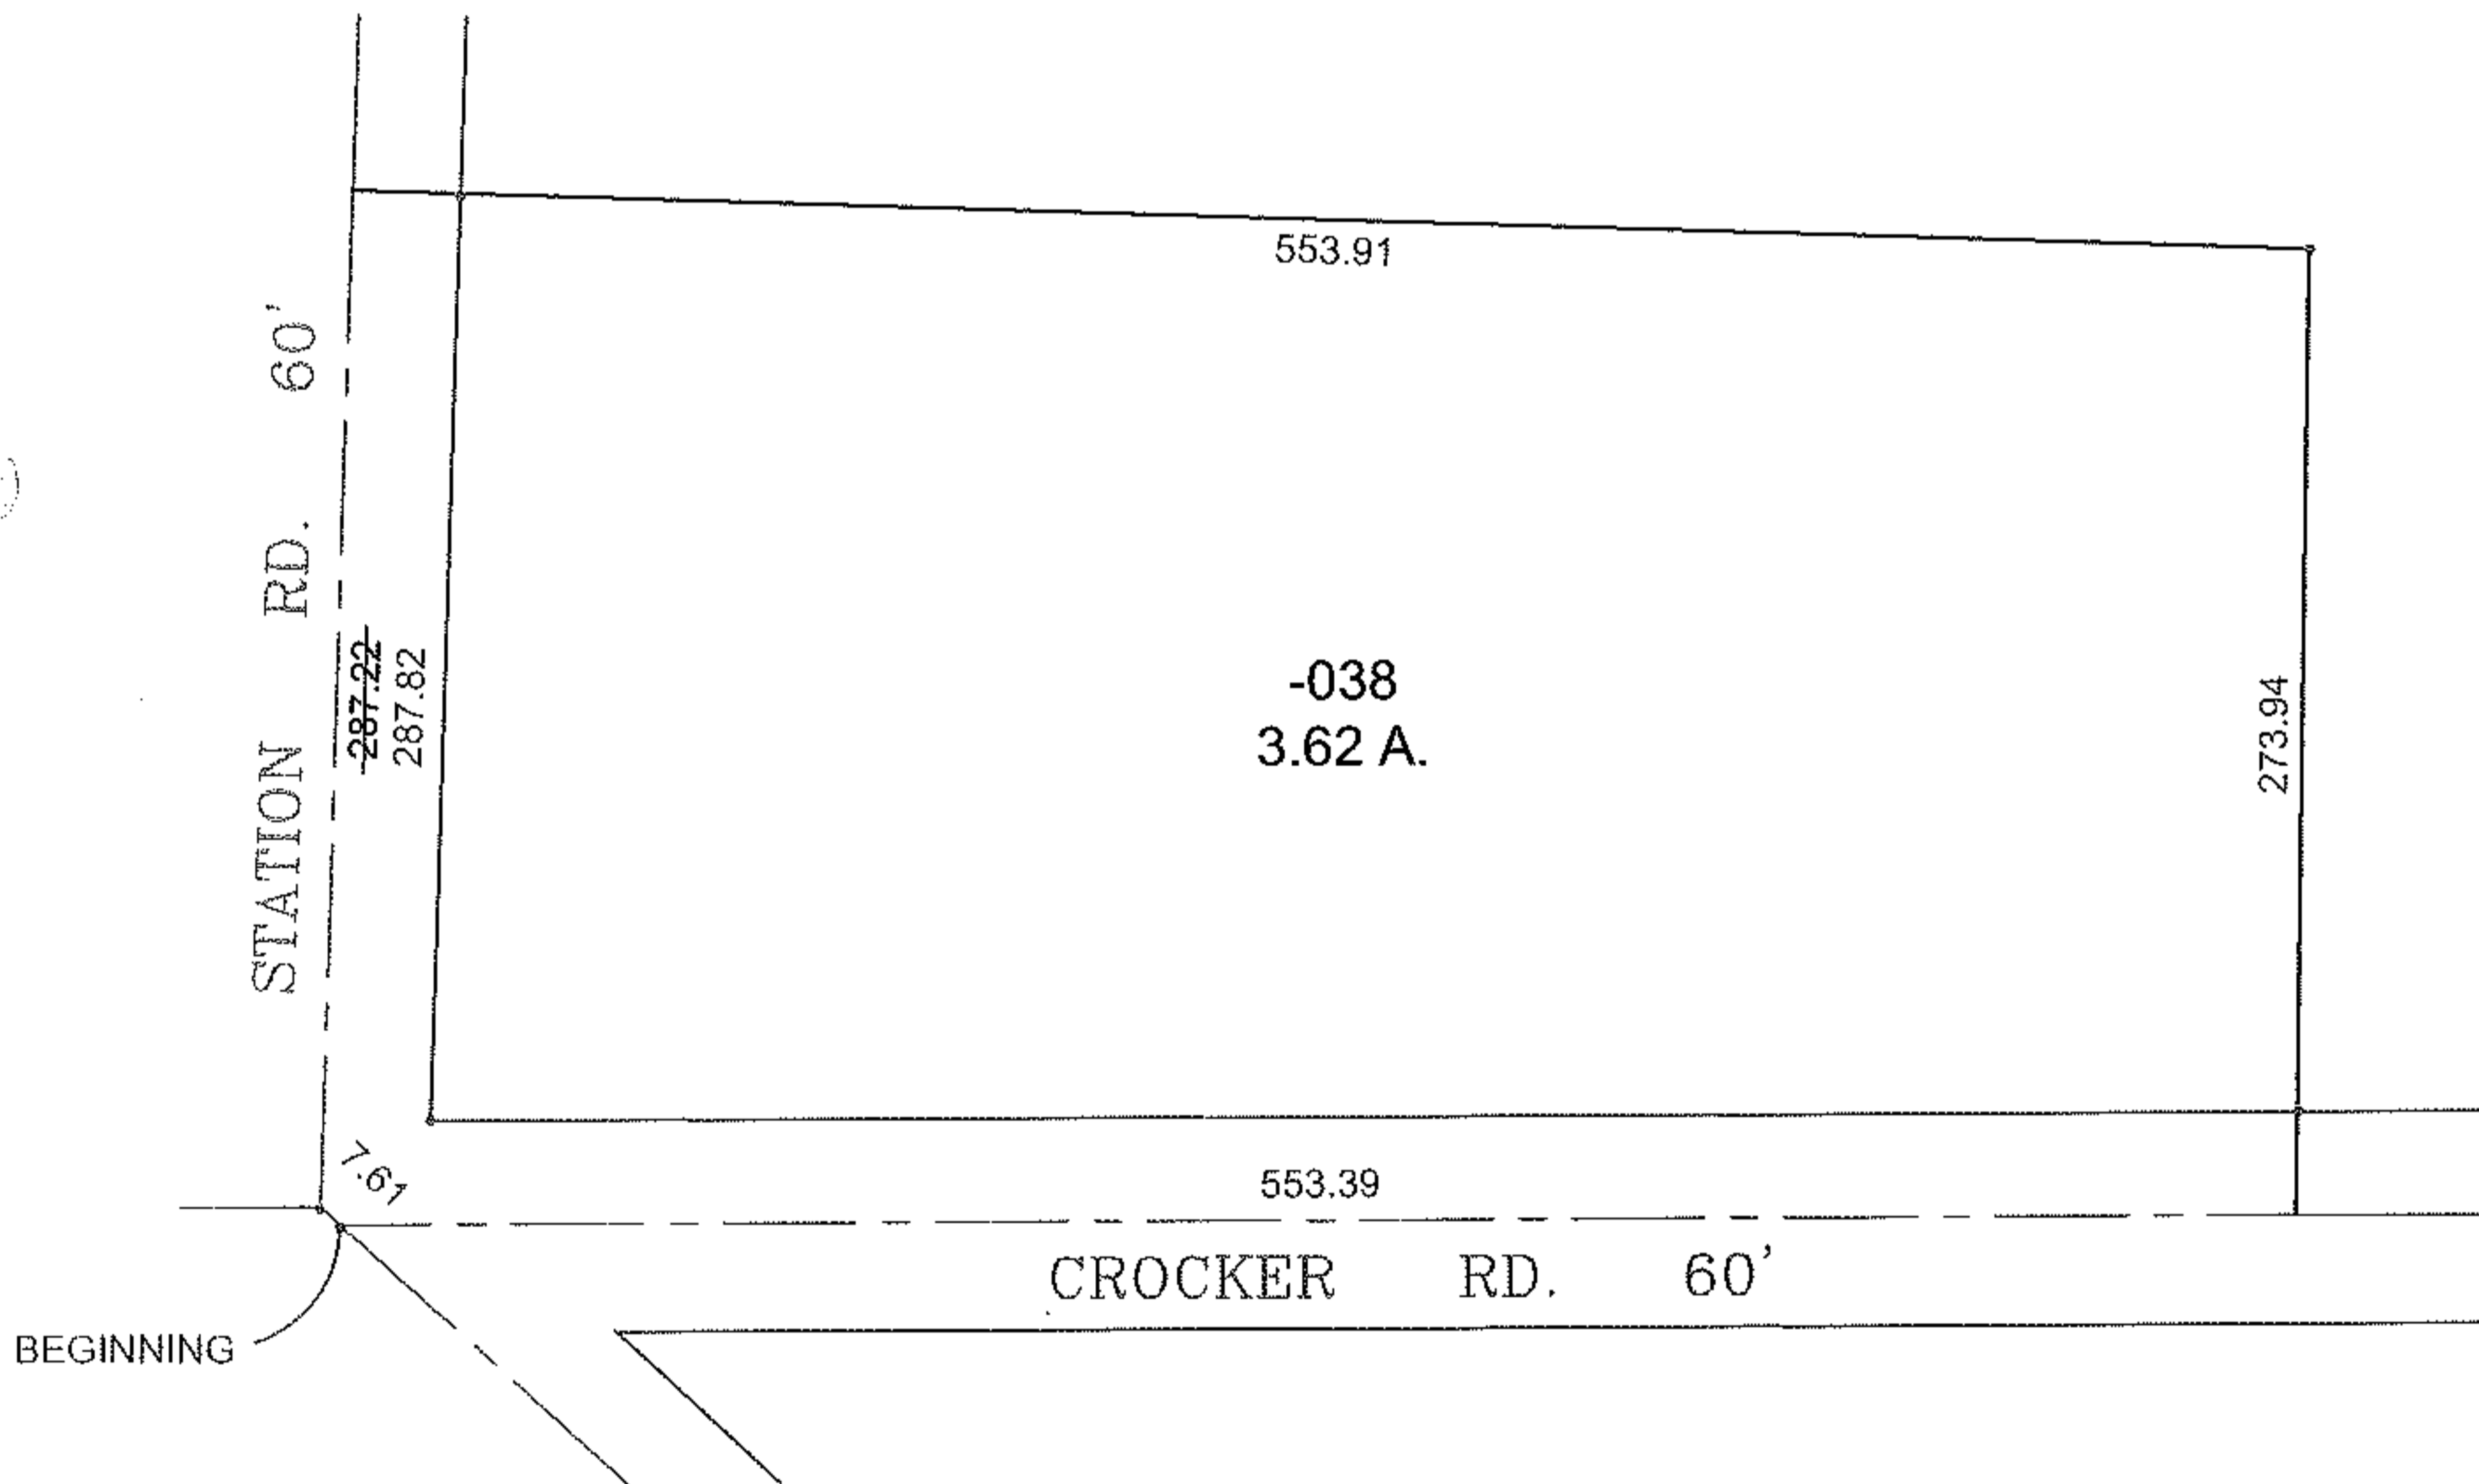

SPLITS/DEEDS PROCESSED

LORAIN COUNTY TAX MAP DEPARTMENT
226 MIDDLE AVE. ELYRIA, OHIO

SURVEYED BY: DALE R. HAYWOOD

CLOSURE: 0.01 : 10,000

MAP PAGE(S): 12-00-090-B

APPROVED BY: TJS DATE: 5/10/12

SCALE: 1" = 100 PRIOR INST.: 20000722465