
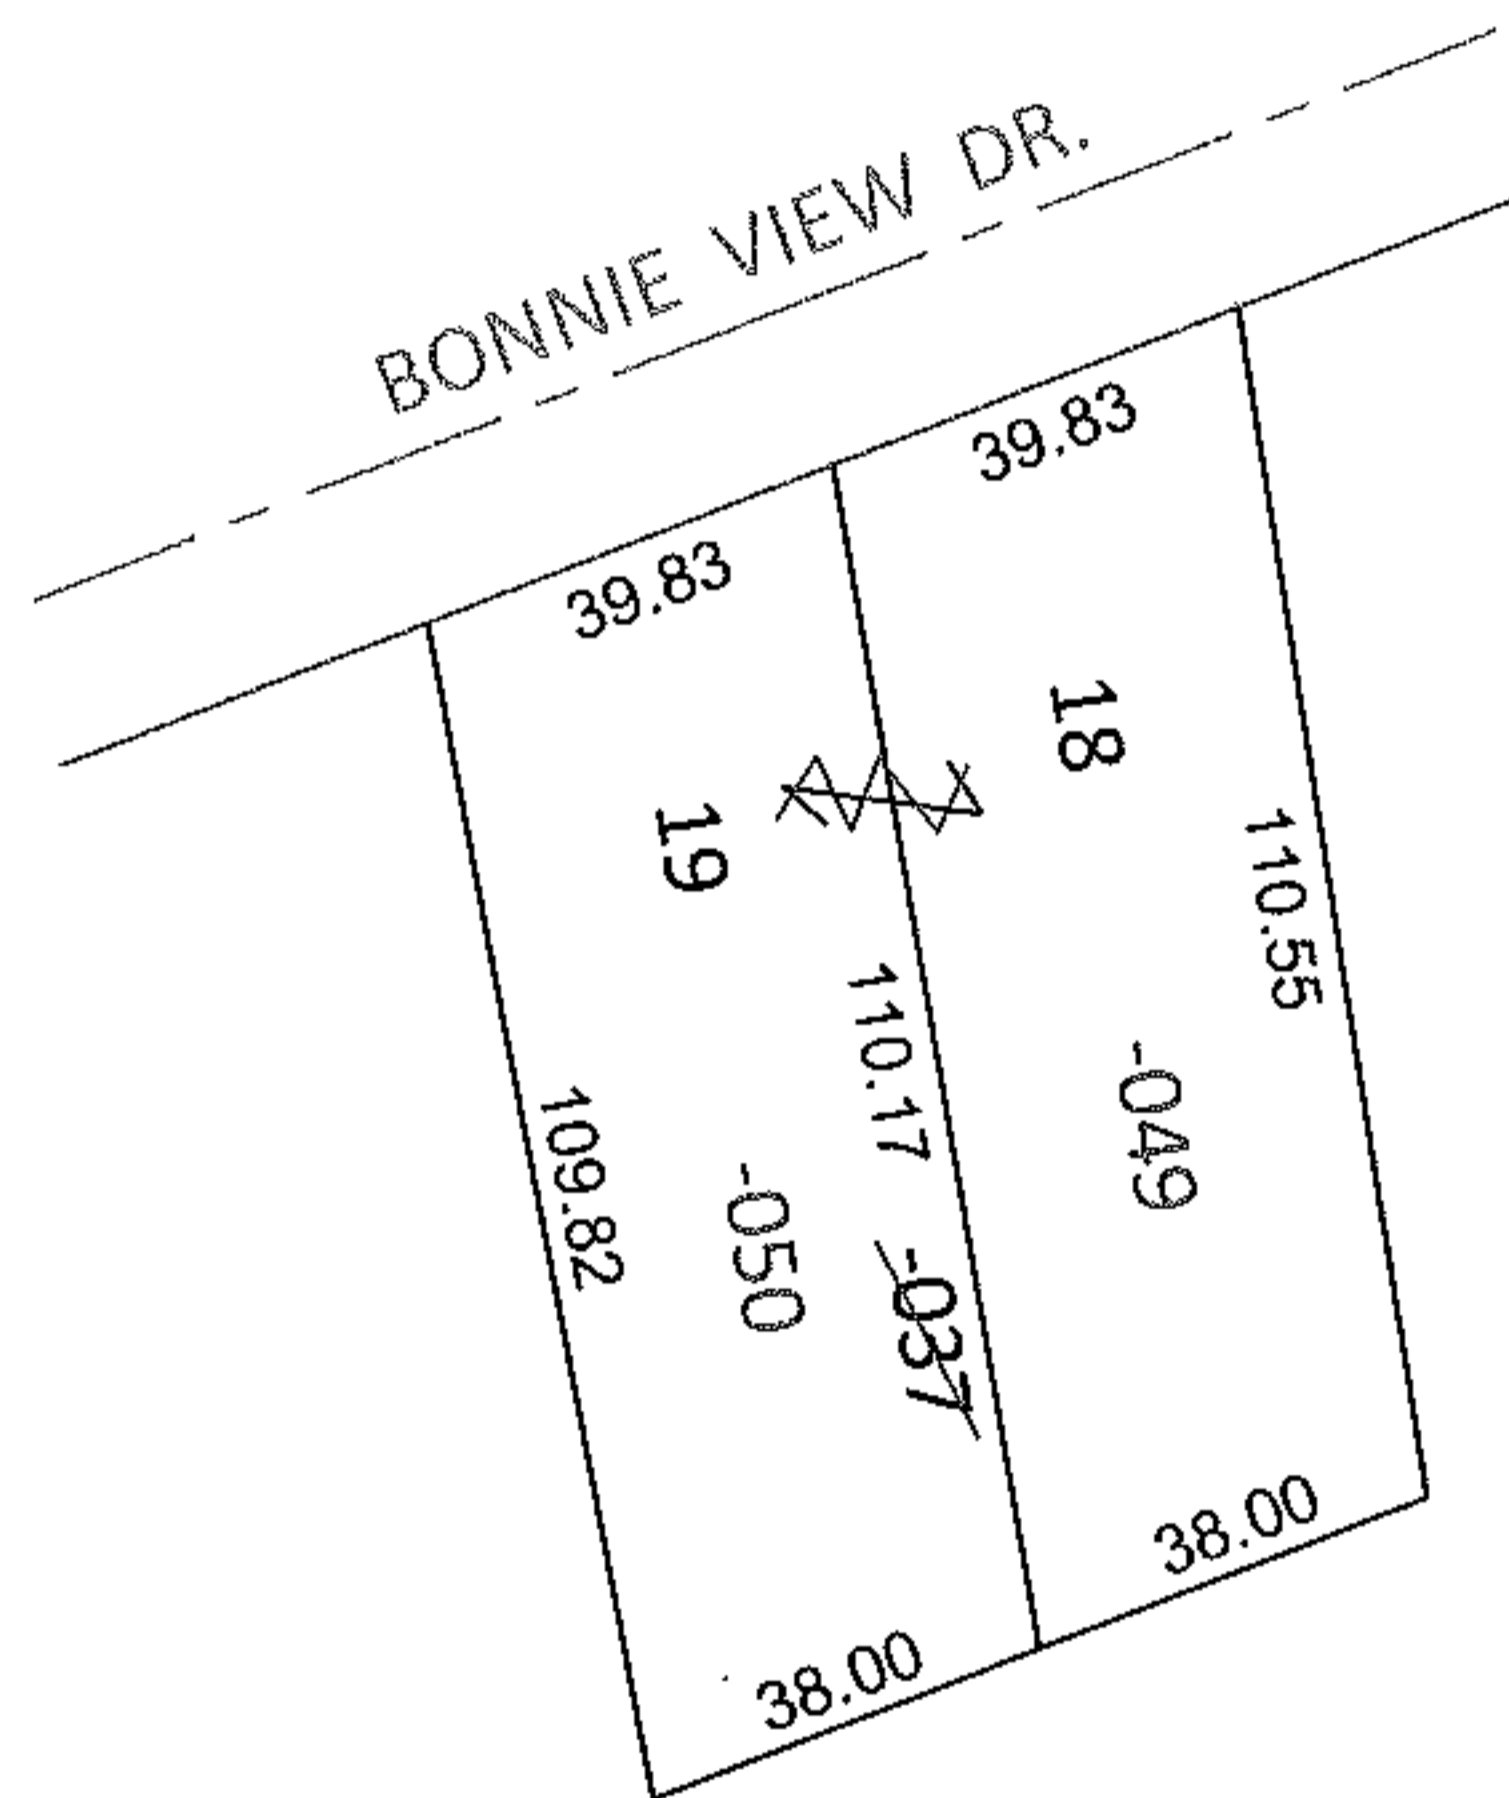


PARENT PARCEL: 04-00-007-101-037

CHILD PARCEL: 04-00-007-101-049, -050

STARTING POINT: S/L'S 18 & 19 IN LAKE COLONY PROPOSED SUB.

12-02509-X

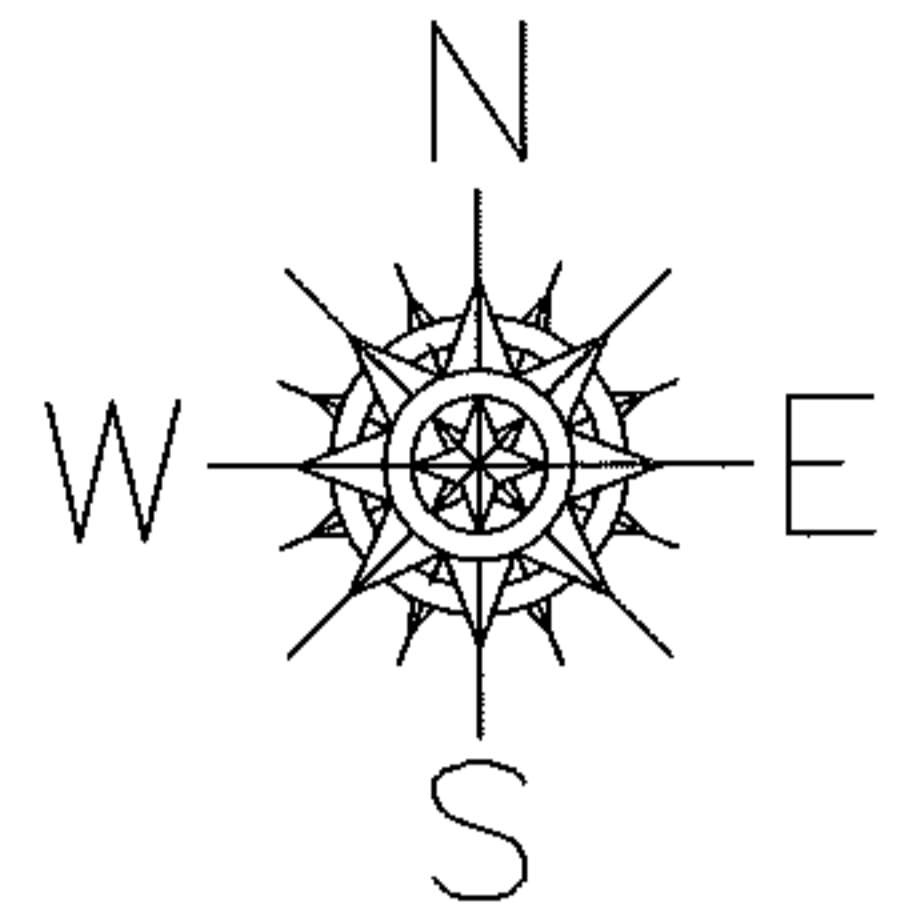

UNCOMBINATION


~~04-00-007-101-037~~

~~79.66 X 121~~

04-00-007-101-049
39.83 X 110.55

04-00-007-101-050
39.83 X 110.17

PER PRIOR DEEDS

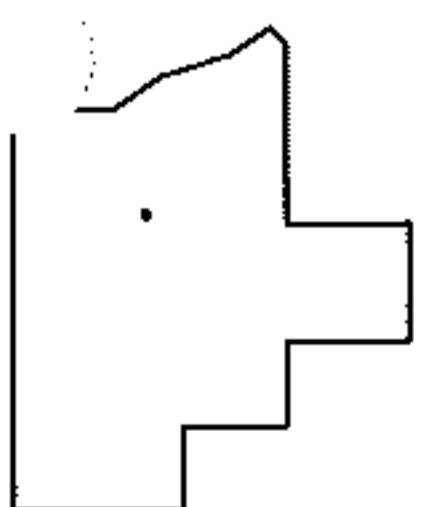

SPLITS/DEEDS PROCESSED

LORAIN COUNTY TAX MAP DEPARTMENT
226 MIDDLE AVE. ELYRIA, OHIO

SURVEYED BY: N/A

CLOSURE: .01:10,000

MAP PAGE(S): 4-00-007-A

APPROVED BY: RRM DATE: 5-14-12

SCALE: 1"= 50' PRIOR INST.: 20080273473