
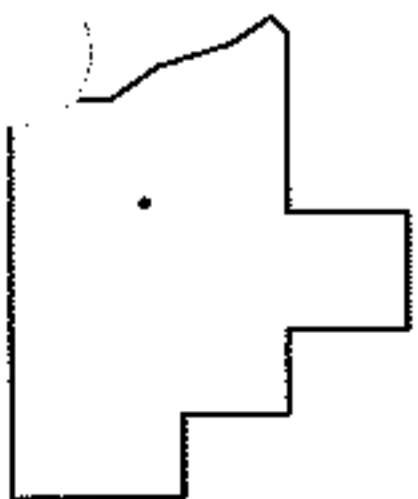
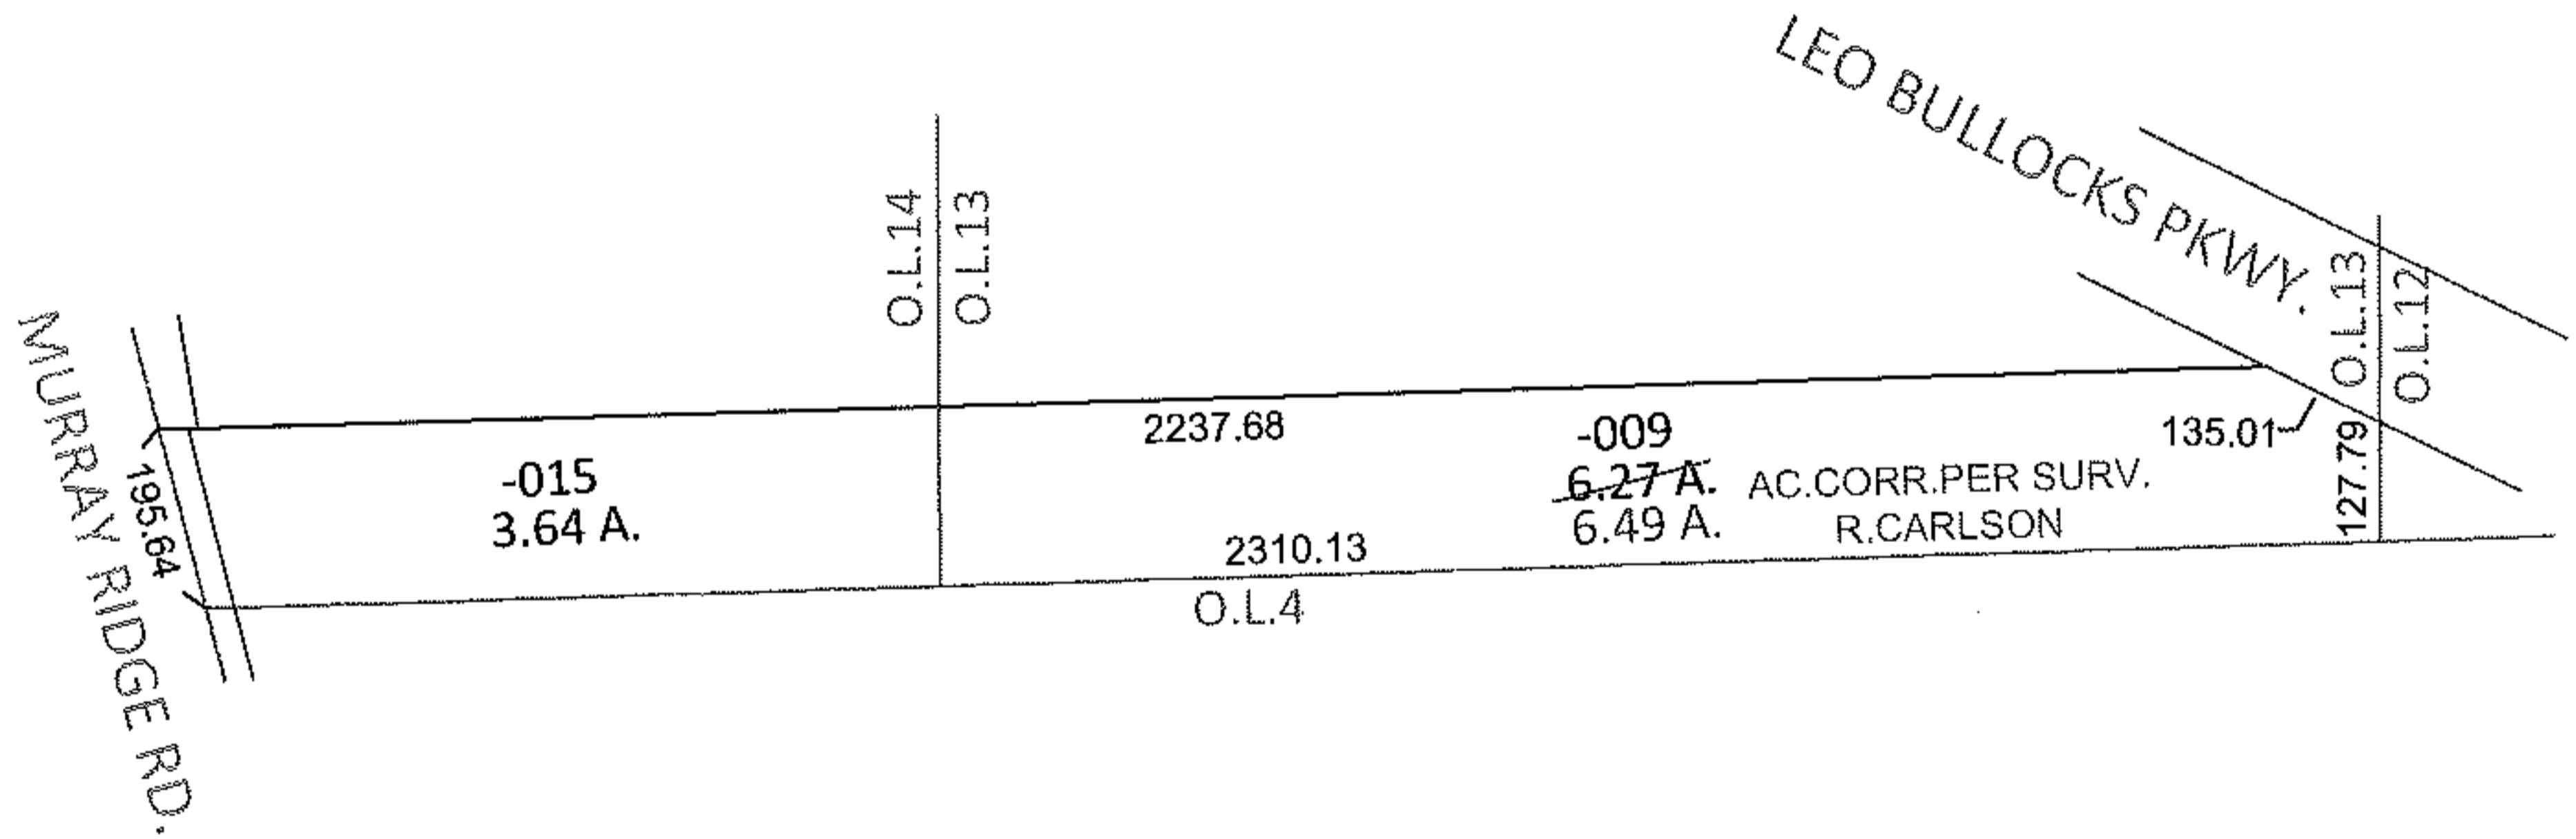


PARENT PARCEL: 06-24-013-000-009, 06-24-014-000-015

CHILD PARCEL: _____

STARTING POINT: INTERSECTION OF C/L OF MURRAY RIDGE RD. AND SOUTH LINE OF O.L.14

12-02510-A

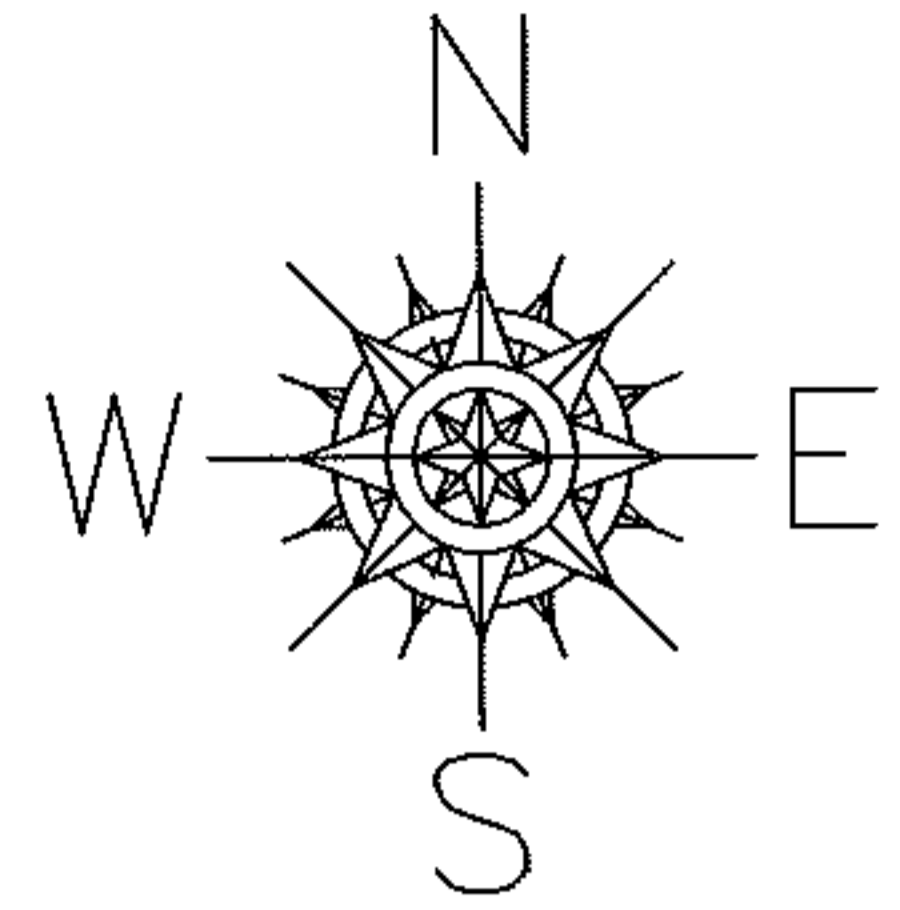

SPLITS/DEEDS PROCESSED

LORAIN COUNTY TAX MAP DEPARTMENT
226 MIDDLE AVE. ELYRIA, OHIO

SURVEYED BY: RICHARD D. CARLSON

CLOSURE: .01:10,000

MAP PAGE(S): 6-112, 6-113

APPROVED BY: RRM DATE: 5-15-12

SCALE: 1" = 400 PRIOR INST.: 20120411697