
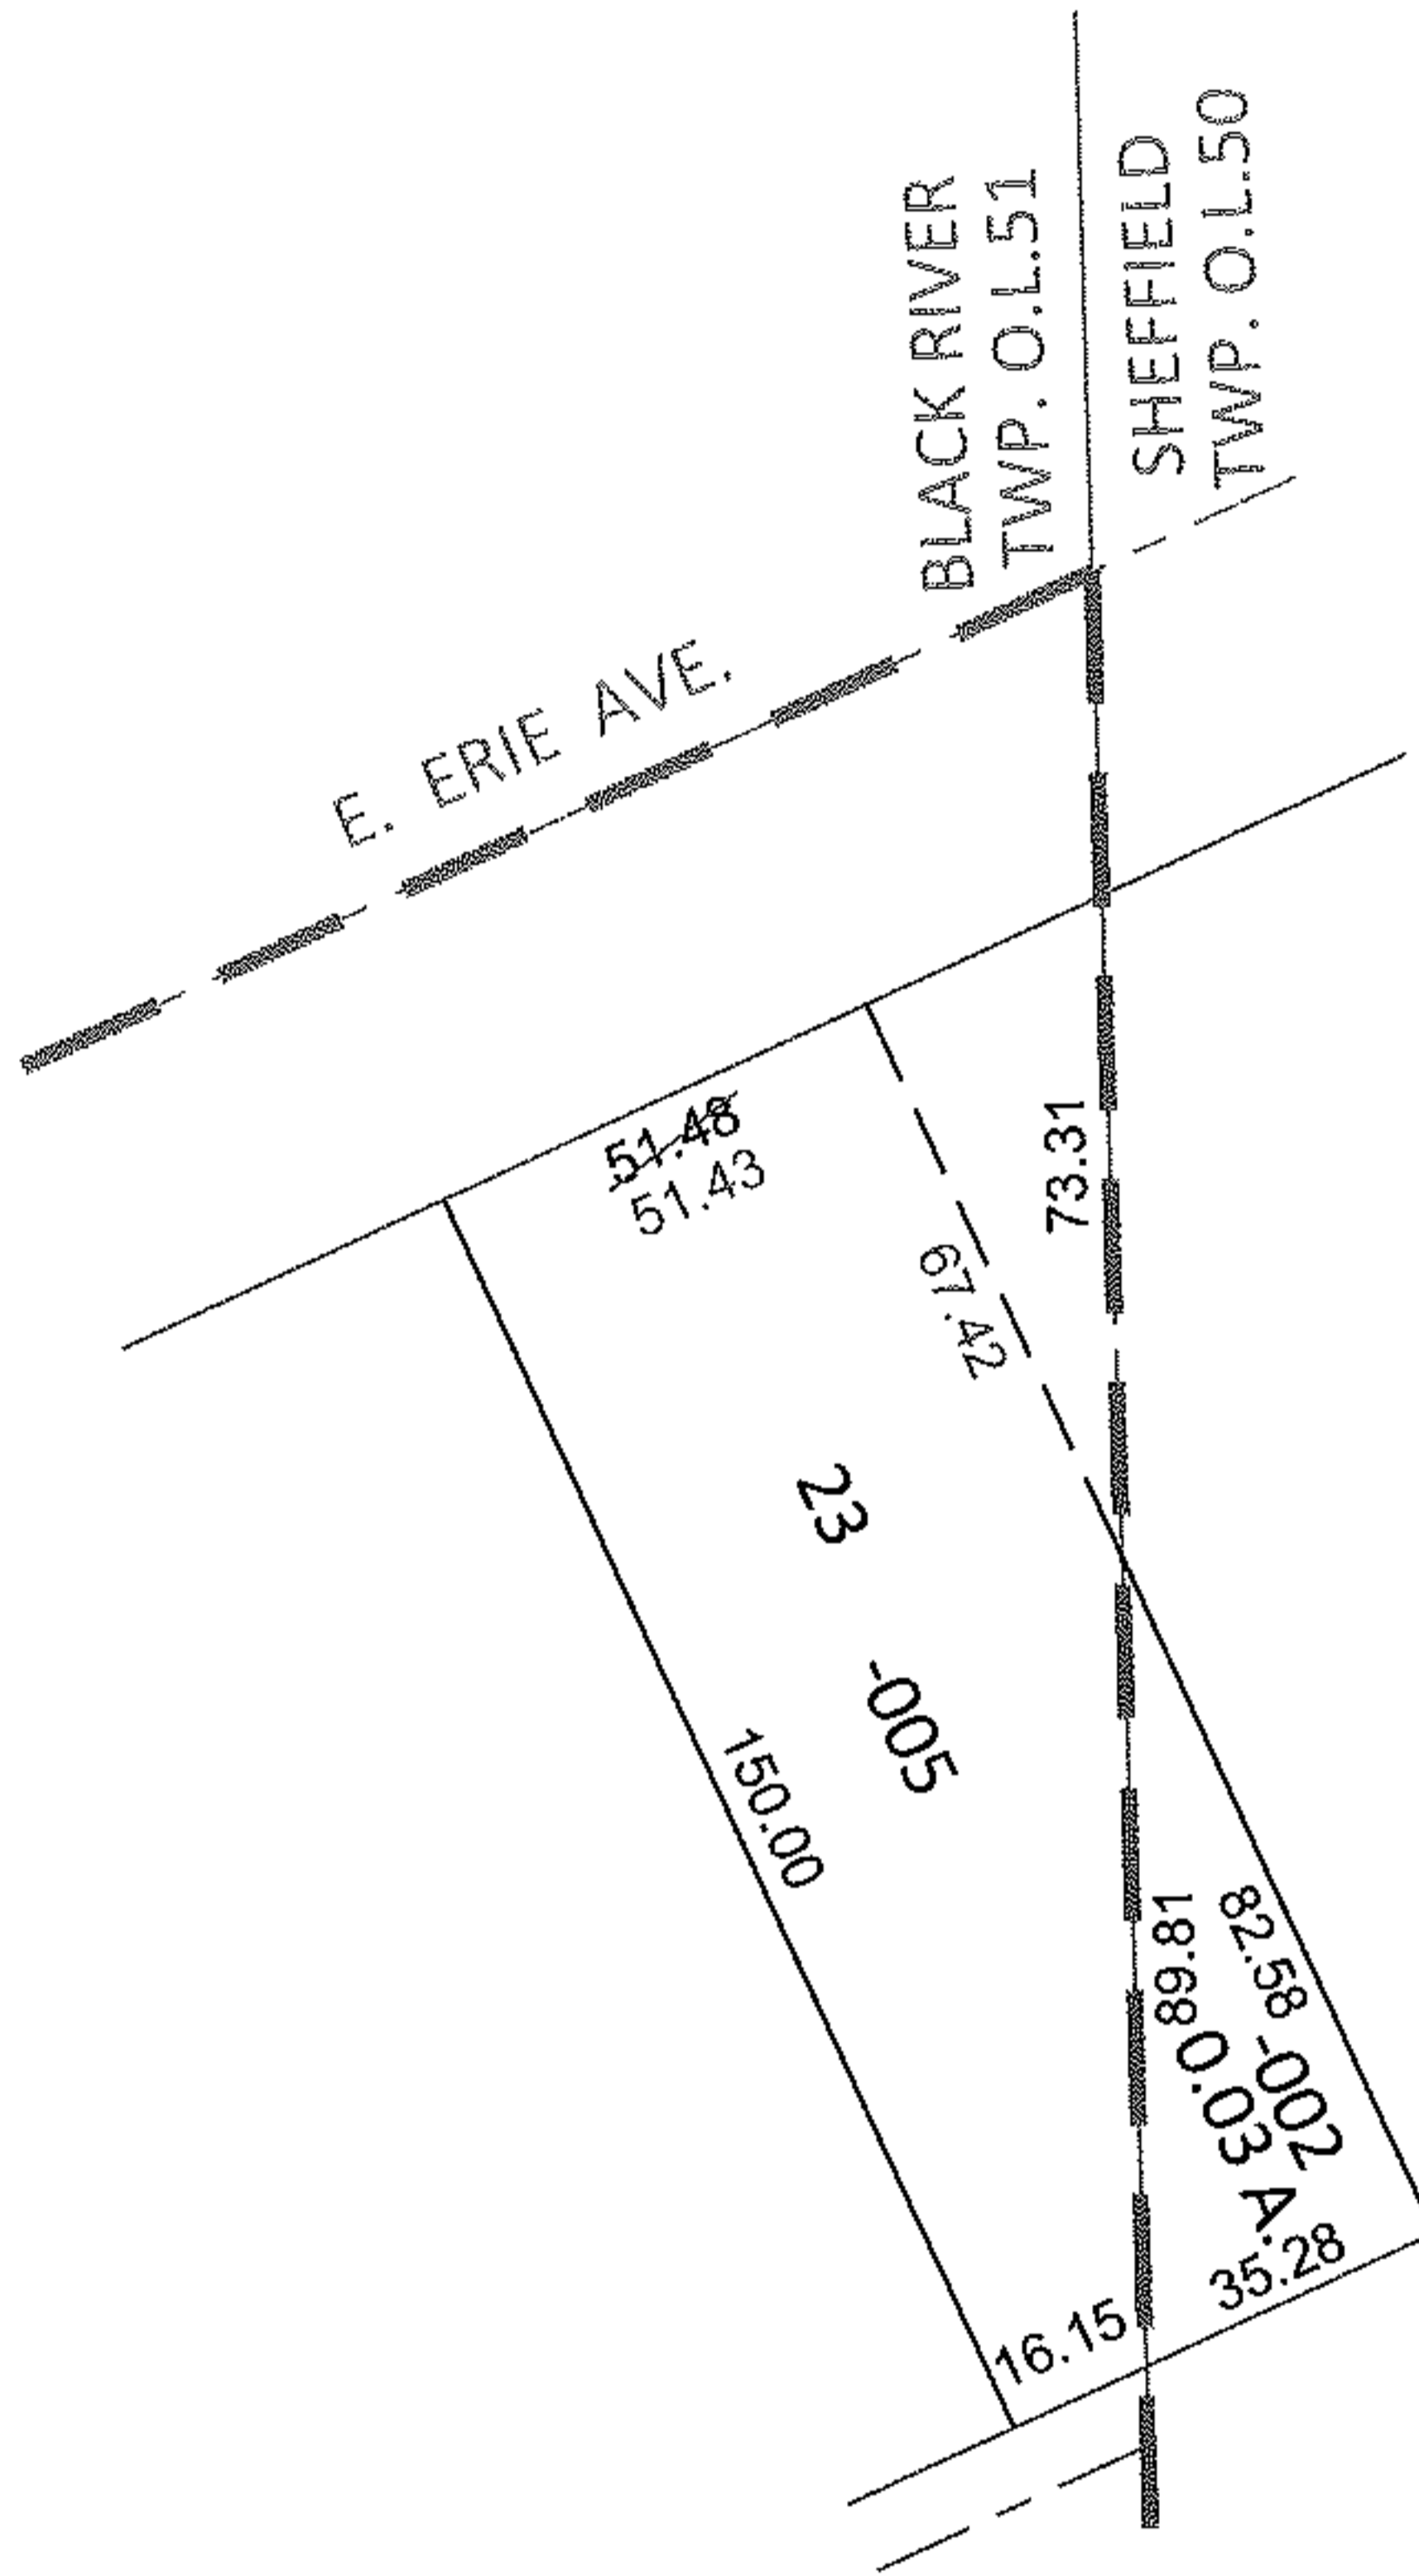


PARENT PARCEL: 02-00-051-108-005, 03-00-050-102-002

12-02514-C

CHILD PARCEL: _____

STARTING POINT: PART OF S/L 23 IN BONNY BRAE ADD. (VOL.7 PG.14)

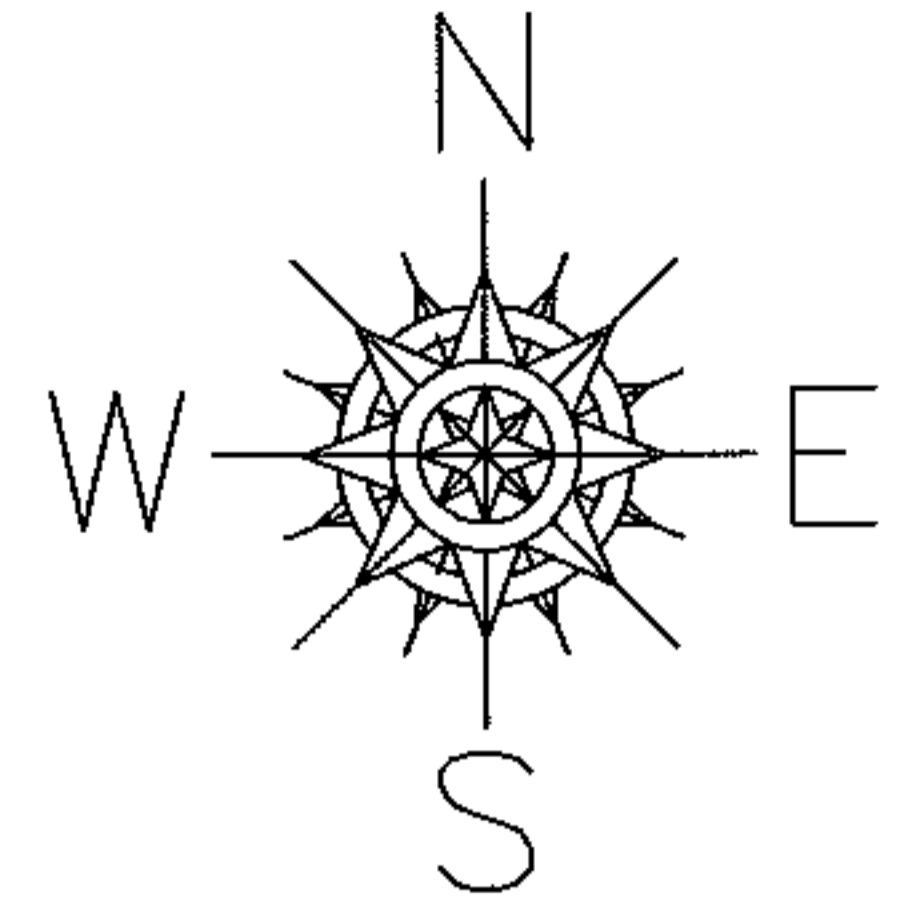


FRONTAGE AND DEPTH CORRECTION

02-00-051-108-005

51.43 X 150

~~51.48 X 158~~

PER PRIOR DEEDS

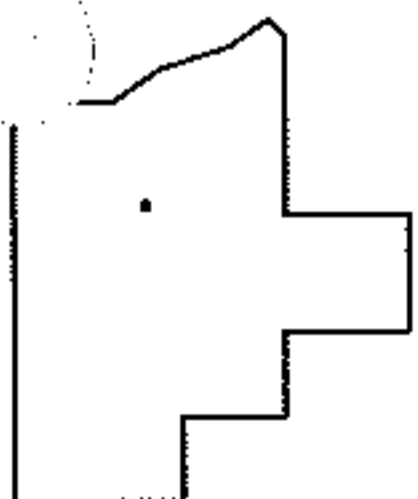

SPLITS/DEEDS PROCESSED

LORAIN COUNTY TAX MAP DEPARTMENT
226 MIDDLE AVE. ELYRIA, OHIO

SURVEYED BY: N/A

CLOSURE: N/A

MAP PAGE(S): 2-00-051-A, 3-00-050

APPROVED BY: RRM DATE: 5-22-12

SCALE: 1" = 50' PRIOR INST.: DV 1271/252