
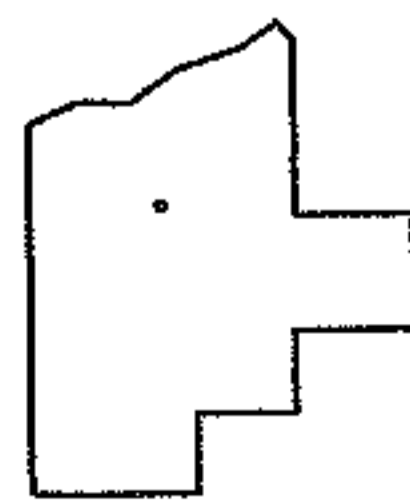
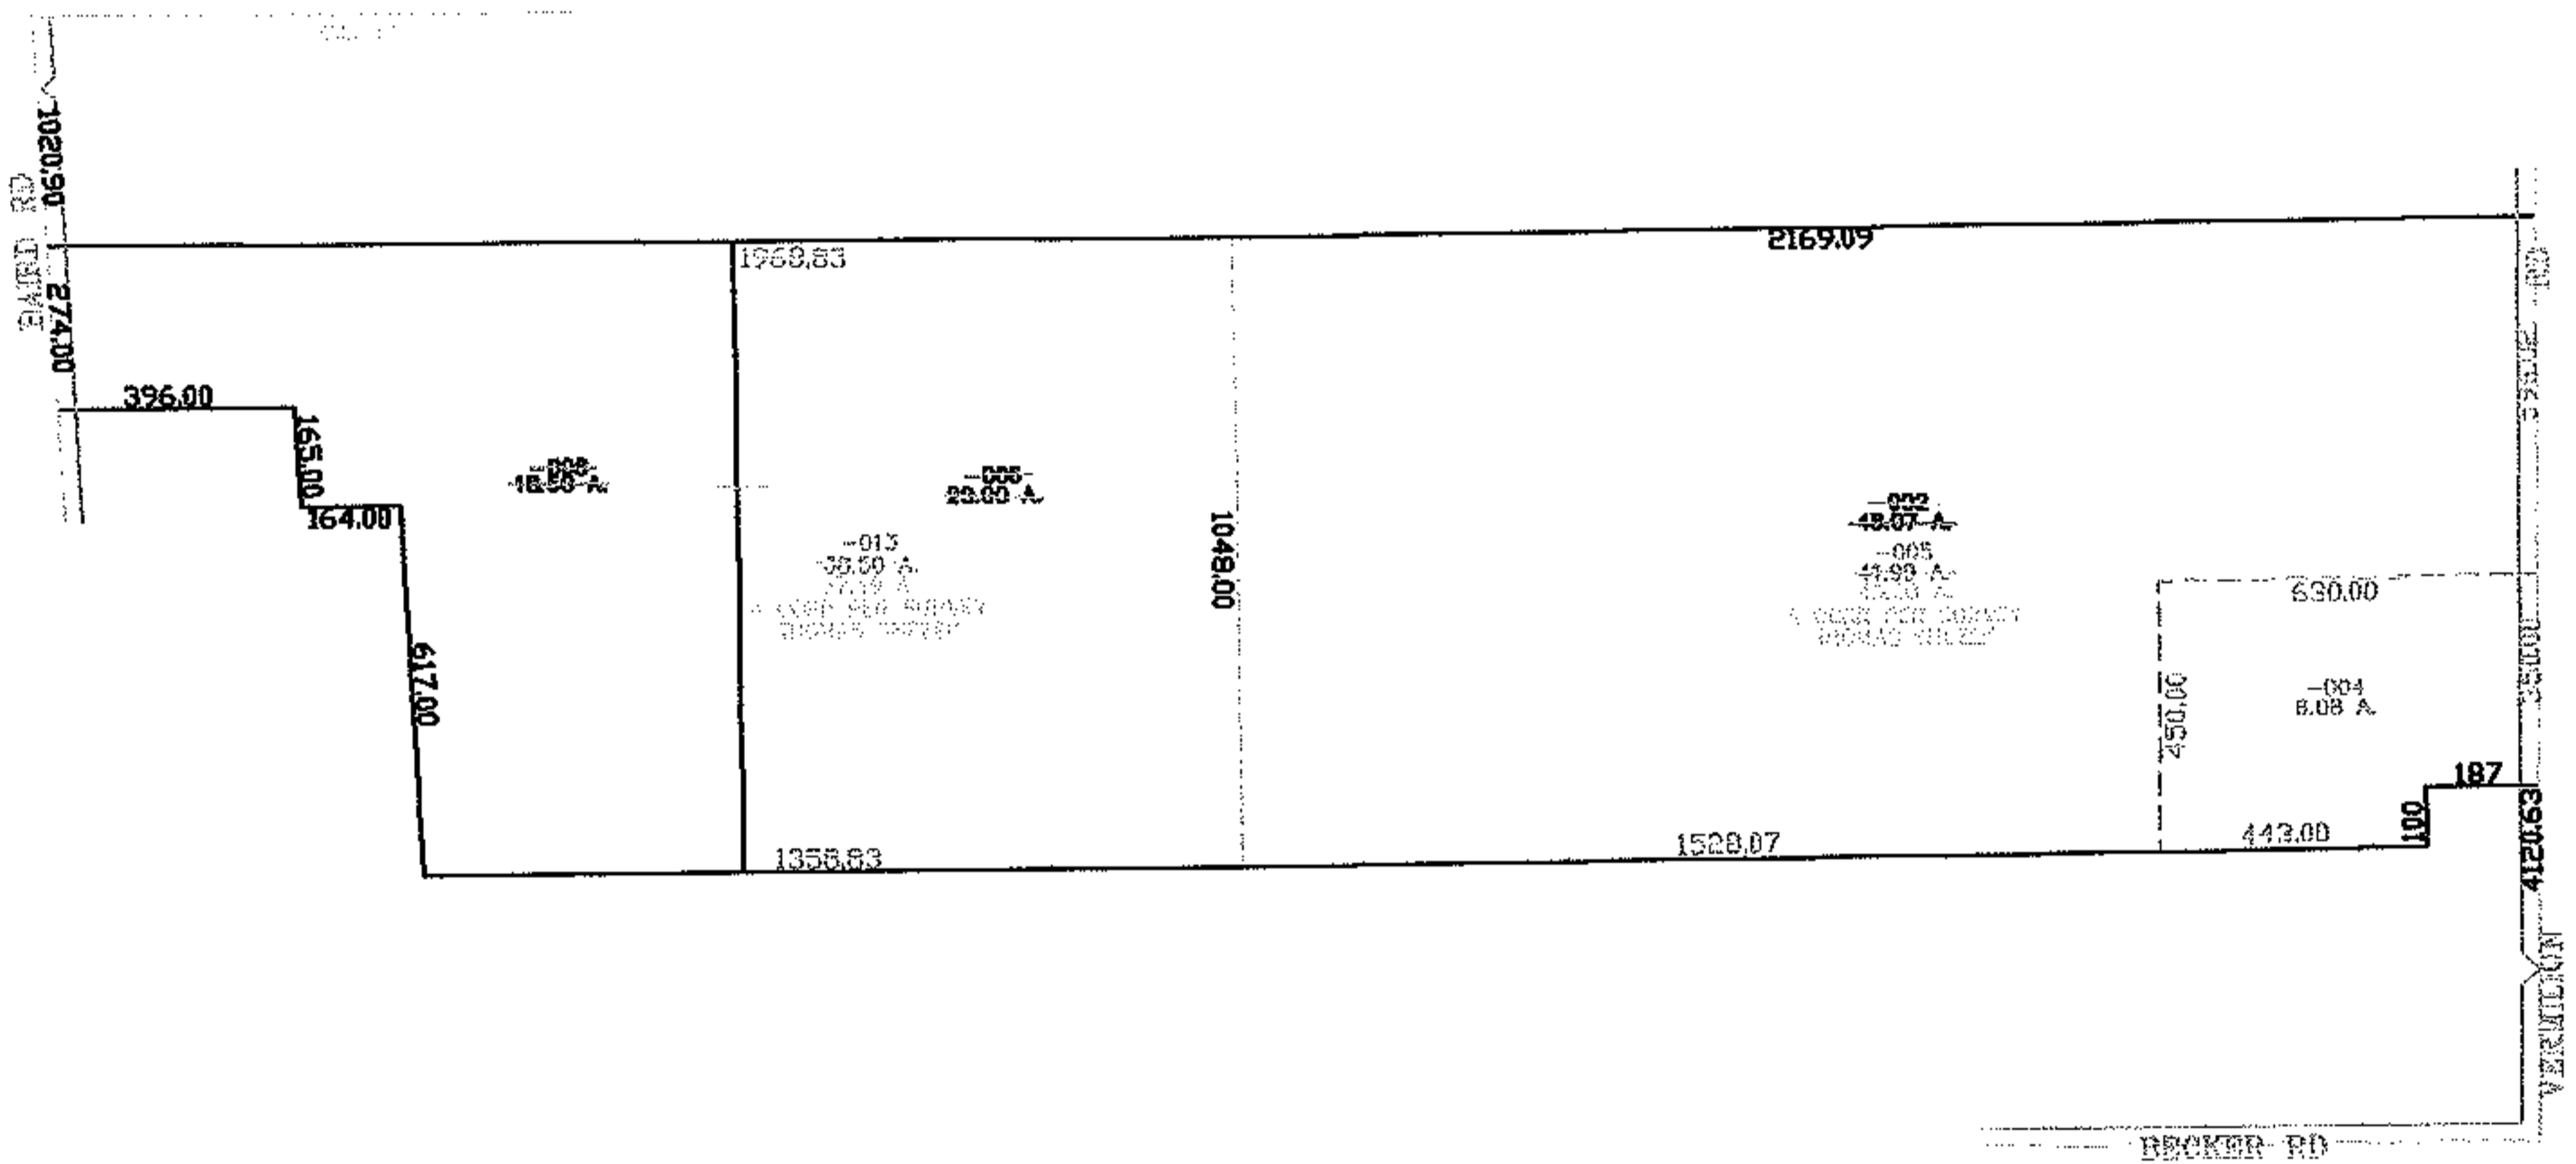


PARENT PARCEL: 08-13-016-000-002, 08-13-017-000-006, -008

CHILD PARCEL: 08-13-016-000-004, -005 08-13-017-000-013

STARTING POINT: CENTERLINE OF BECKER RD & VERMILION RD

08 02514

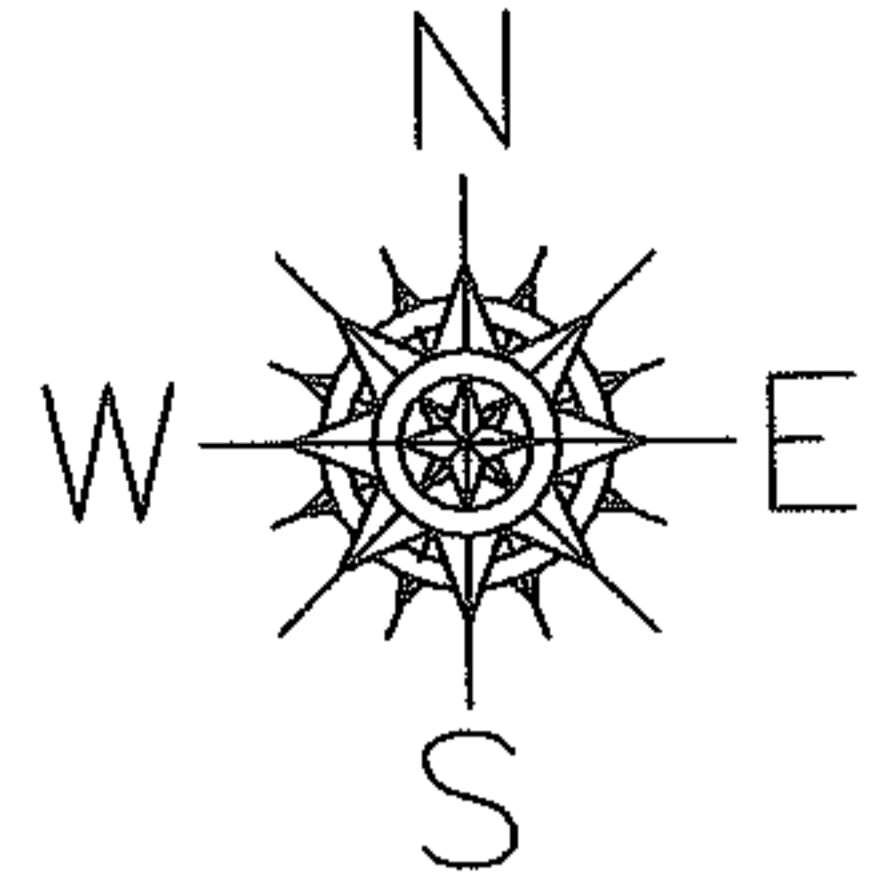

**SPLITS/DEEDS PROCESSED**

LORAIN COUNTY TAX MAP DEPARTMENT  
226 MIDDLE AVE. ELYRIA, OHIO

SURVEYED BY: THOMAS SNEZEK

CLOSURE: 0.00 : 10.000

MAP PAGE(S): 08-13-016

APPROVED BY: JAH DATE: 1-10-08

SCALE: 1" = 600 PRIOR INSTRUMENT: OR 263/330