
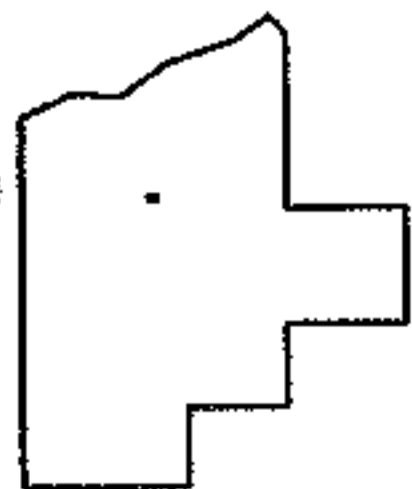
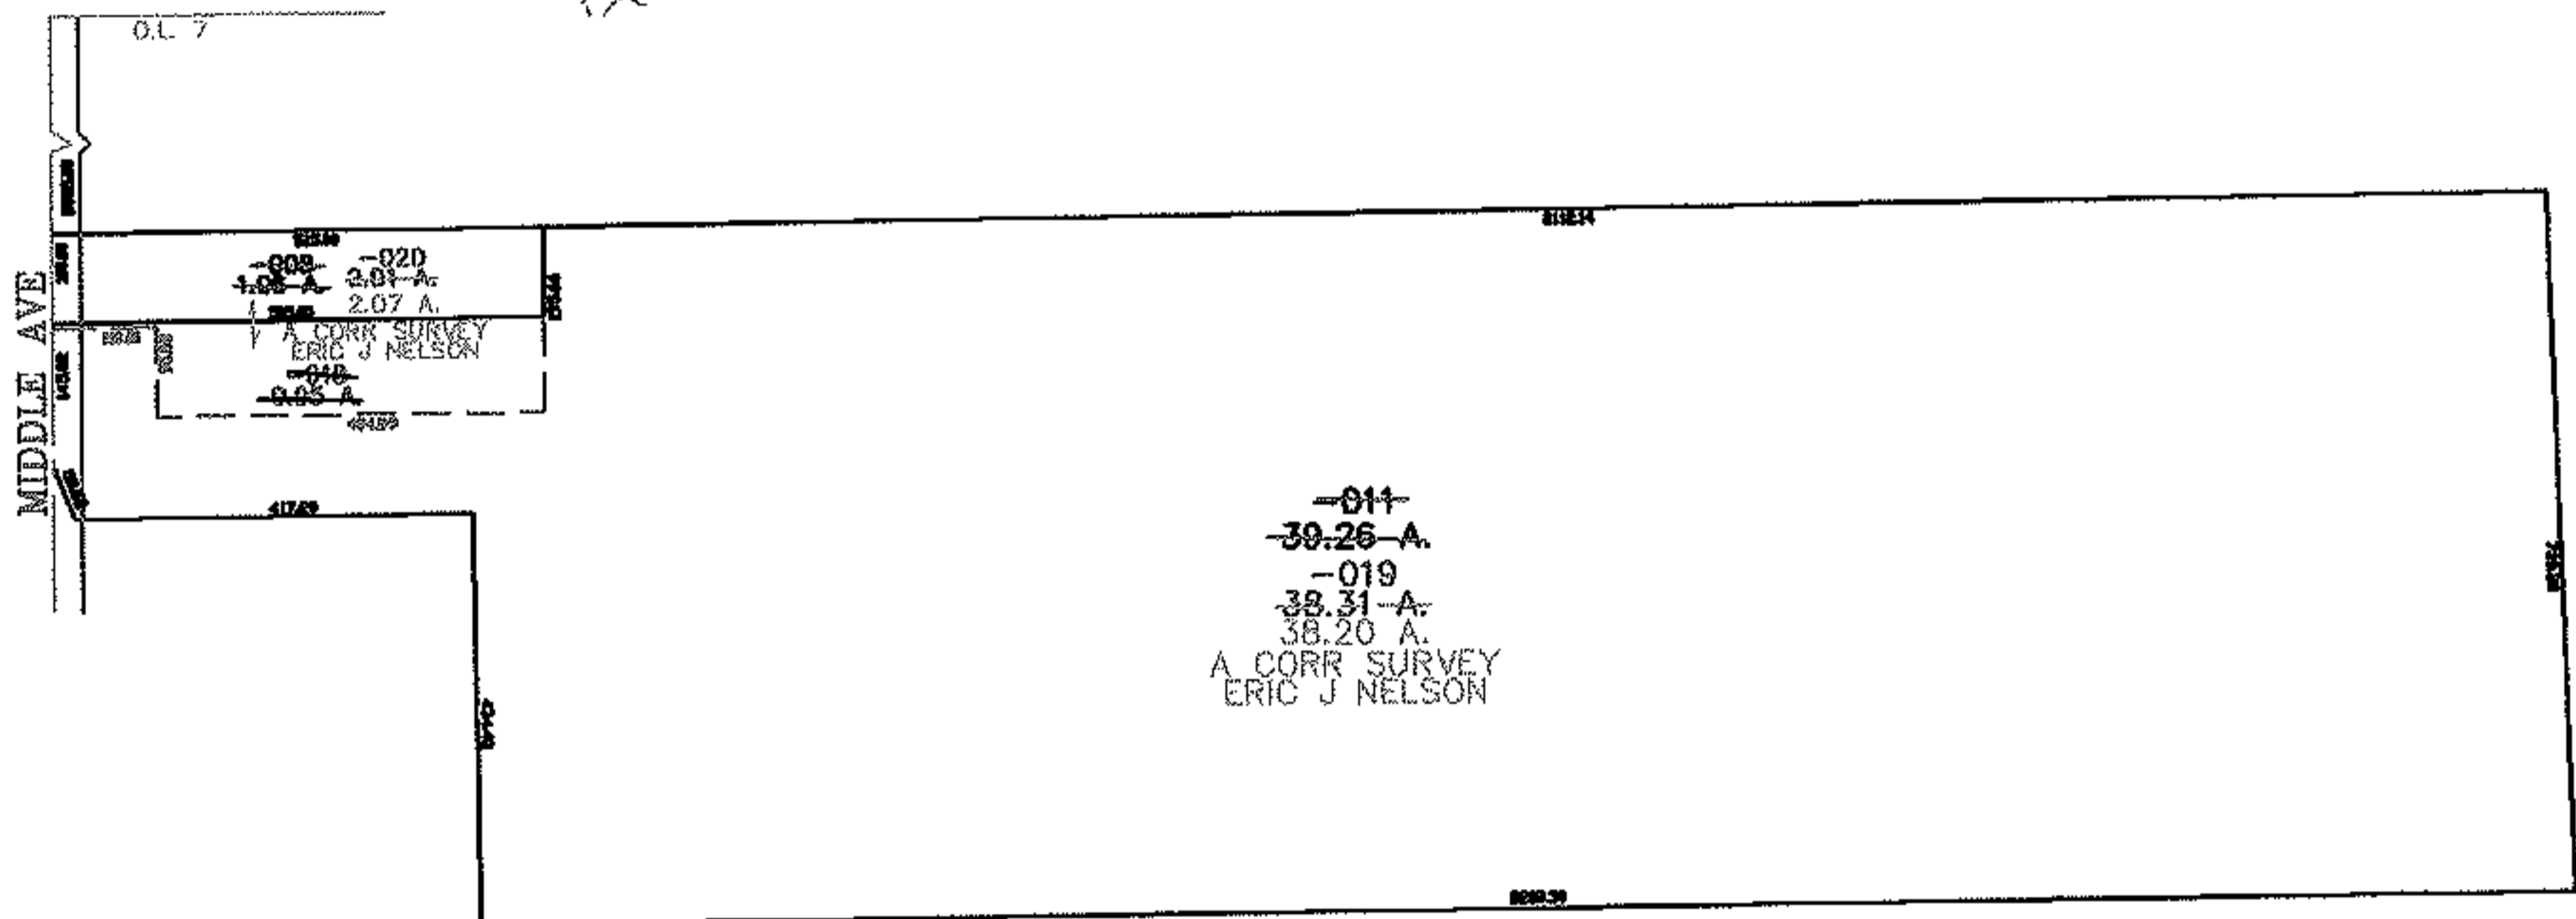


PARENT PARCEL: 10-00-007-101-011, -008

CHILD PARCEL: 10-00-007-101-018 THRU -020

STARTING POINT: CENTERLINE OF MIDDLE AVE & O.L. 7

08-02515

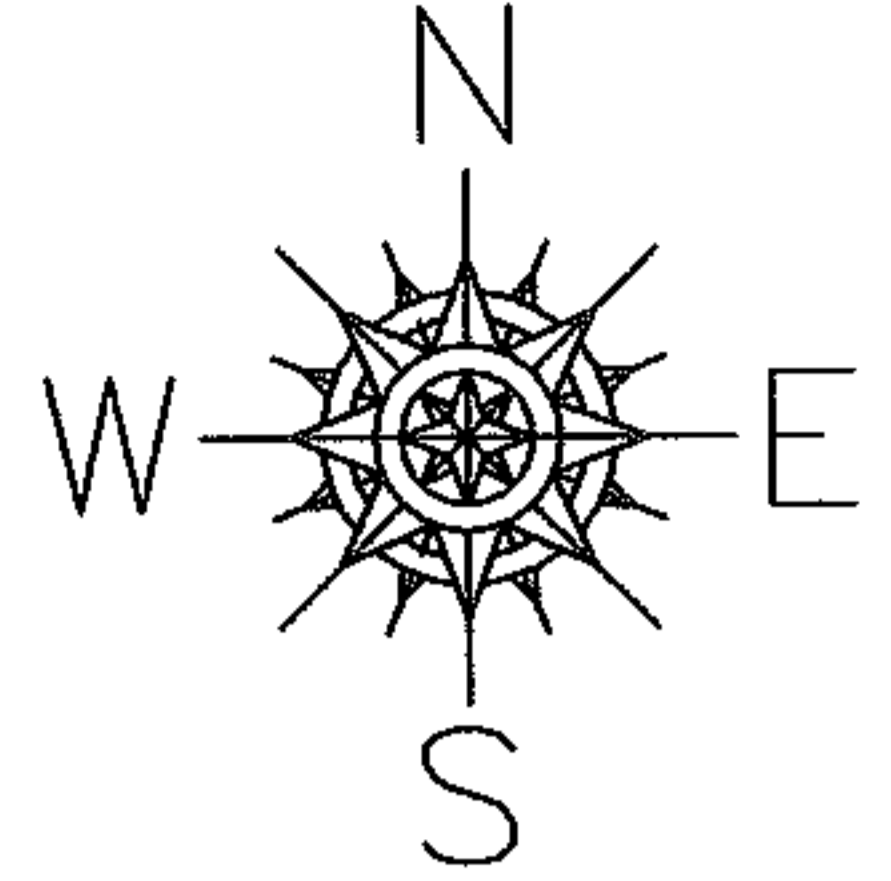

SPLITS/DEEDS PROCESSED

LORAIN COUNTY TAX MAP DEPARTMENT
226 MIDDLE AVE. ELYRIA, OHIO

SURVEYED BY: ERIC J NELSON

CLOSURE: 0.00 : 10.000

MAP PAGE(S): 10-00-007-A

APPROVED BY: JAH DATE: 1-17-08

SCALE: 1" = 400 PRIOR INSTRUMENT: 20070185180