


PARENT PARCEL: 04-00-026-110-030

CHILD PARCEL: XX-XX-XXX-XXX-XXX


STARTING POINT: CL OF SCHWARTZ RD. & CL OF WILLIAMS CT.

12-02517-C

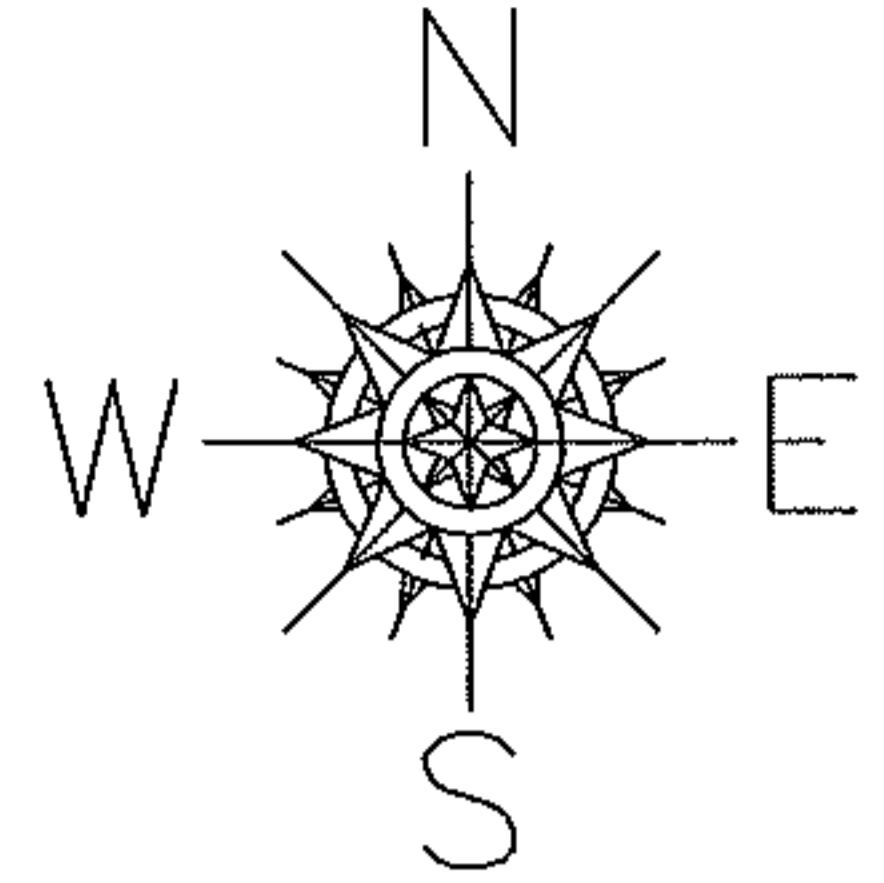

SCHWARTZ RD. 60'

WILLIAMS CT. 30'

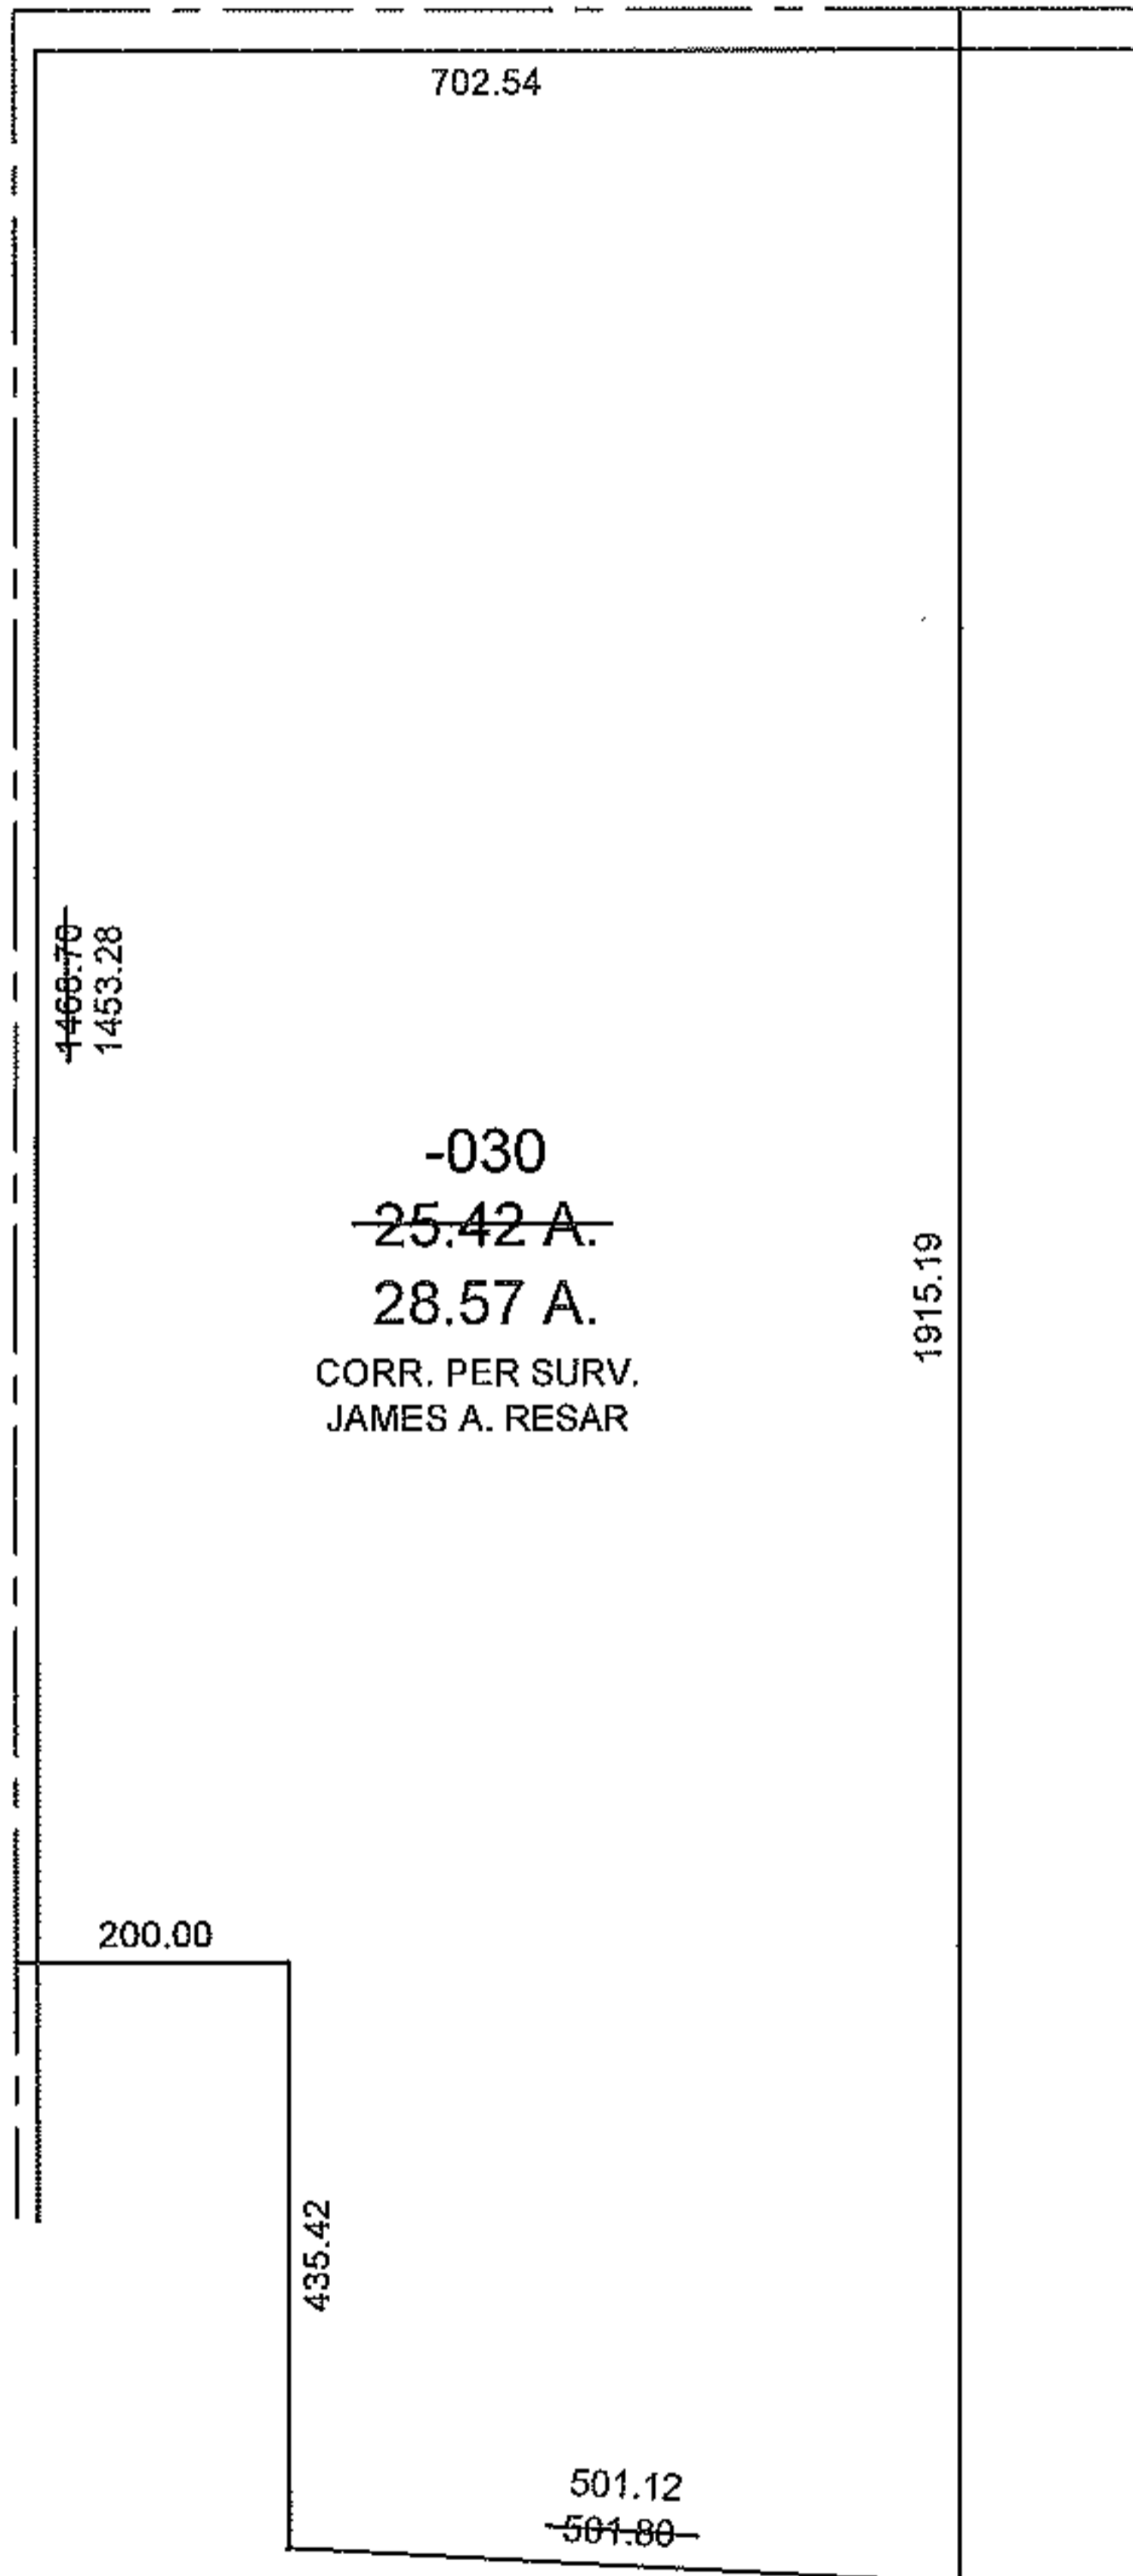

-030
~~25.42 A.~~
28.57 A.
CORR. PER SURV.
JAMES A. RESAR

ACREAGE CORRECTION

04-00-026-110-030

~~25.42 A.~~

28.57 A.

SPLITS/DEEDS PROCESSED

LORAIN COUNTY TAX MAP DEPARTMENT
226 MIDDLE AVE. ELYRIA, OHIO

SURVEYED BY: JAMES A. RESAR

CLOSURE: 0.00 : 10,000

MAP PAGE(S): 4-00-026-G

APPROVED BY: TJS DATE: 5/29/12

SCALE: 1"= 300 PRIOR INST.: OR 1018/307