


RASTER

PARENT PARCEL: 07-00-004-108-083

CHILD PARCEL: 07-00-004-108-096 THRU -098

STARTING POINT: CENTERLINE OF CHESTNUT RIDGE RD & LEAR NAGLE RD

08-02517

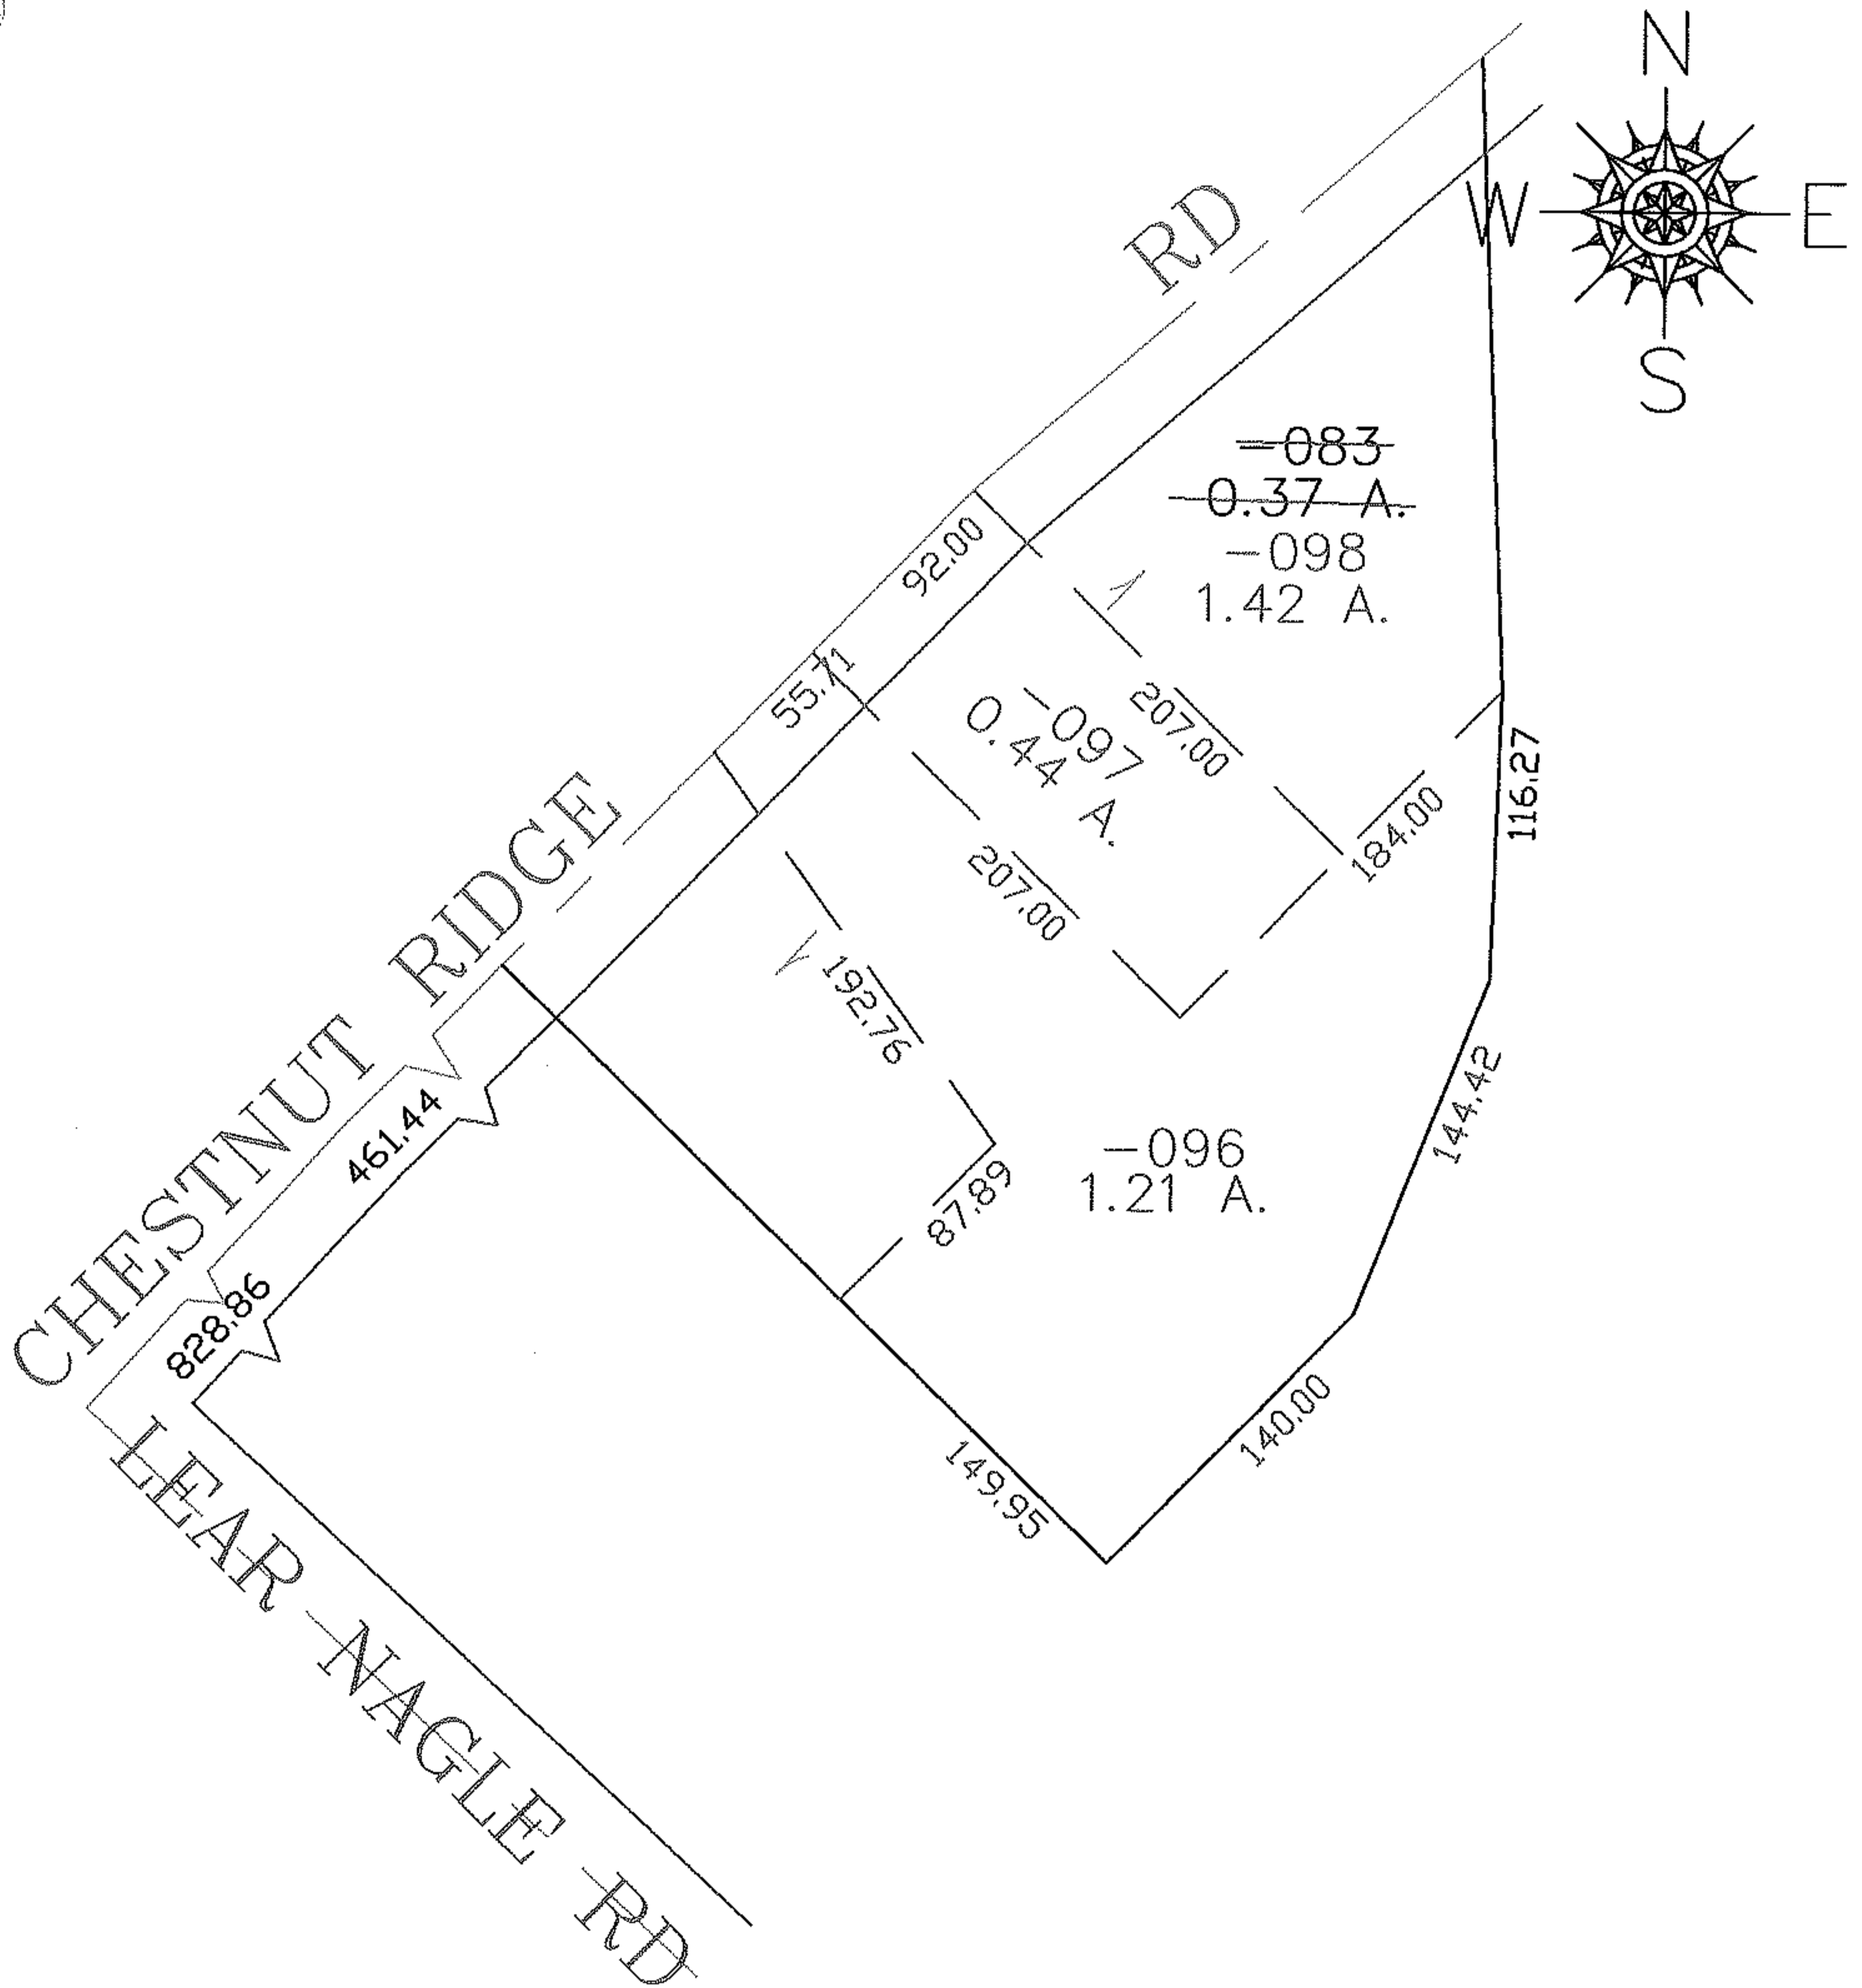

SPLITS/DEEDS PROCESSED

LORAIN COUNTY TAX MAP DEPARTMENT
226 MIDDLE AVE. ELYRIA, OHIO

SURVEYED BY: JAMES RESAR

CLOSURE: 0.00 : 10.000

MAP PAGE(S): 07-00-004-A

APPROVED BY: JAH DATE: 1-30-08

SCALE: 1" = 100 PRIOR INSTRUMENT: 20070232689