
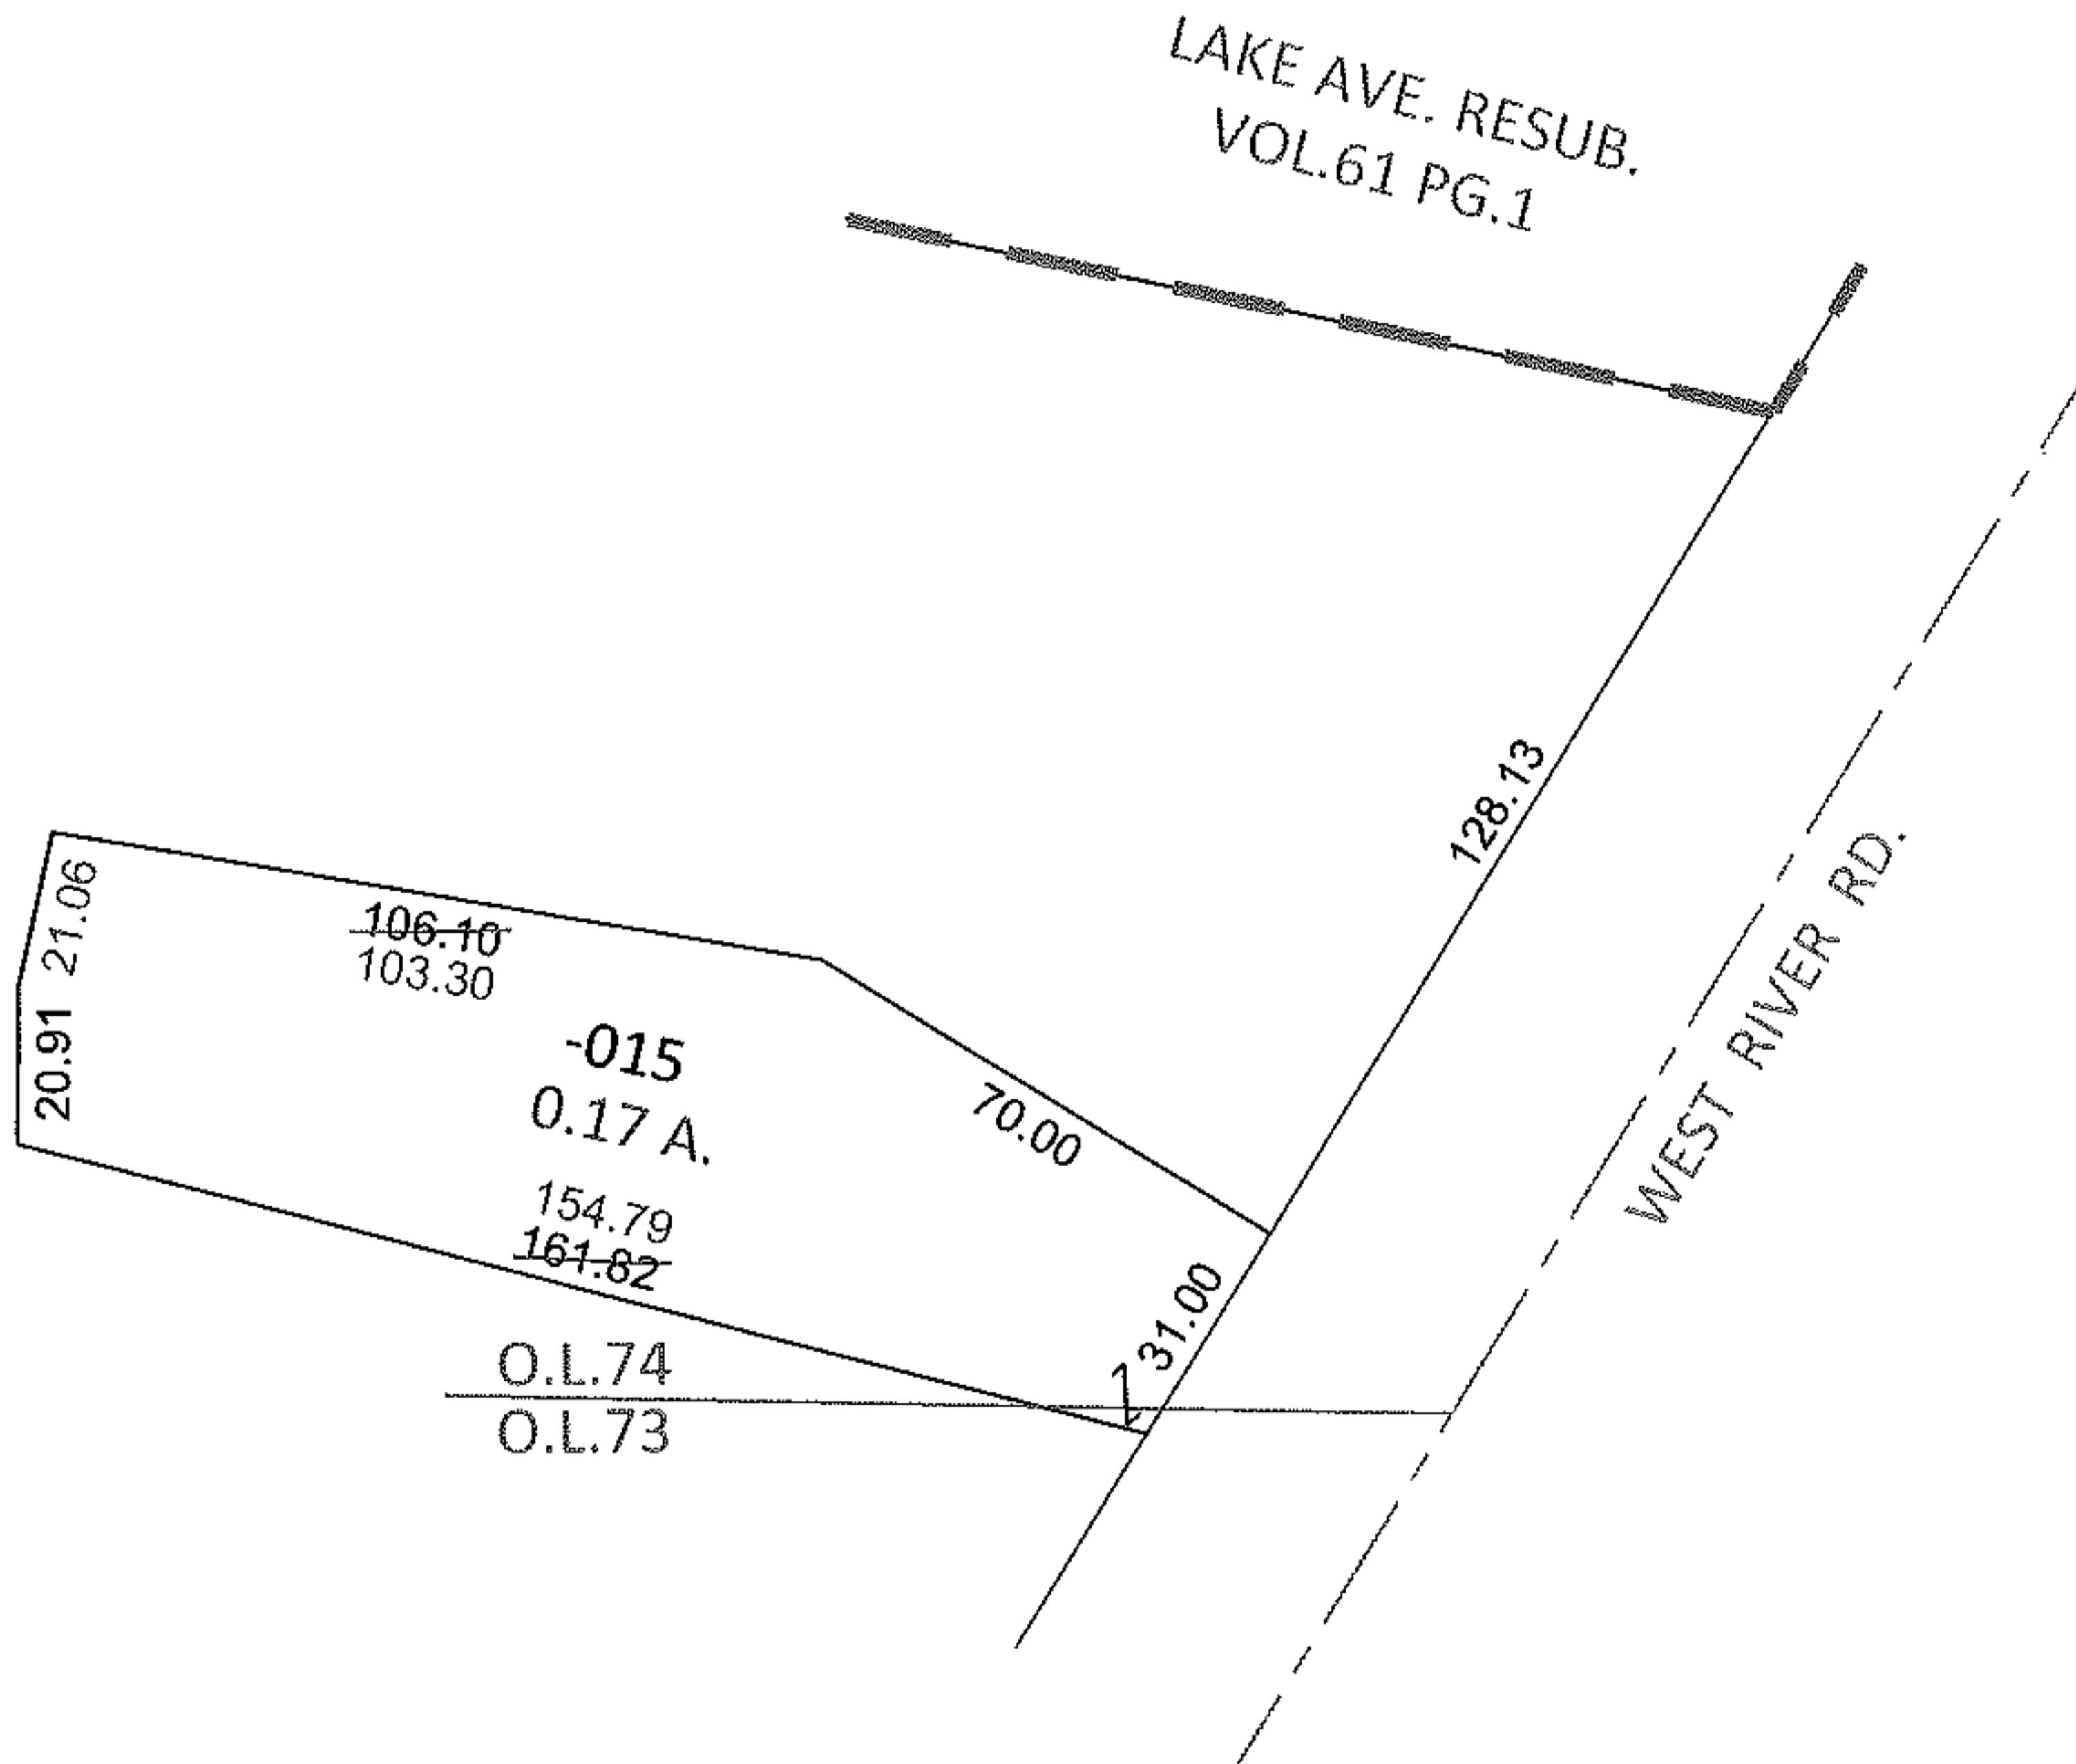


PARENT PARCEL: 06-24-074-000-015

CHILD PARCEL: _____

STARTING POINT: SOUTHEAST CORNER OF S/L 2 IN LAKE AVE. RESUB.(VOL.61 PG.1)

12-02518-D

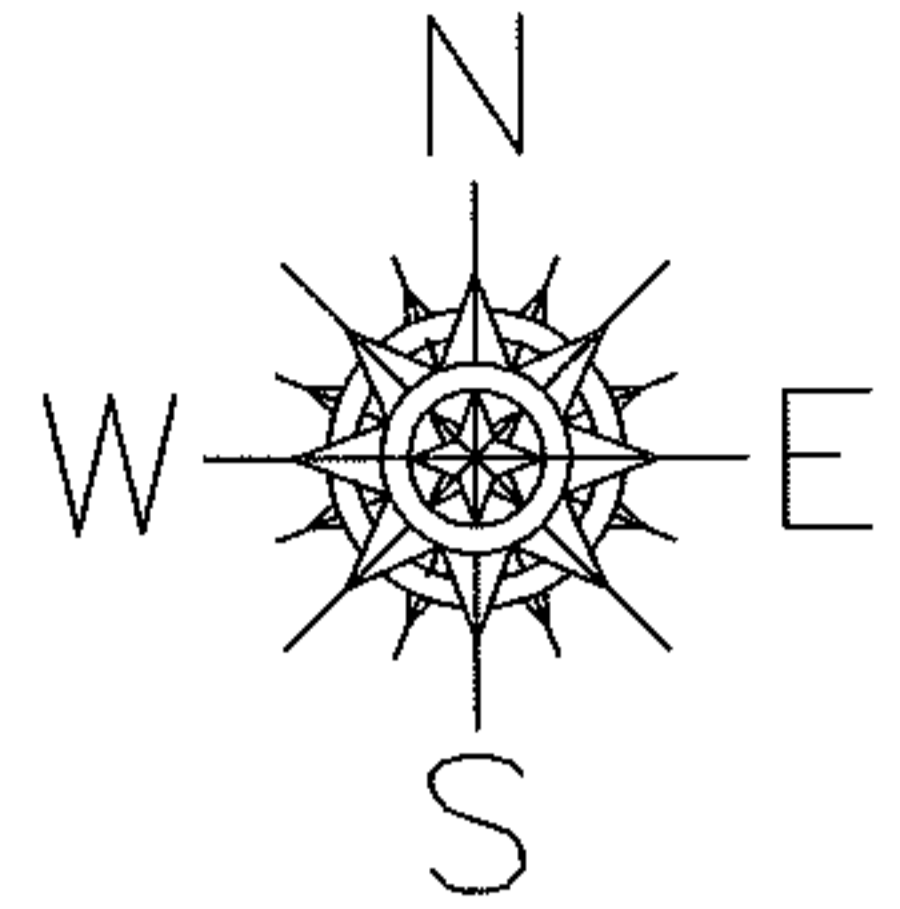


FRONTAGE AND DEPTH TO ACERAGE CORRECTION

06-24-074-000-015

0.17 A.

~~31 X 176.10~~

PER SURV. E. SHORT

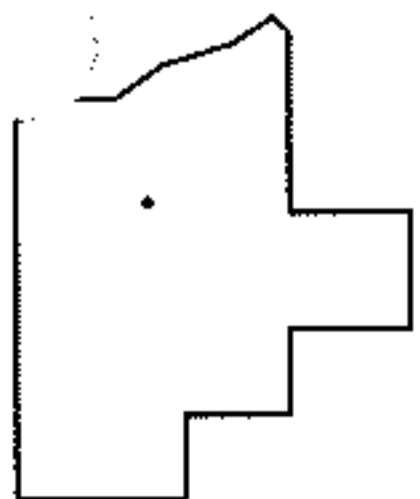

SPLITS/DEEDS PROCESSED

LORAIN COUNTY TAX MAP DEPARTMENT
226 MIDDLE AVE. ELYRIA, OHIO

SURVEYED BY: ERIC W. SHORT

CLOSURE: .01:10,000

MAP PAGE(S): 6-100

APPROVED BY: RRM DATE: 6-8-12

SCALE: 1" = 50' PRIOR INST.: 20110387526