




RASTER

PARENT PARCEL: 04-00-011-107-175

CHILD PARCEL: 04-00-011-107-177, -178

STARTING POINT: CENTERLINE OF HARRIMAN TRAIL & STONEY RIDGE RD

08-02518

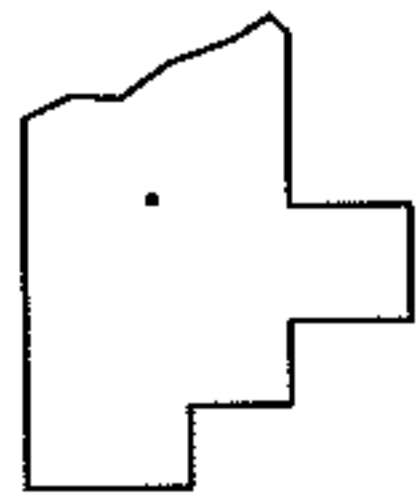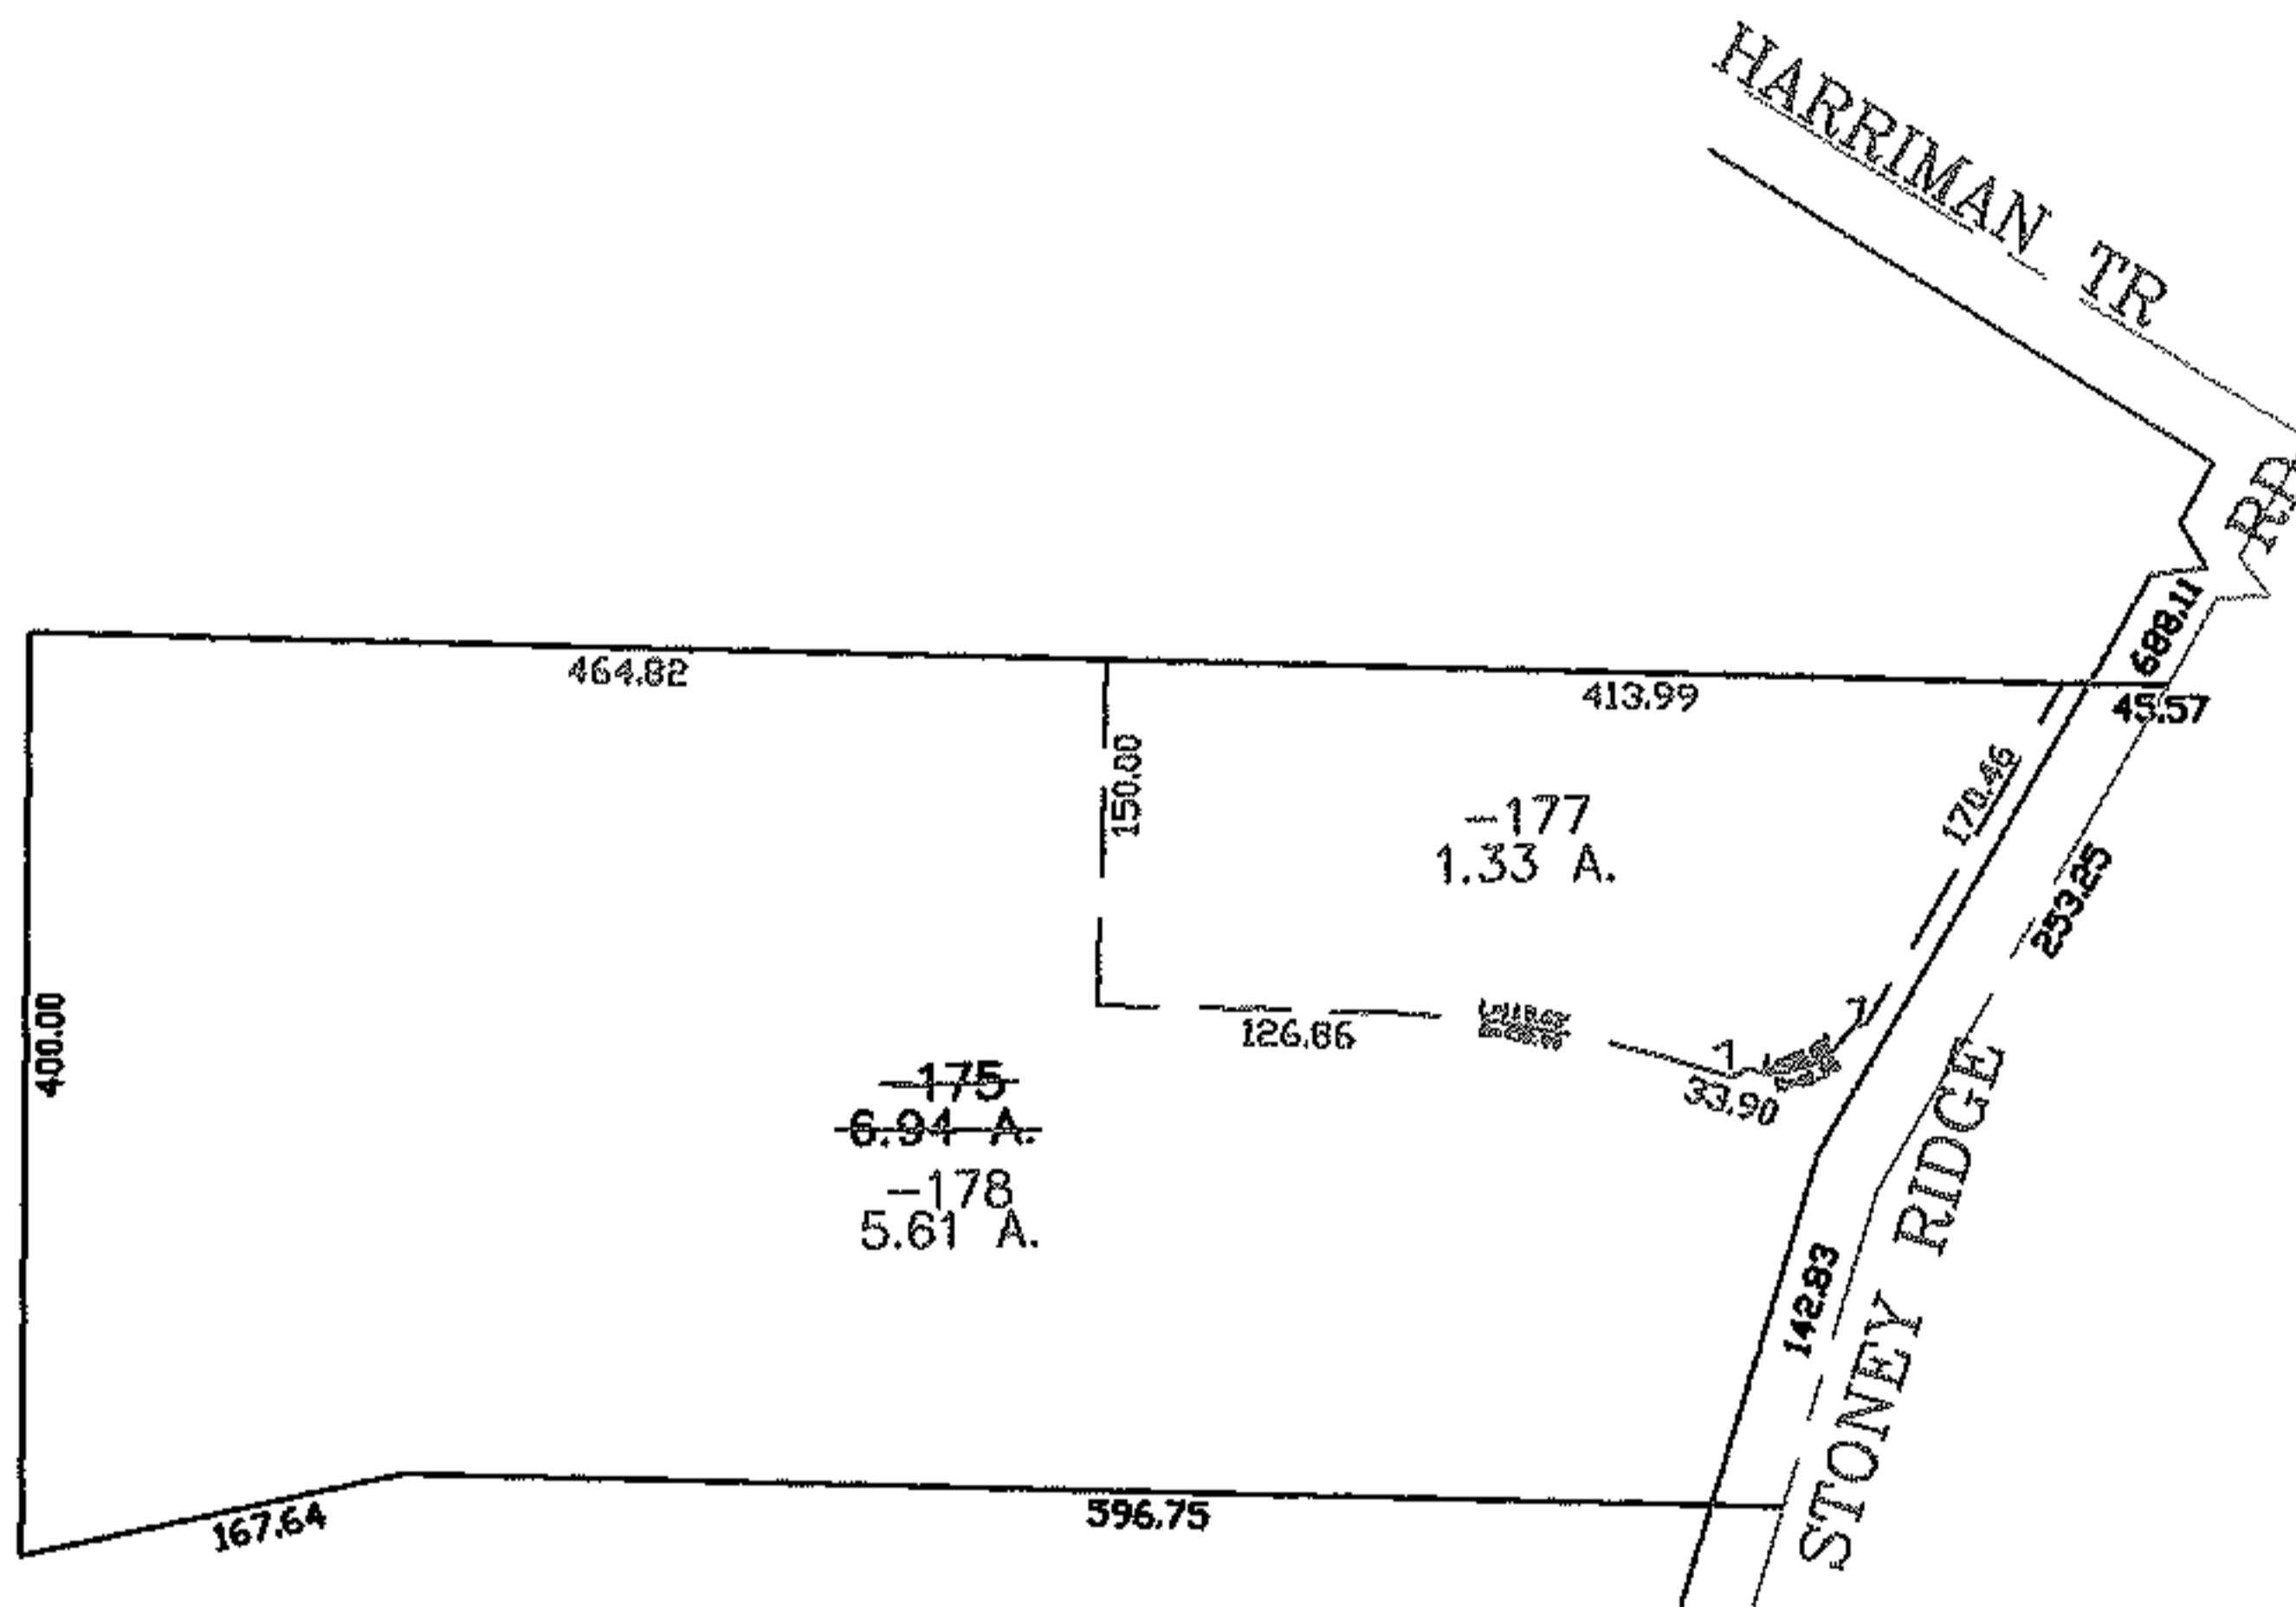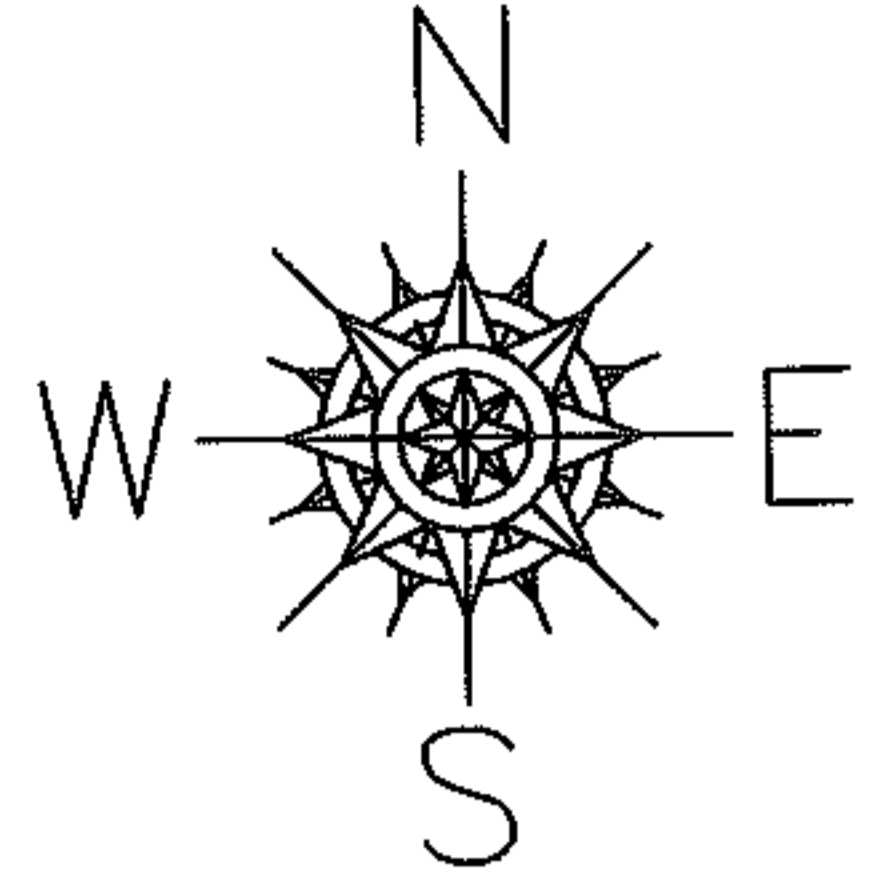

SPLITS/DEEDS PROCESSED

LORAIN COUNTY TAX MAP DEPARTMENT
226 MIDDLE AVE. ELYRIA, OHIO

SURVEYED BY: MICHAEL SPELLACY

CLOSURE: 0.00 : 10.000

MAP PAGE(S): 04-00-011-G

APPROVED BY: JAH DATE: 2-8-08

SCALE: 1" = 200 PRIOR INSTRUMENT: 20070217716