
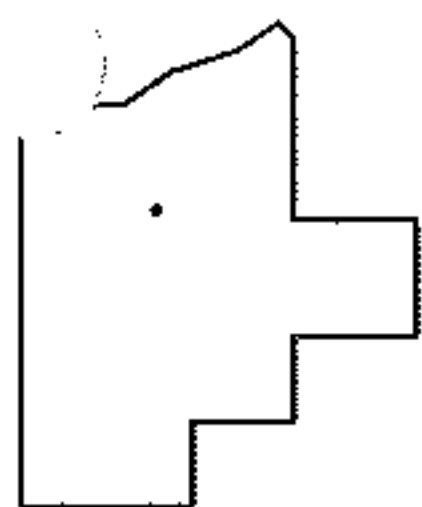
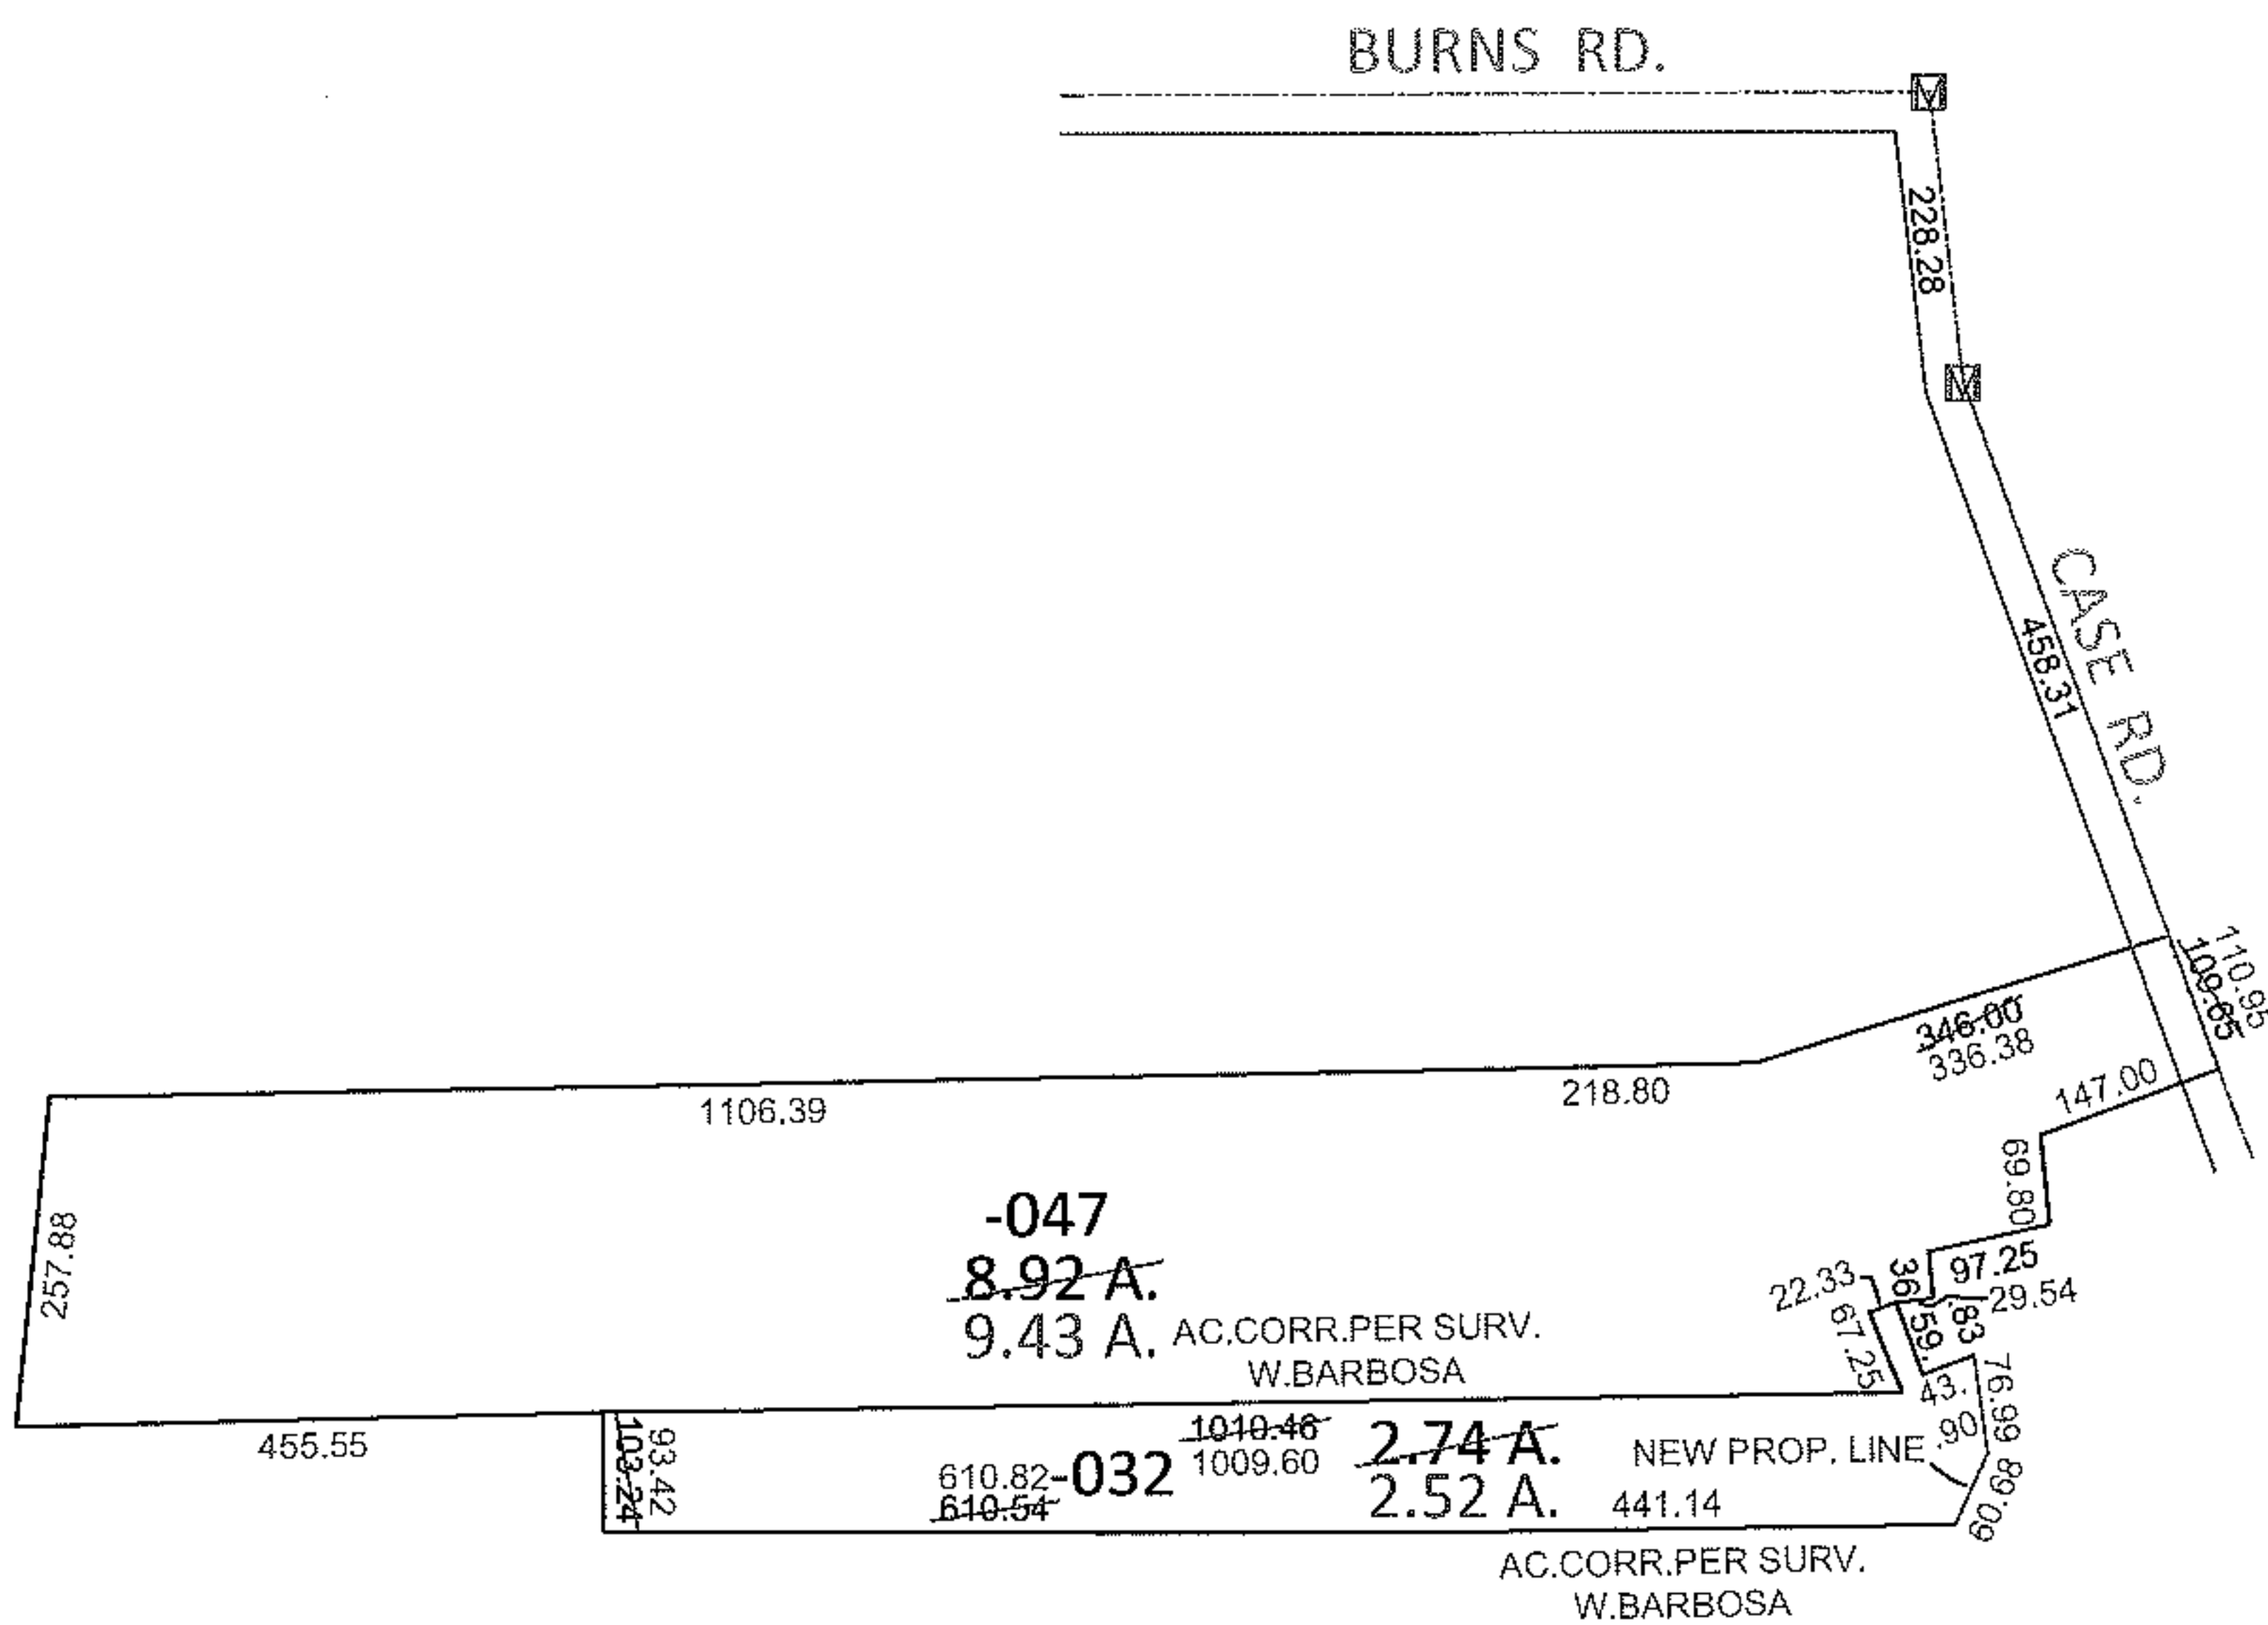


PARENT PARCEL: 07-00-044-102-032, -047

CHILD PARCEL: _____

12-02520-D

STARTING POINT: AT A MON BOX AT THE INTERSECTION OF C/L OF BURNS RD. AND C/L OF CASE RD.

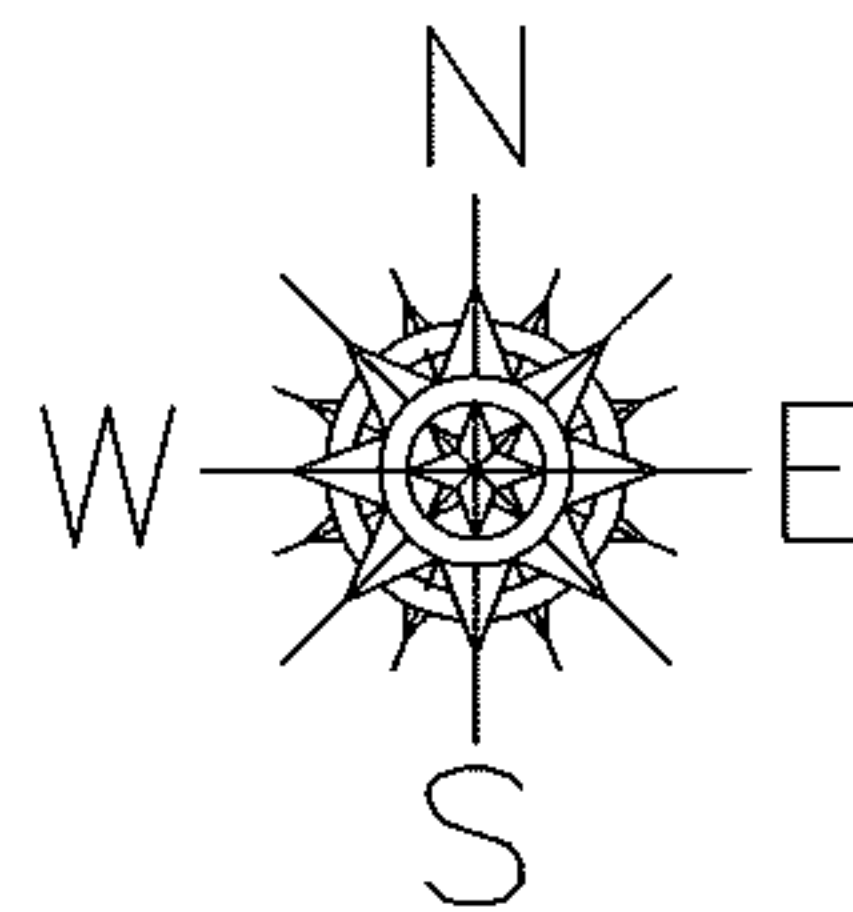

SPLITS/DEEDS PROCESSED

LORAIN COUNTY TAX MAP DEPARTMENT
226 MIDDLE AVE. ELYRIA, OHIO

SURVEYED BY: WILFREDO BARBOSA

CLOSURE: .01:10,000

MAP PAGE(S): 7-00-044-B & D

APPROVED BY: RRM DATE: 6-7-12

SCALE: 1" = 300 PRIOR INST.: 20090294901