
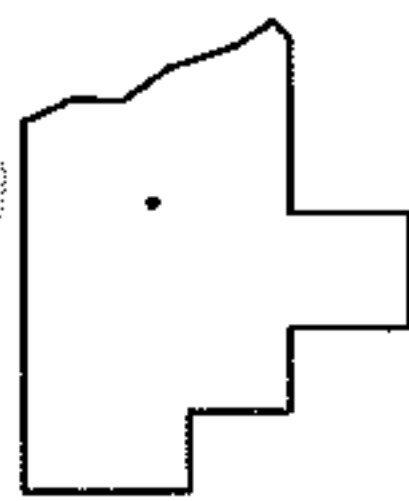
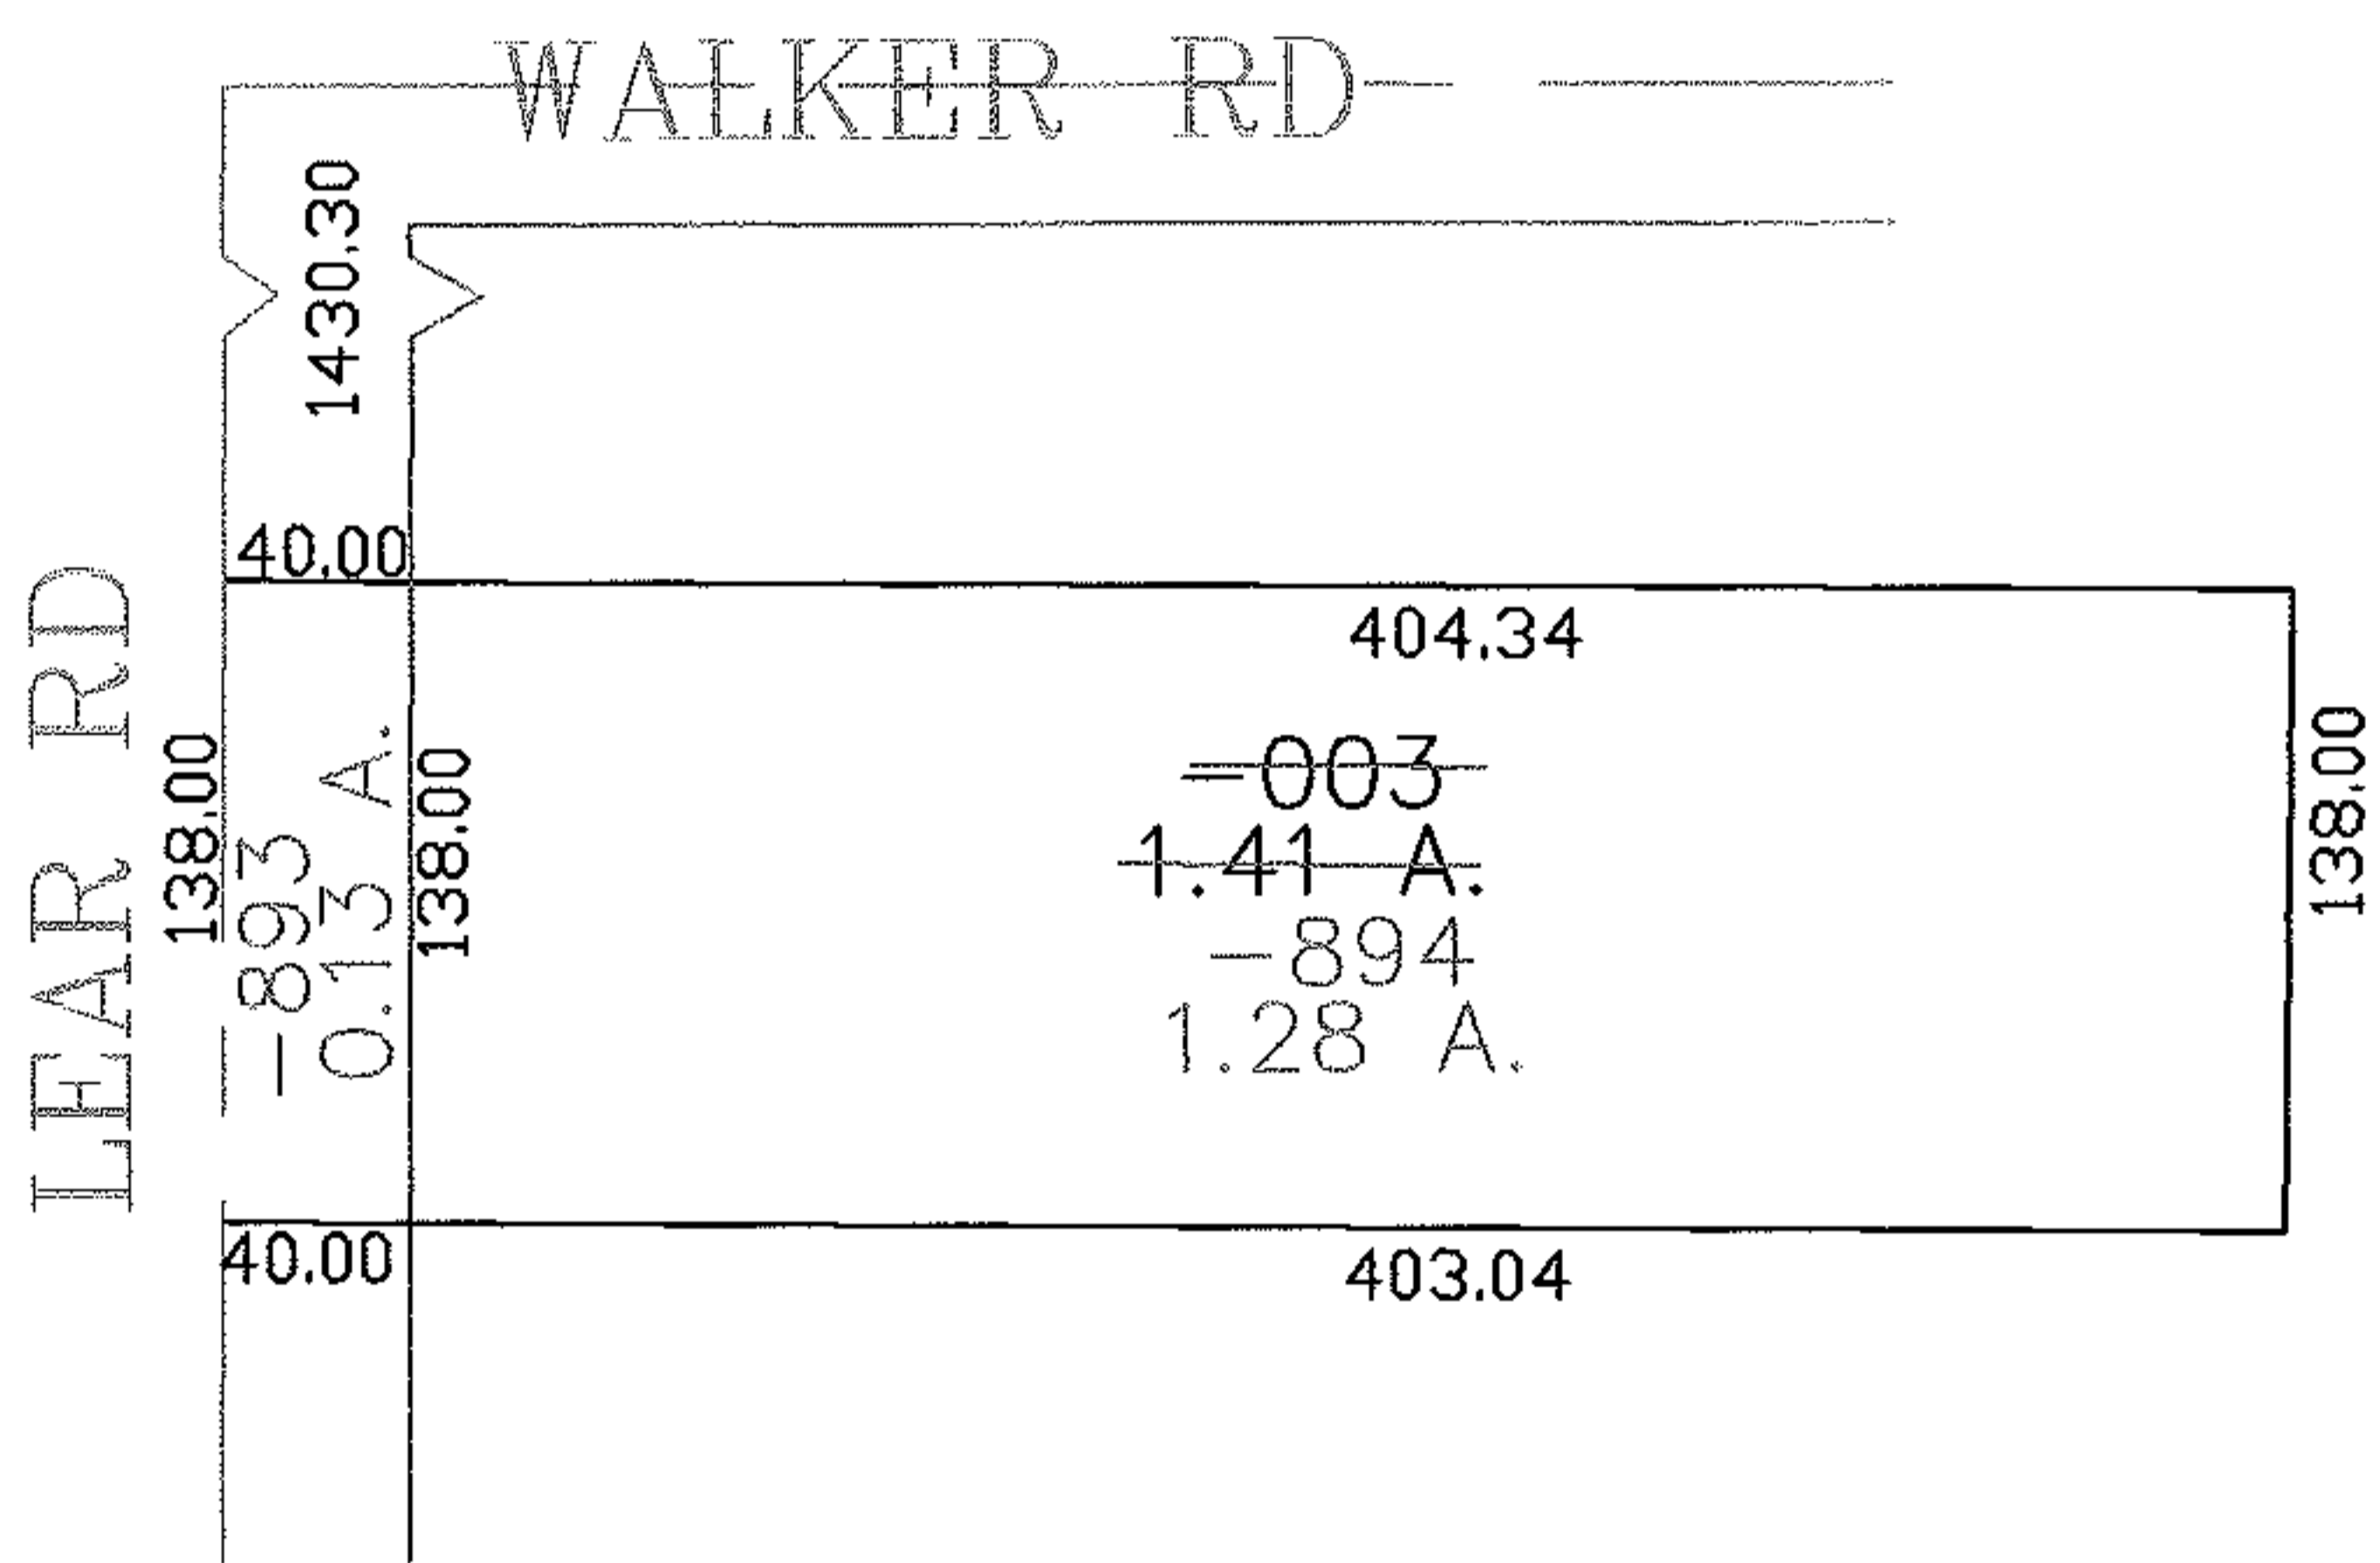


PARENT PARCEL: 04-00-029-000-003
CHILD PARCEL: 04-00-029-000-893, -894
STARTING POINT: CENTERLINE OF LEAR RD & WALKER RD

08-02520

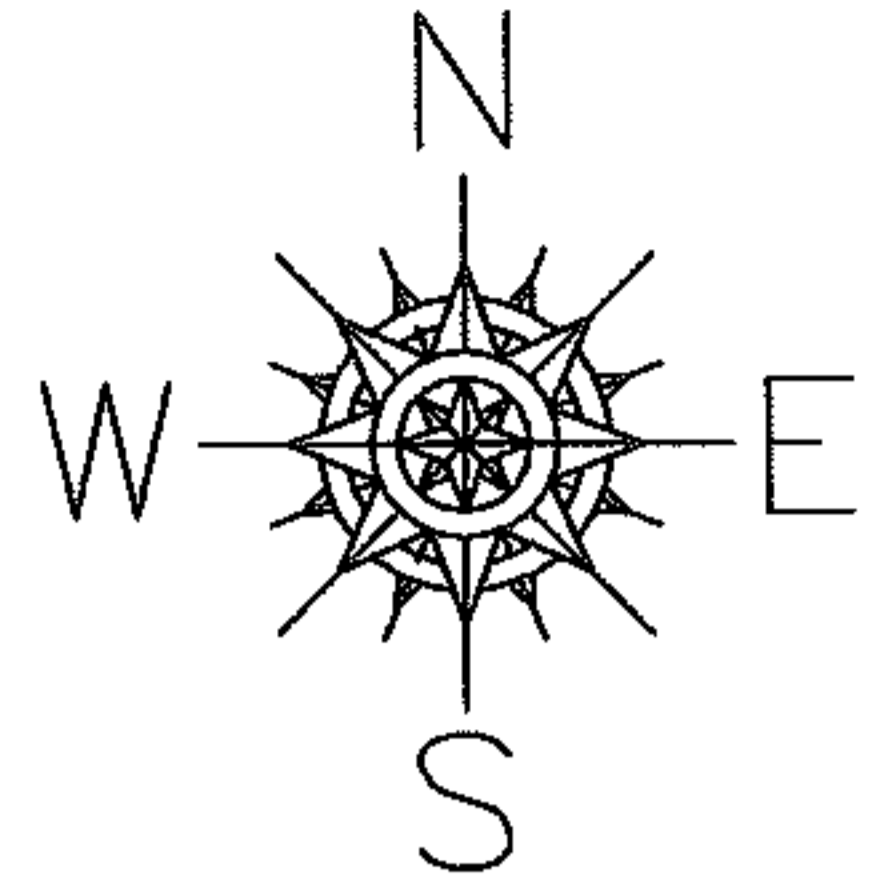

SPLITS/DEEDS PROCESSED

LORAIN COUNTY TAX MAP DEPARTMENT
226 MIDDLE AVE. ELYRIA, OHIO

SURVEYED BY: CHRISTOPHER HIRZEL
CLOSURE: 0.00 : 10.000
MAP PAGE(S): 04-00-029-A
APPROVED BY: JAH DATE: 1-29-08
SCALE: 1" = 100 PRIOR INSTRUMENT: 20040038575