
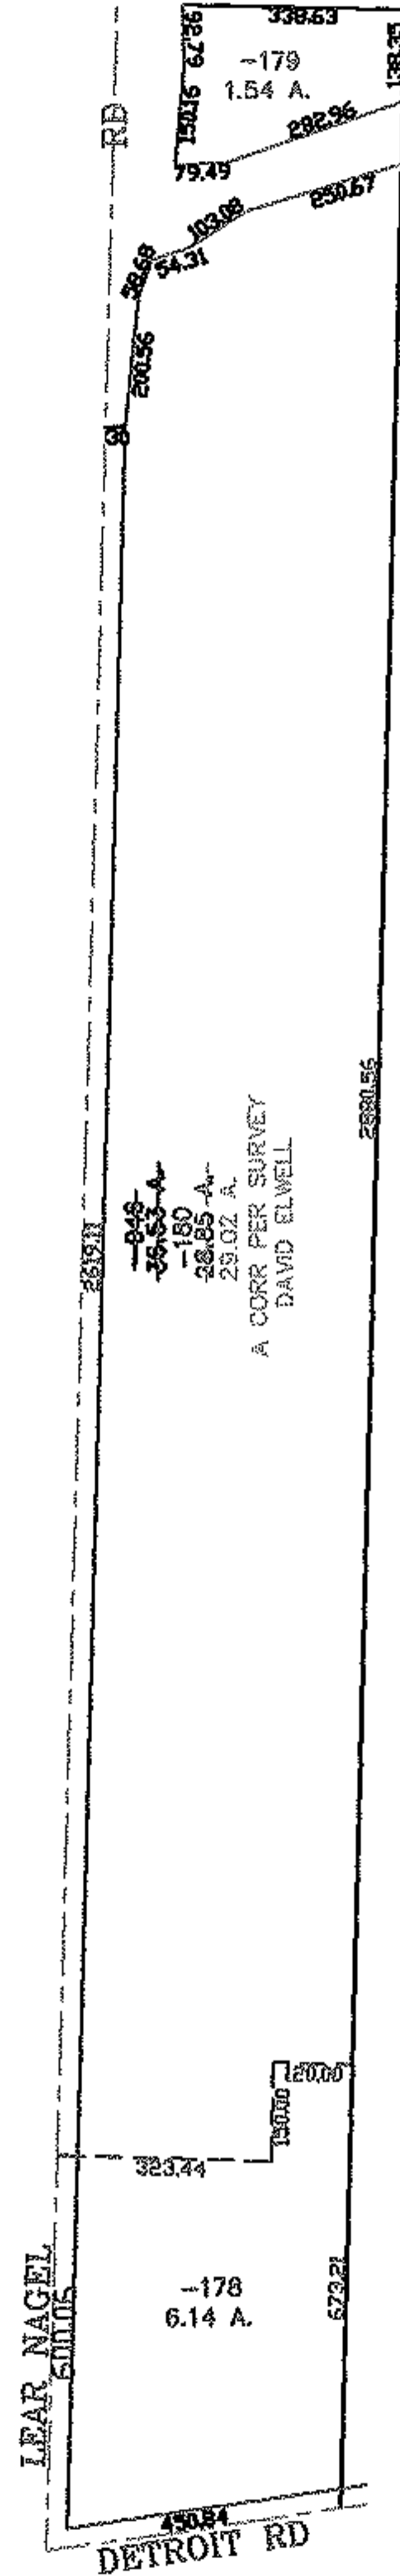


PARENT PARCEL: 04-00-027-101-046

CHILD PARCEL: 04-00-027-101-178 THRU -180

STARTING POINT: CENTERLINE OF DETROIT RD & LEAR NAGEL RD

08-02521

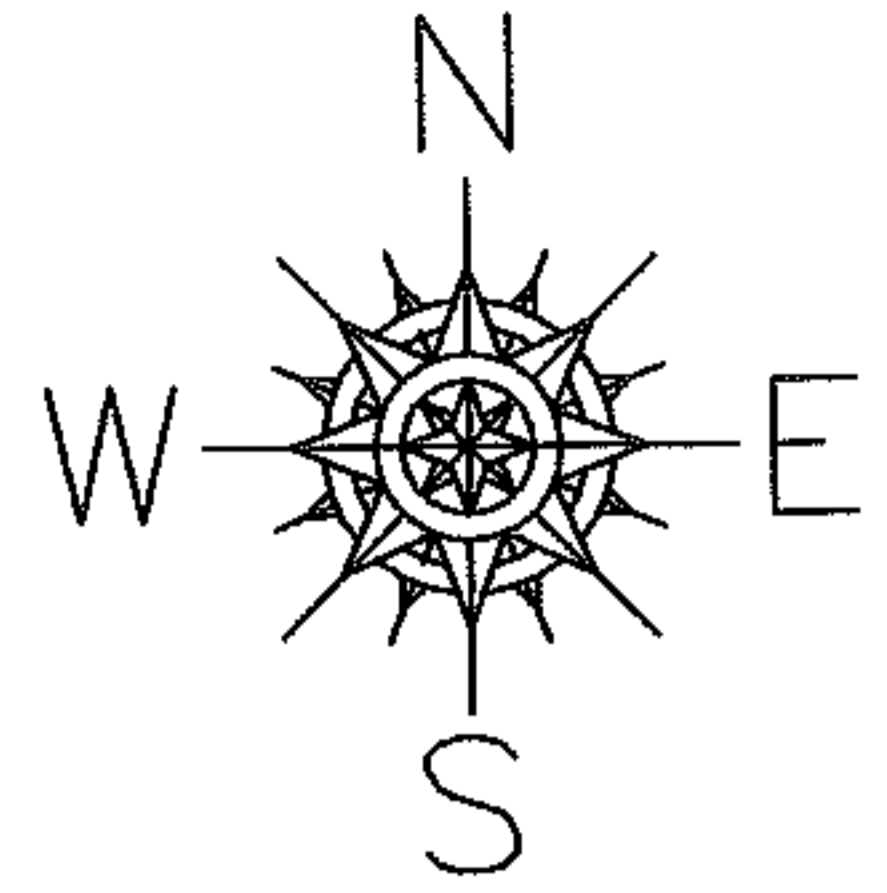

SURVEYED BY: DAVE ELWELL

CLOSURE: 0.00 : 10.000

MAP PAGE(S): 04-00-027-A

APPROVED BY: JAH DATE: 1-29-08

SCALE: 1" = 500 PRIOR INSTRUMENT: DV 314/505

SPLITS/DEEDS PROCESSED

LORAIN COUNTY TAX MAP DEPARTMENT
226 MIDDLE AVE. ELYRIA, OHIO

