
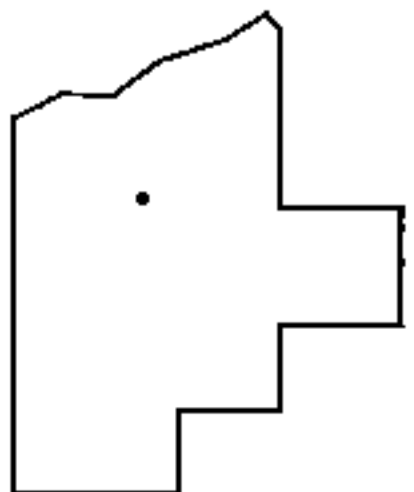
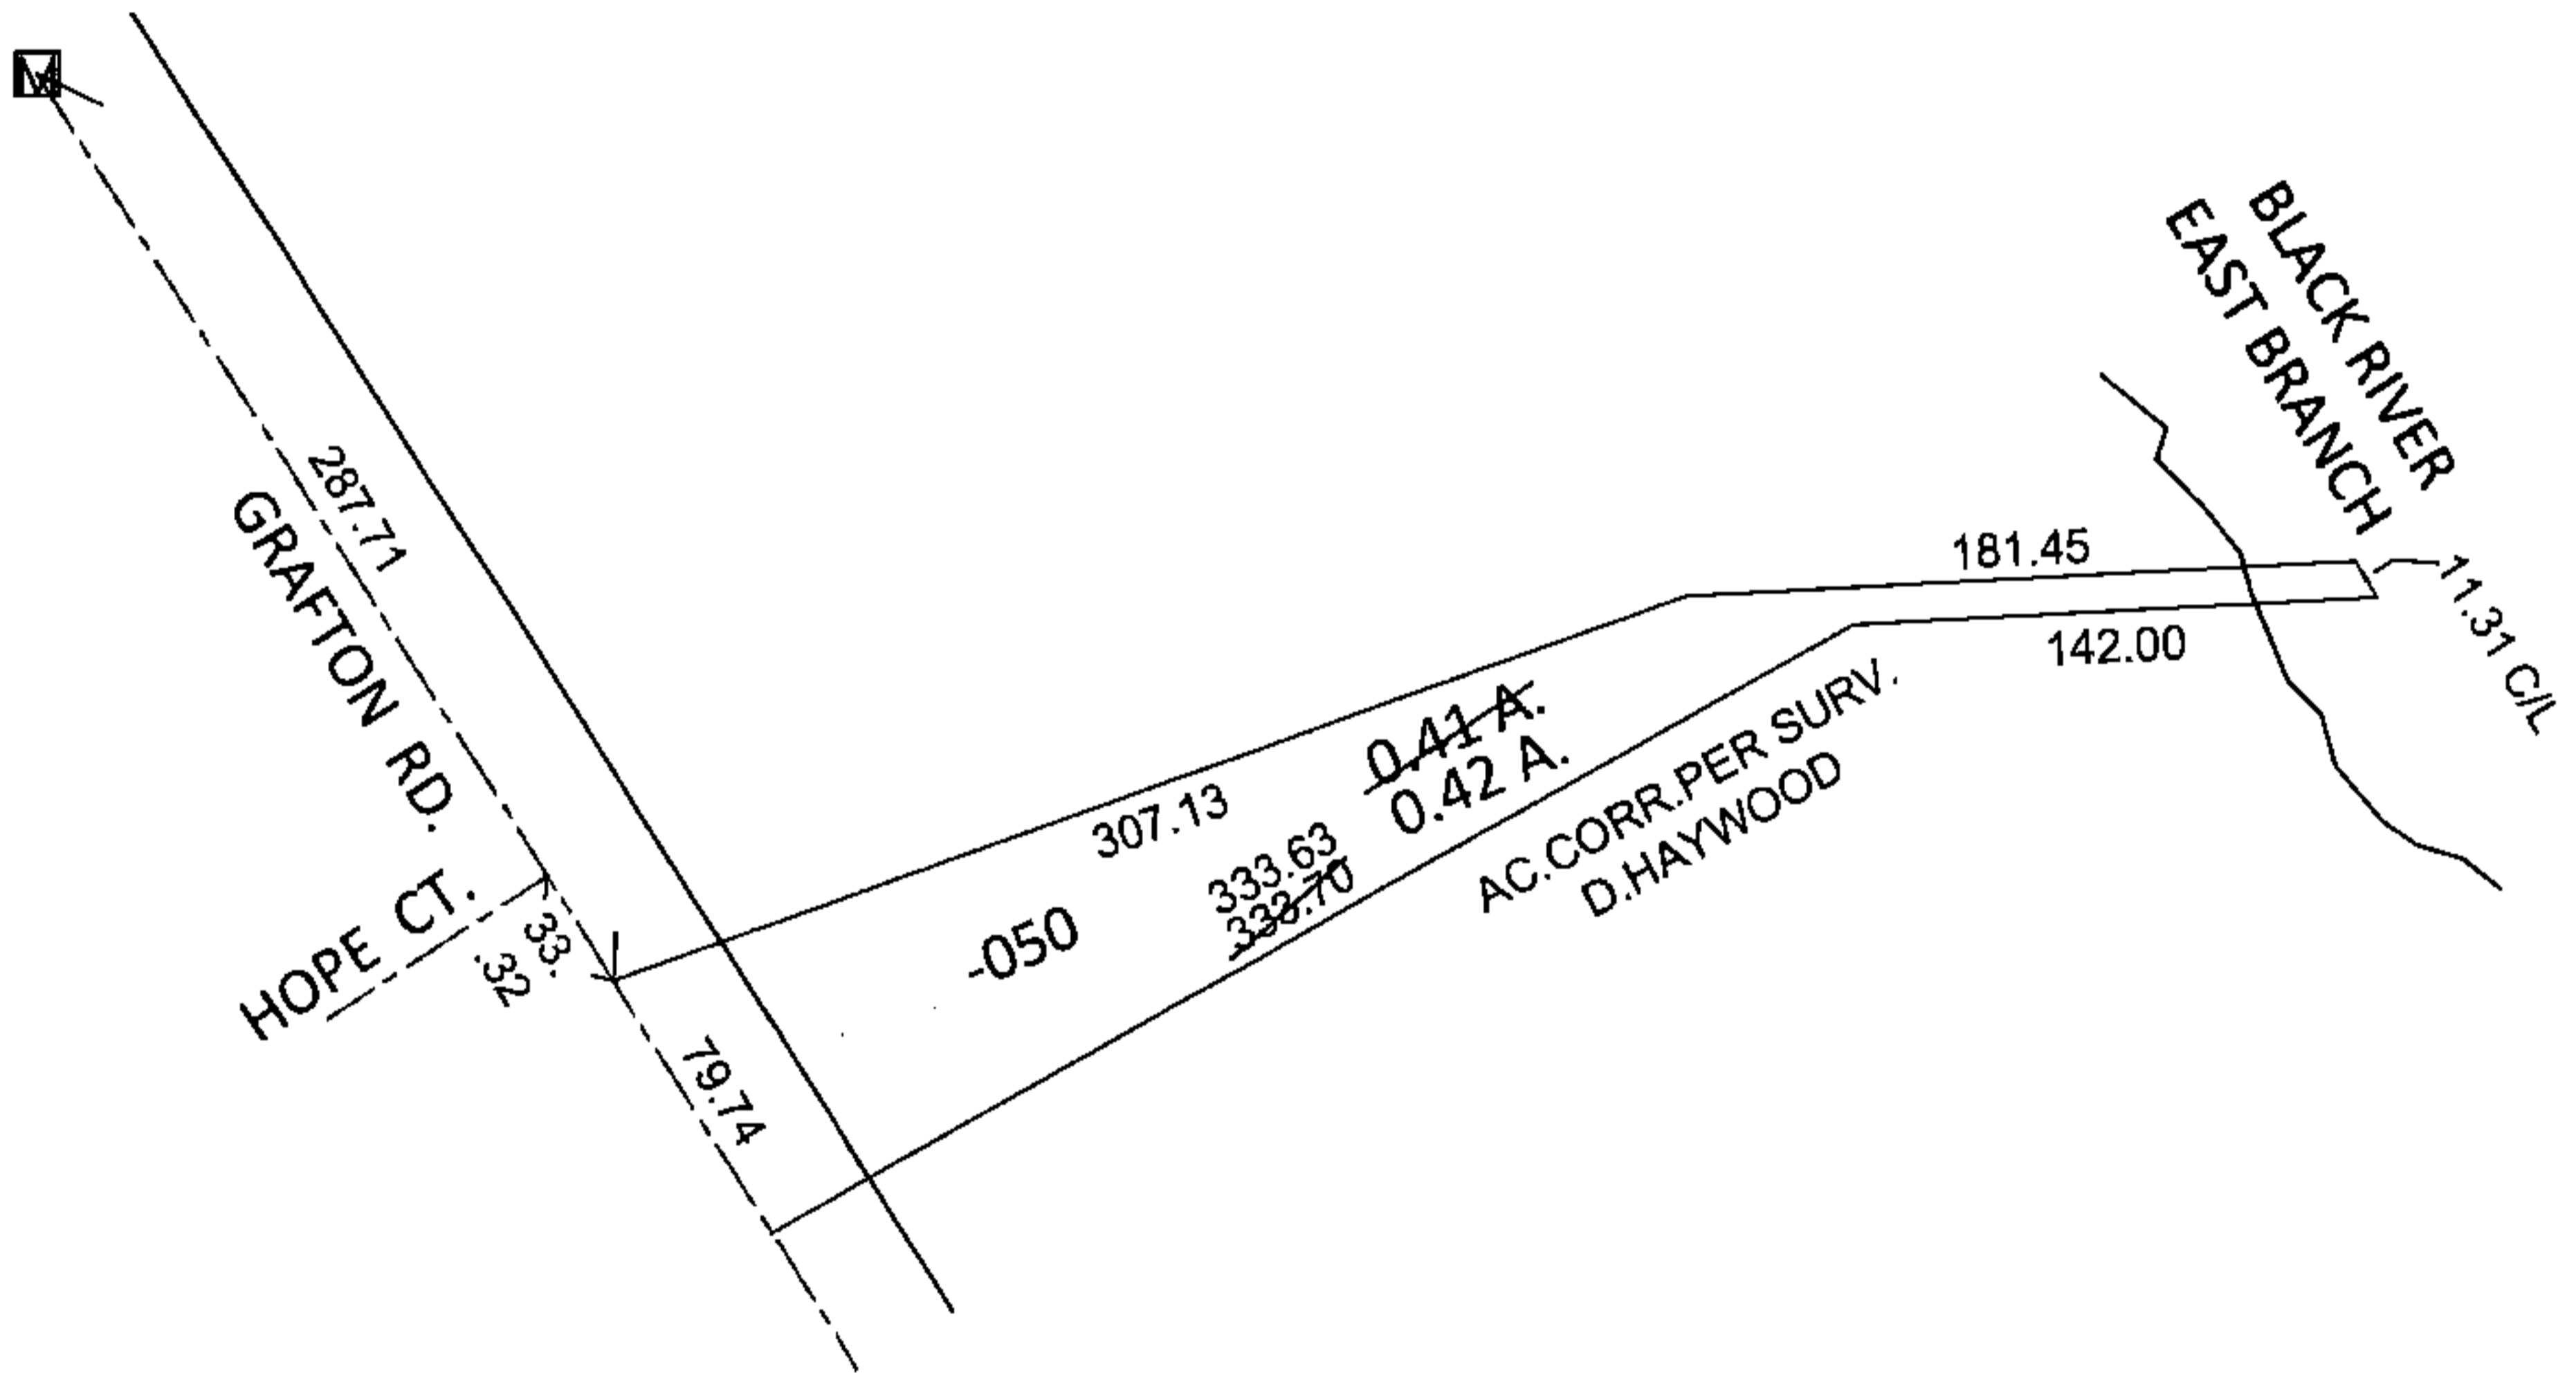


PARENT PARCEL: 10-00-004-131-050

CHILD PARCEL: \_\_\_\_\_

STARTING POINT: INTERSECTION OF C/L OF GRAFTON RD. AND C/L OF HOPE CT.

12-02522-D

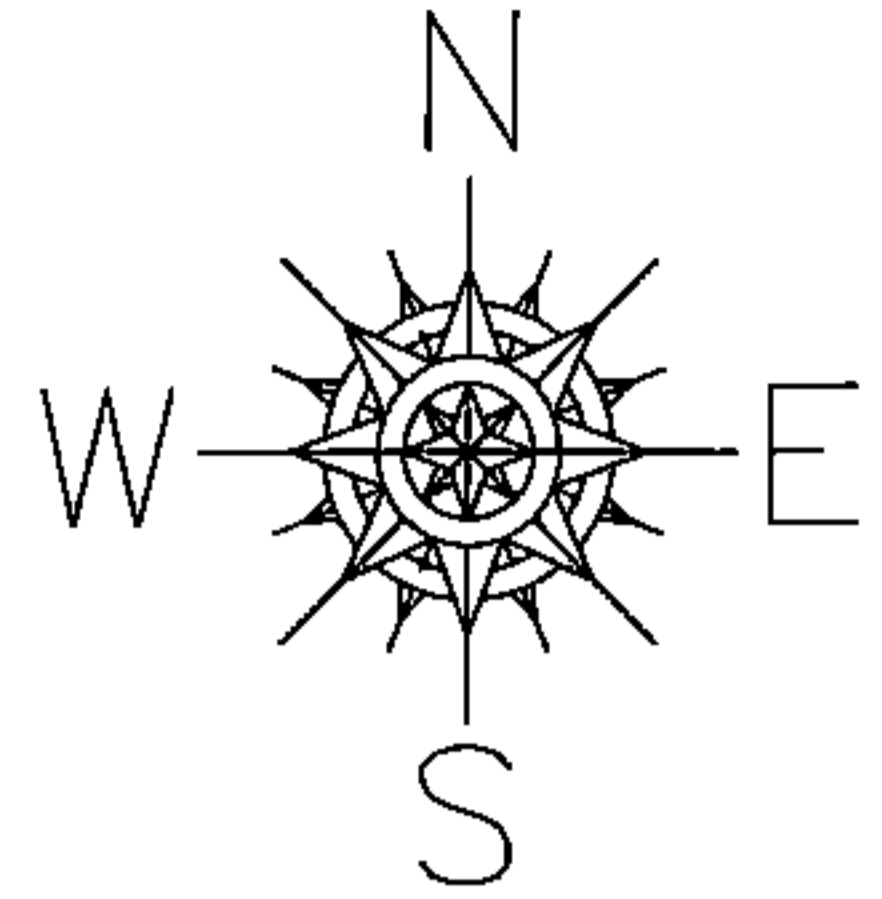

**SPLITS/DEEDS PROCESSED**

LORAIN COUNTY TAX MAP DEPARTMENT  
226 MIDDLE AVE. ELYRIA, OHIO

SURVEYED BY: DALE R. HAYWOOD  
 CLOSURE: .01:10,000  
 MAP PAGE(S): 10-00-004-H  
 APPROVED BY: RRM DATE: 6-11-12  
 SCALE: 1"= 100 PRIOR INST.: 20060132291