
APPROVED BY: JAH DATE: 2-4-08

SCALE: 1"= 100 PRIOR INSTRUMENT: 20070232689

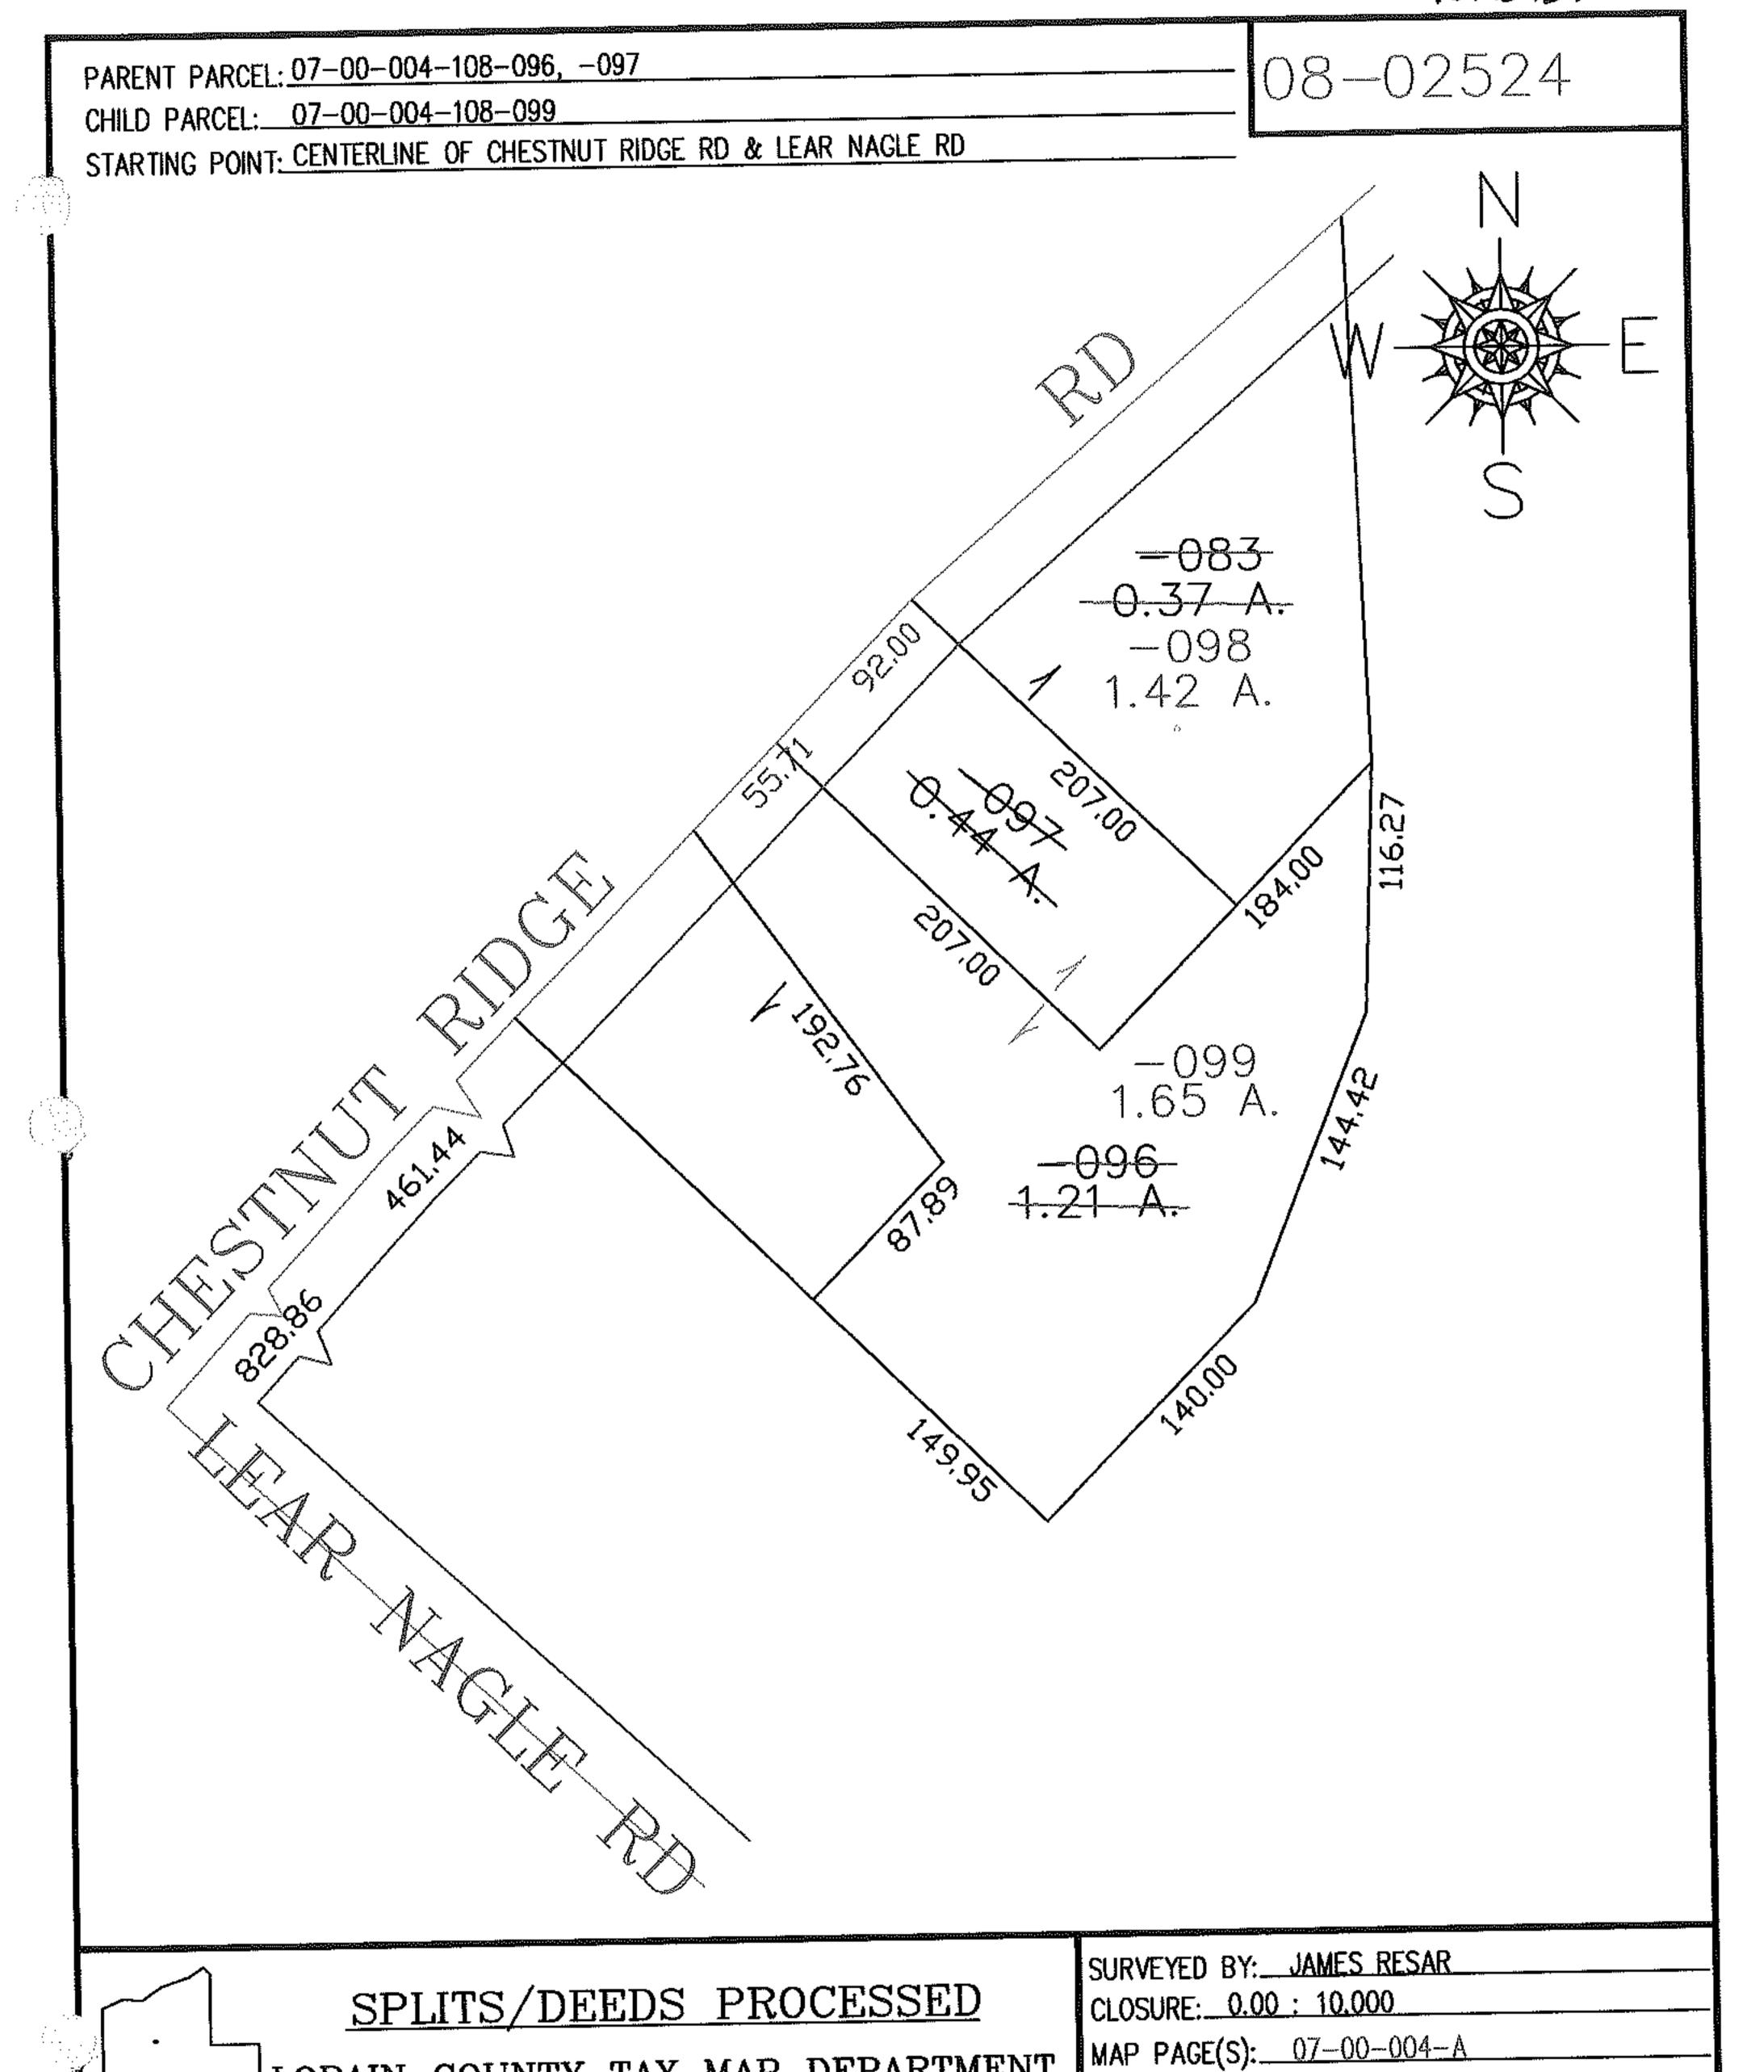

LORAIN COUNTY TAX MAP DEPARTMENT

226 MIDDLE AVE. ELYRIA, OHIO