




RASTER

PARENT PARCEL: 06-25-007-000-194

CHILD PARCEL: 06-25-007-000-258, -259

STARTING POINT: CENTERLINE OF ST RT 57 & EAST BROAD ST

08-02527

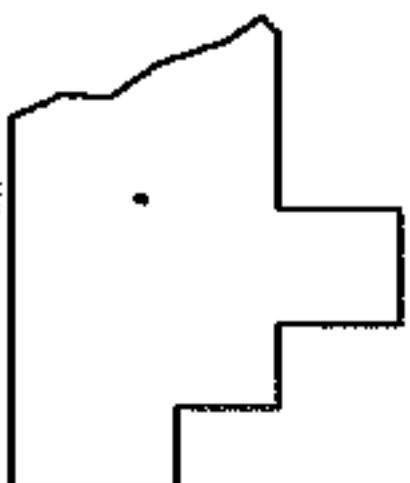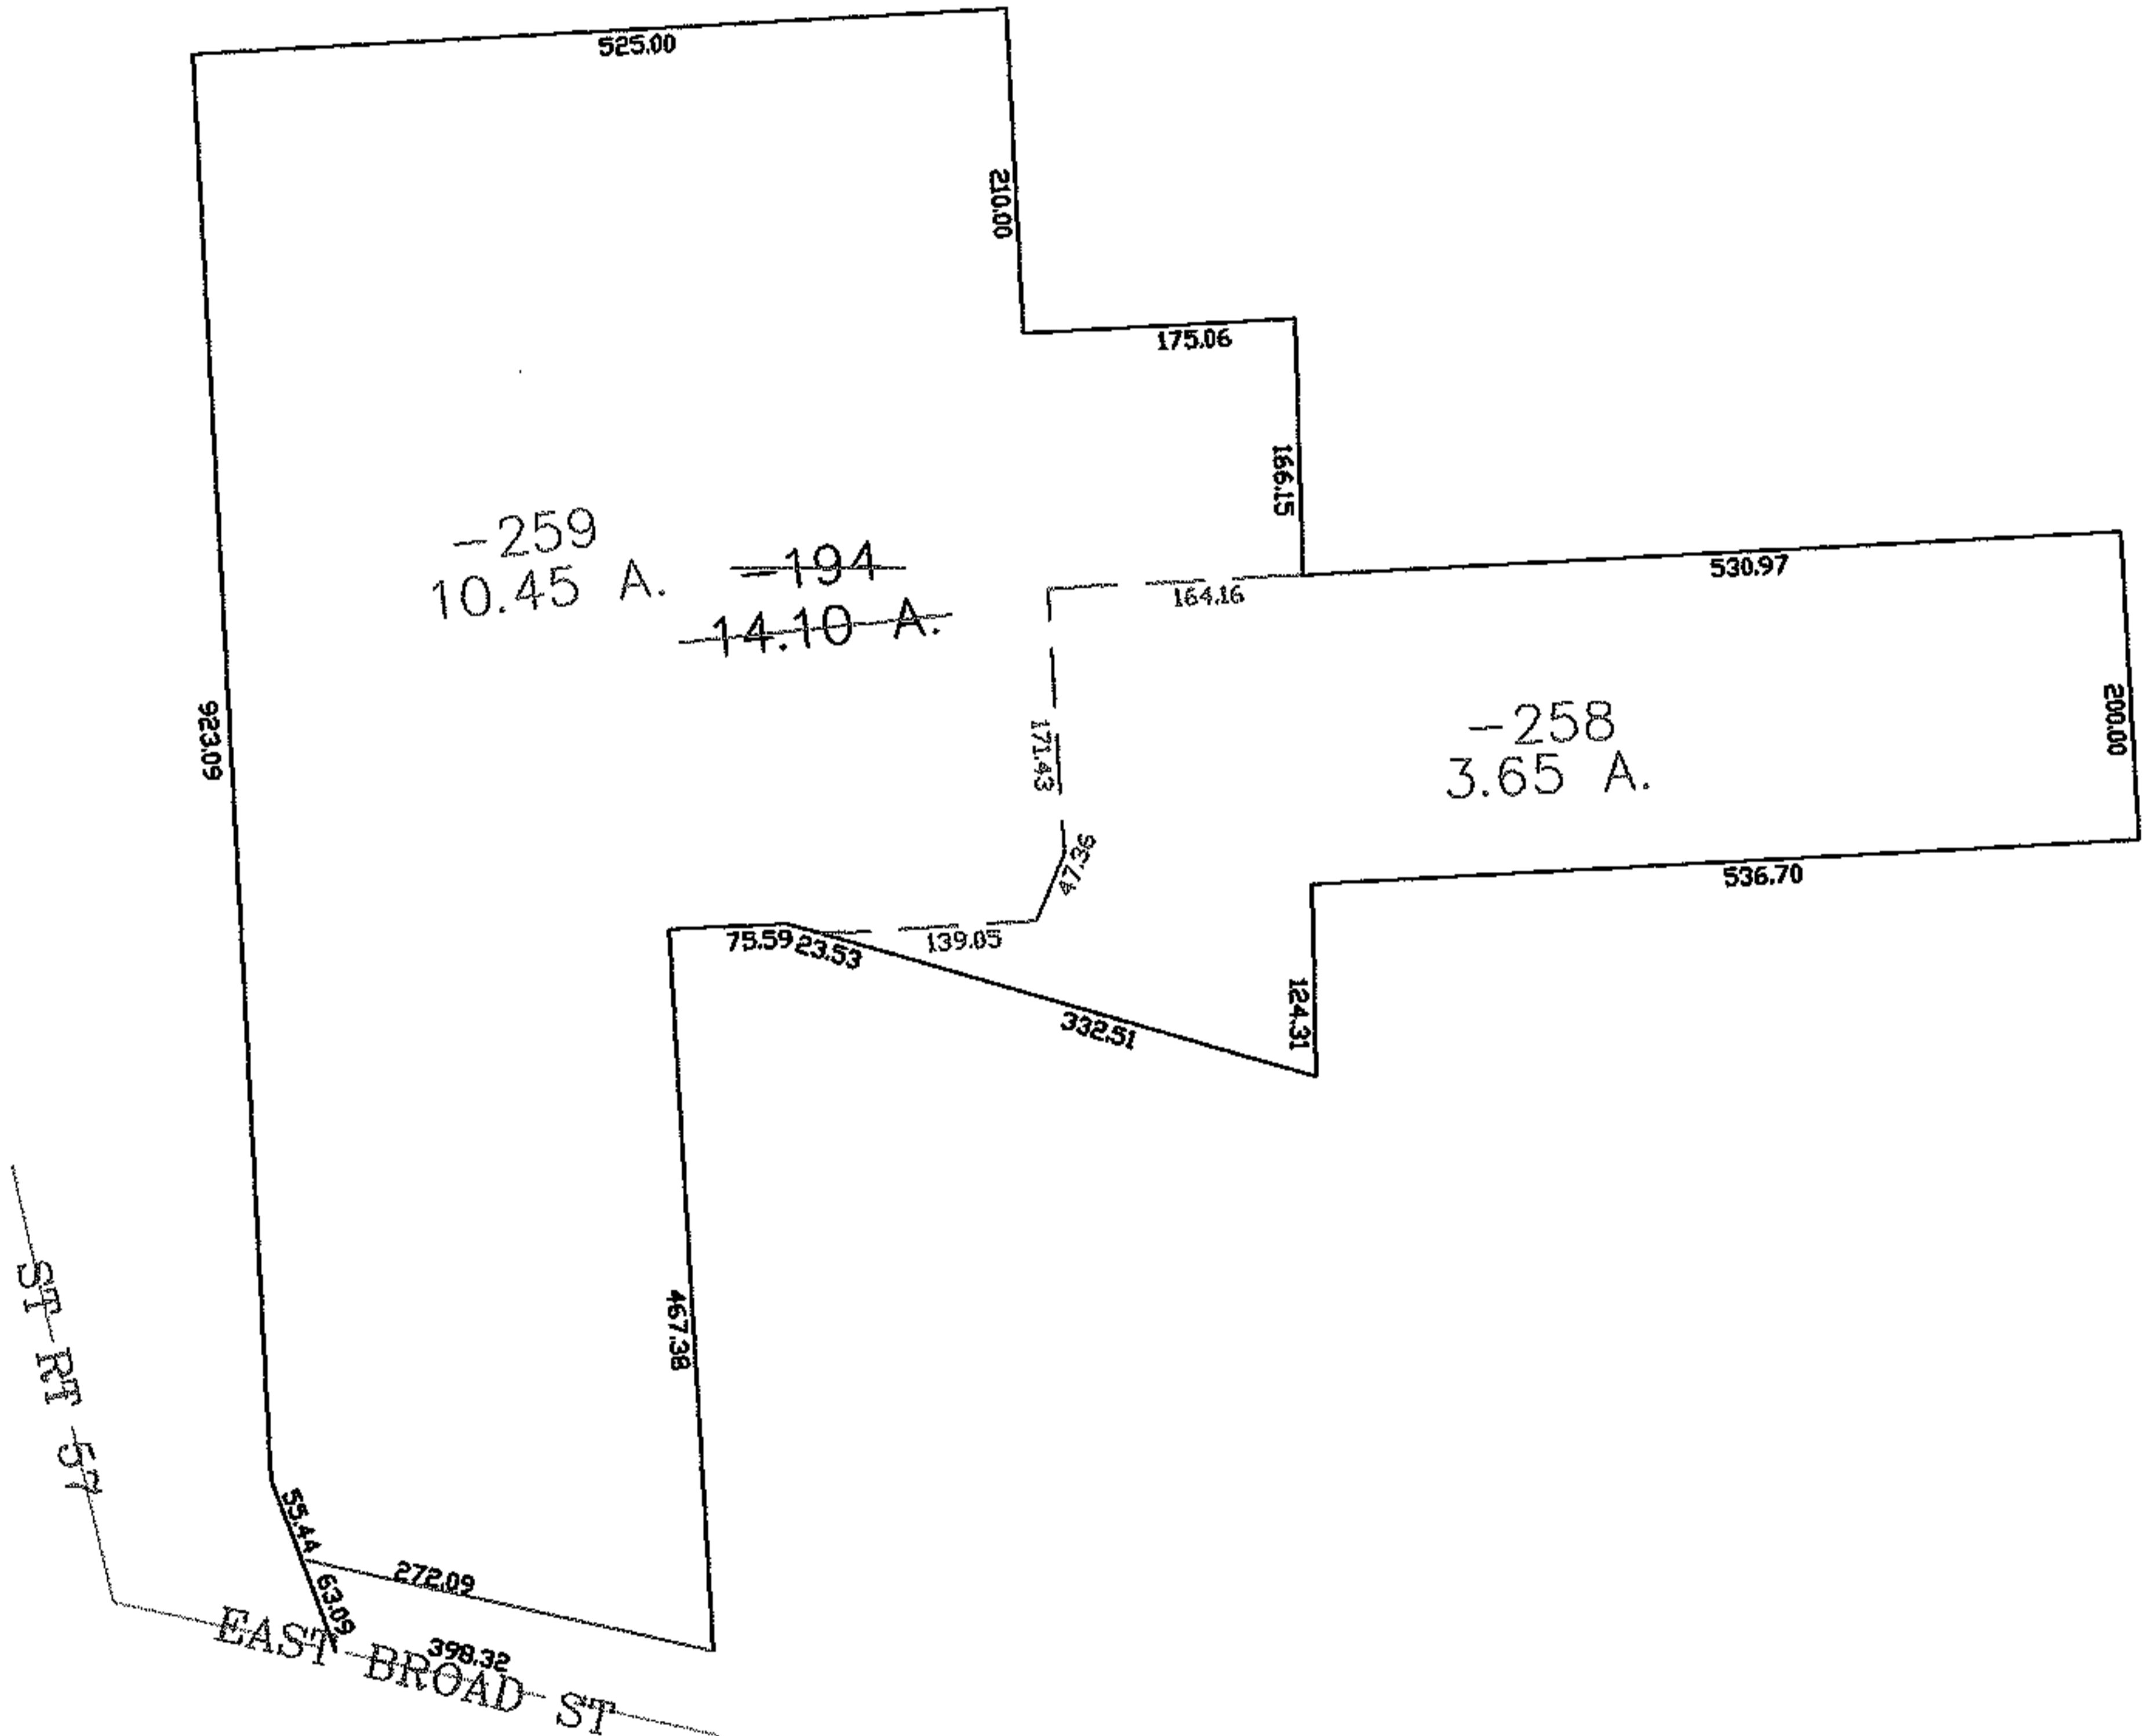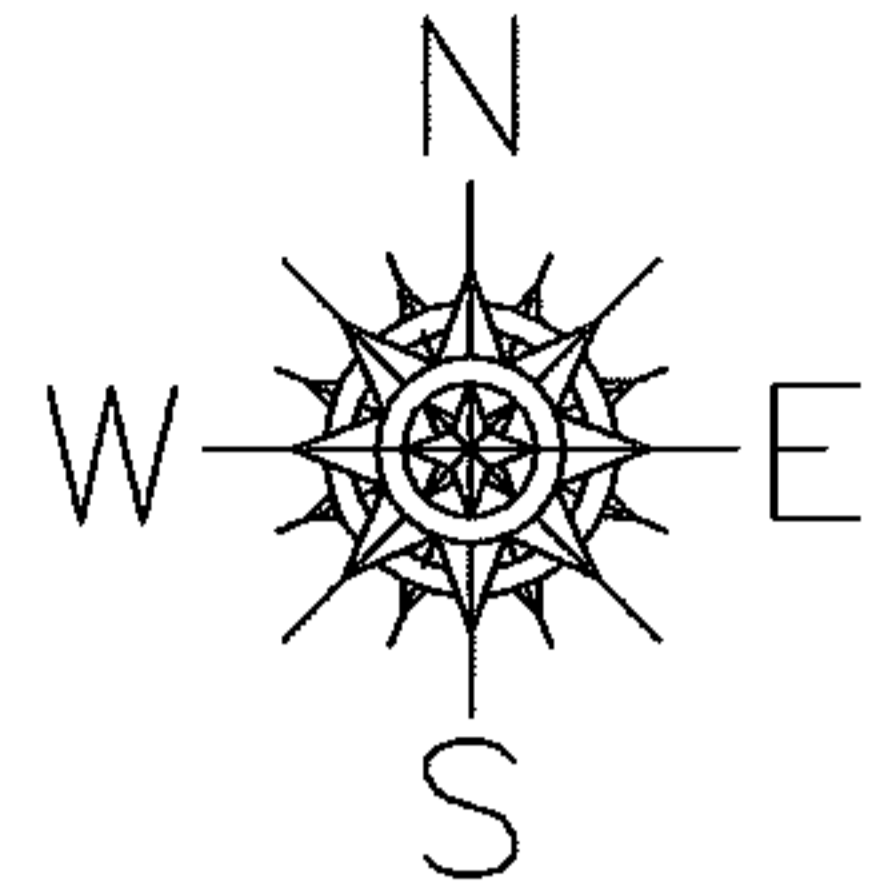

SPLITS/DEEDS PROCESSED

LORAIN COUNTY TAX MAP DEPARTMENT
226 MIDDLE AVE. ELYRIA, OHIO

SURVEYED BY: DALE HAYWOOD

CLOSURE: 0.00 : 10.000

MAP PAGE(S): 6-126

APPROVED BY: JAH DATE: 2-14-08

SCALE: 1" = 200 PRIOR INSTRUMENT: OR 698/737