



RASTER

PARENT PARCEL: 04-00-009-000-152

CHILD PARCEL: 04-00-009-000-153, -154, -155

STARTING POINT: CENTERLINE OF MOORE RD & FREEMAN DR

08-02528

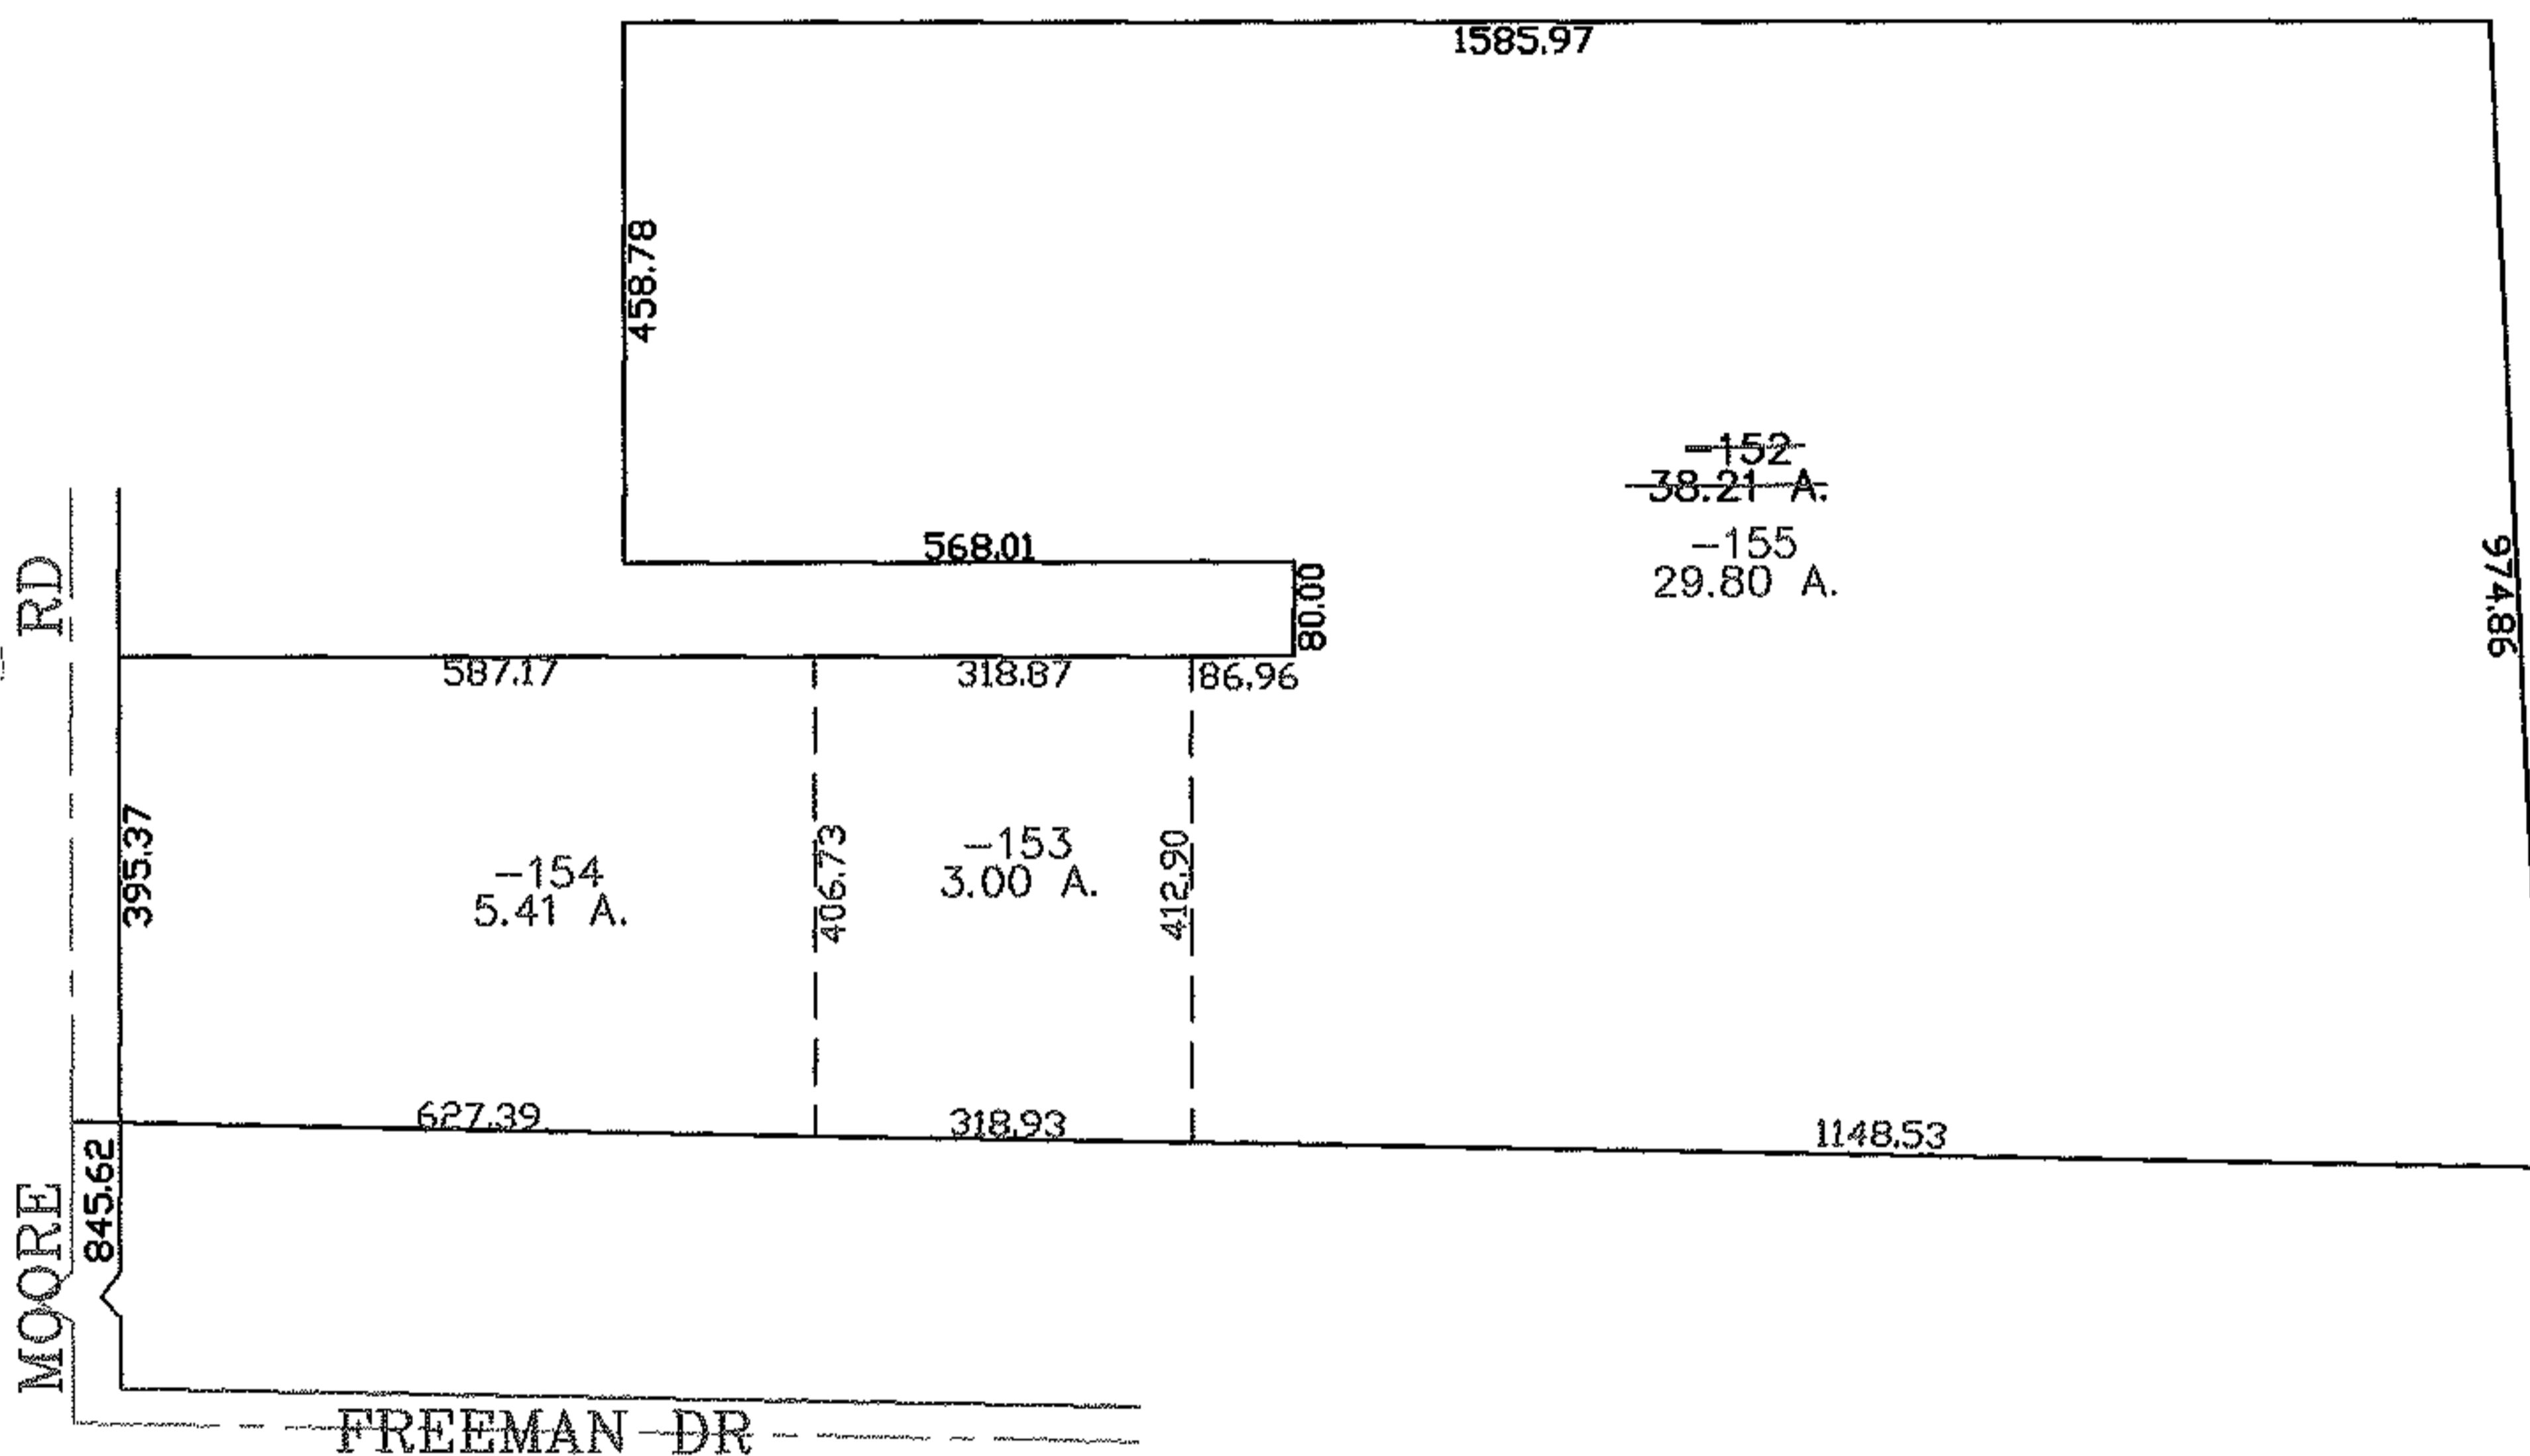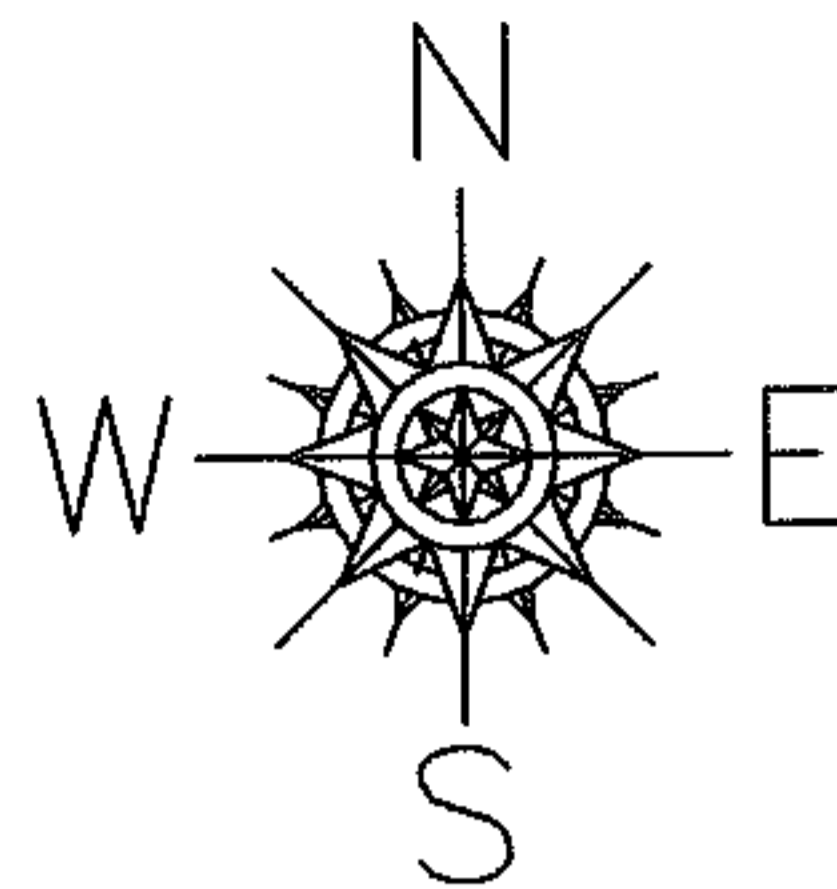

**SPLITS/DEEDS PROCESSED**  
 LORAIN COUNTY TAX MAP DEPARTMENT  
 226 MIDDLE AVE. ELYRIA, OHIO

SURVEYED BY: CHRISTOPHER HIRZEL  
 CLOSURE: 0.00 : 10.000  
 MAP PAGE(S): 04-00-009-A  
 APPROVED BY: JAH DATE: 2-15-08  
 SCALE: 1" = 300 PRIOR INSTRUMENT: 20040041443