
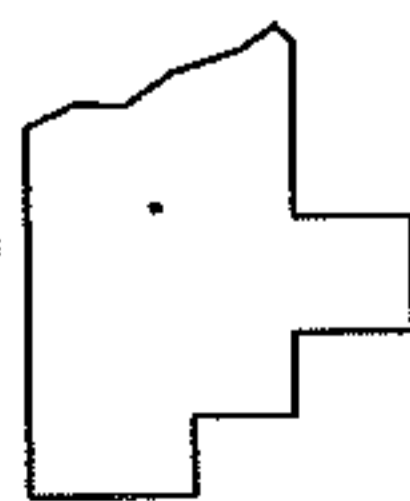
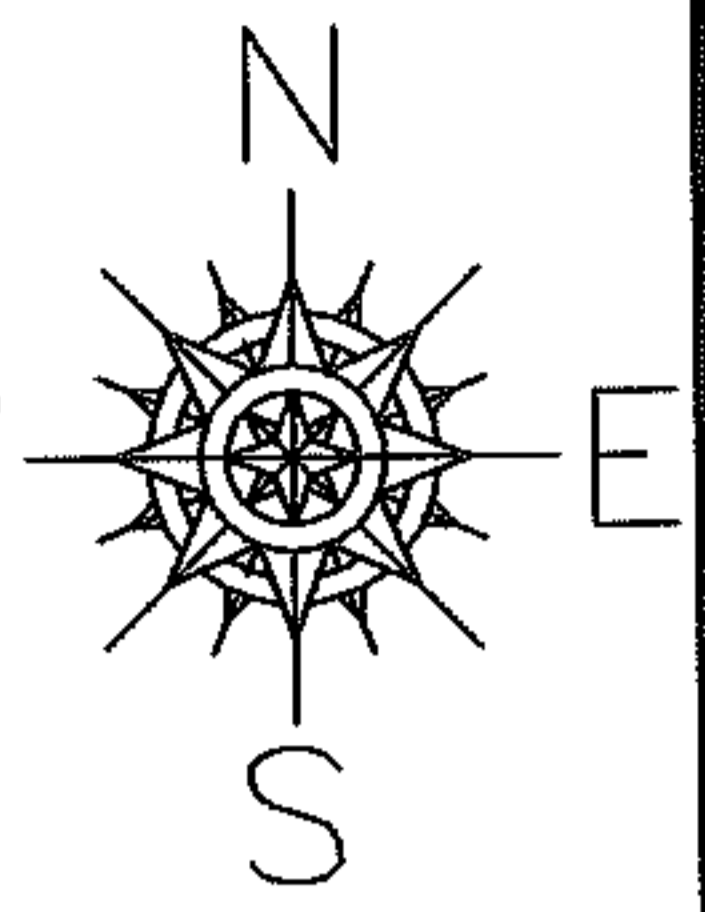


PARENT PARCEL: 04-00-008-104-101, -104
 CHILD PARCEL: 04-00-008-104-126 THRU -131
 STARTING POINT: CENTERLINE OF WEBBER RD & ST RT 83

08-02531

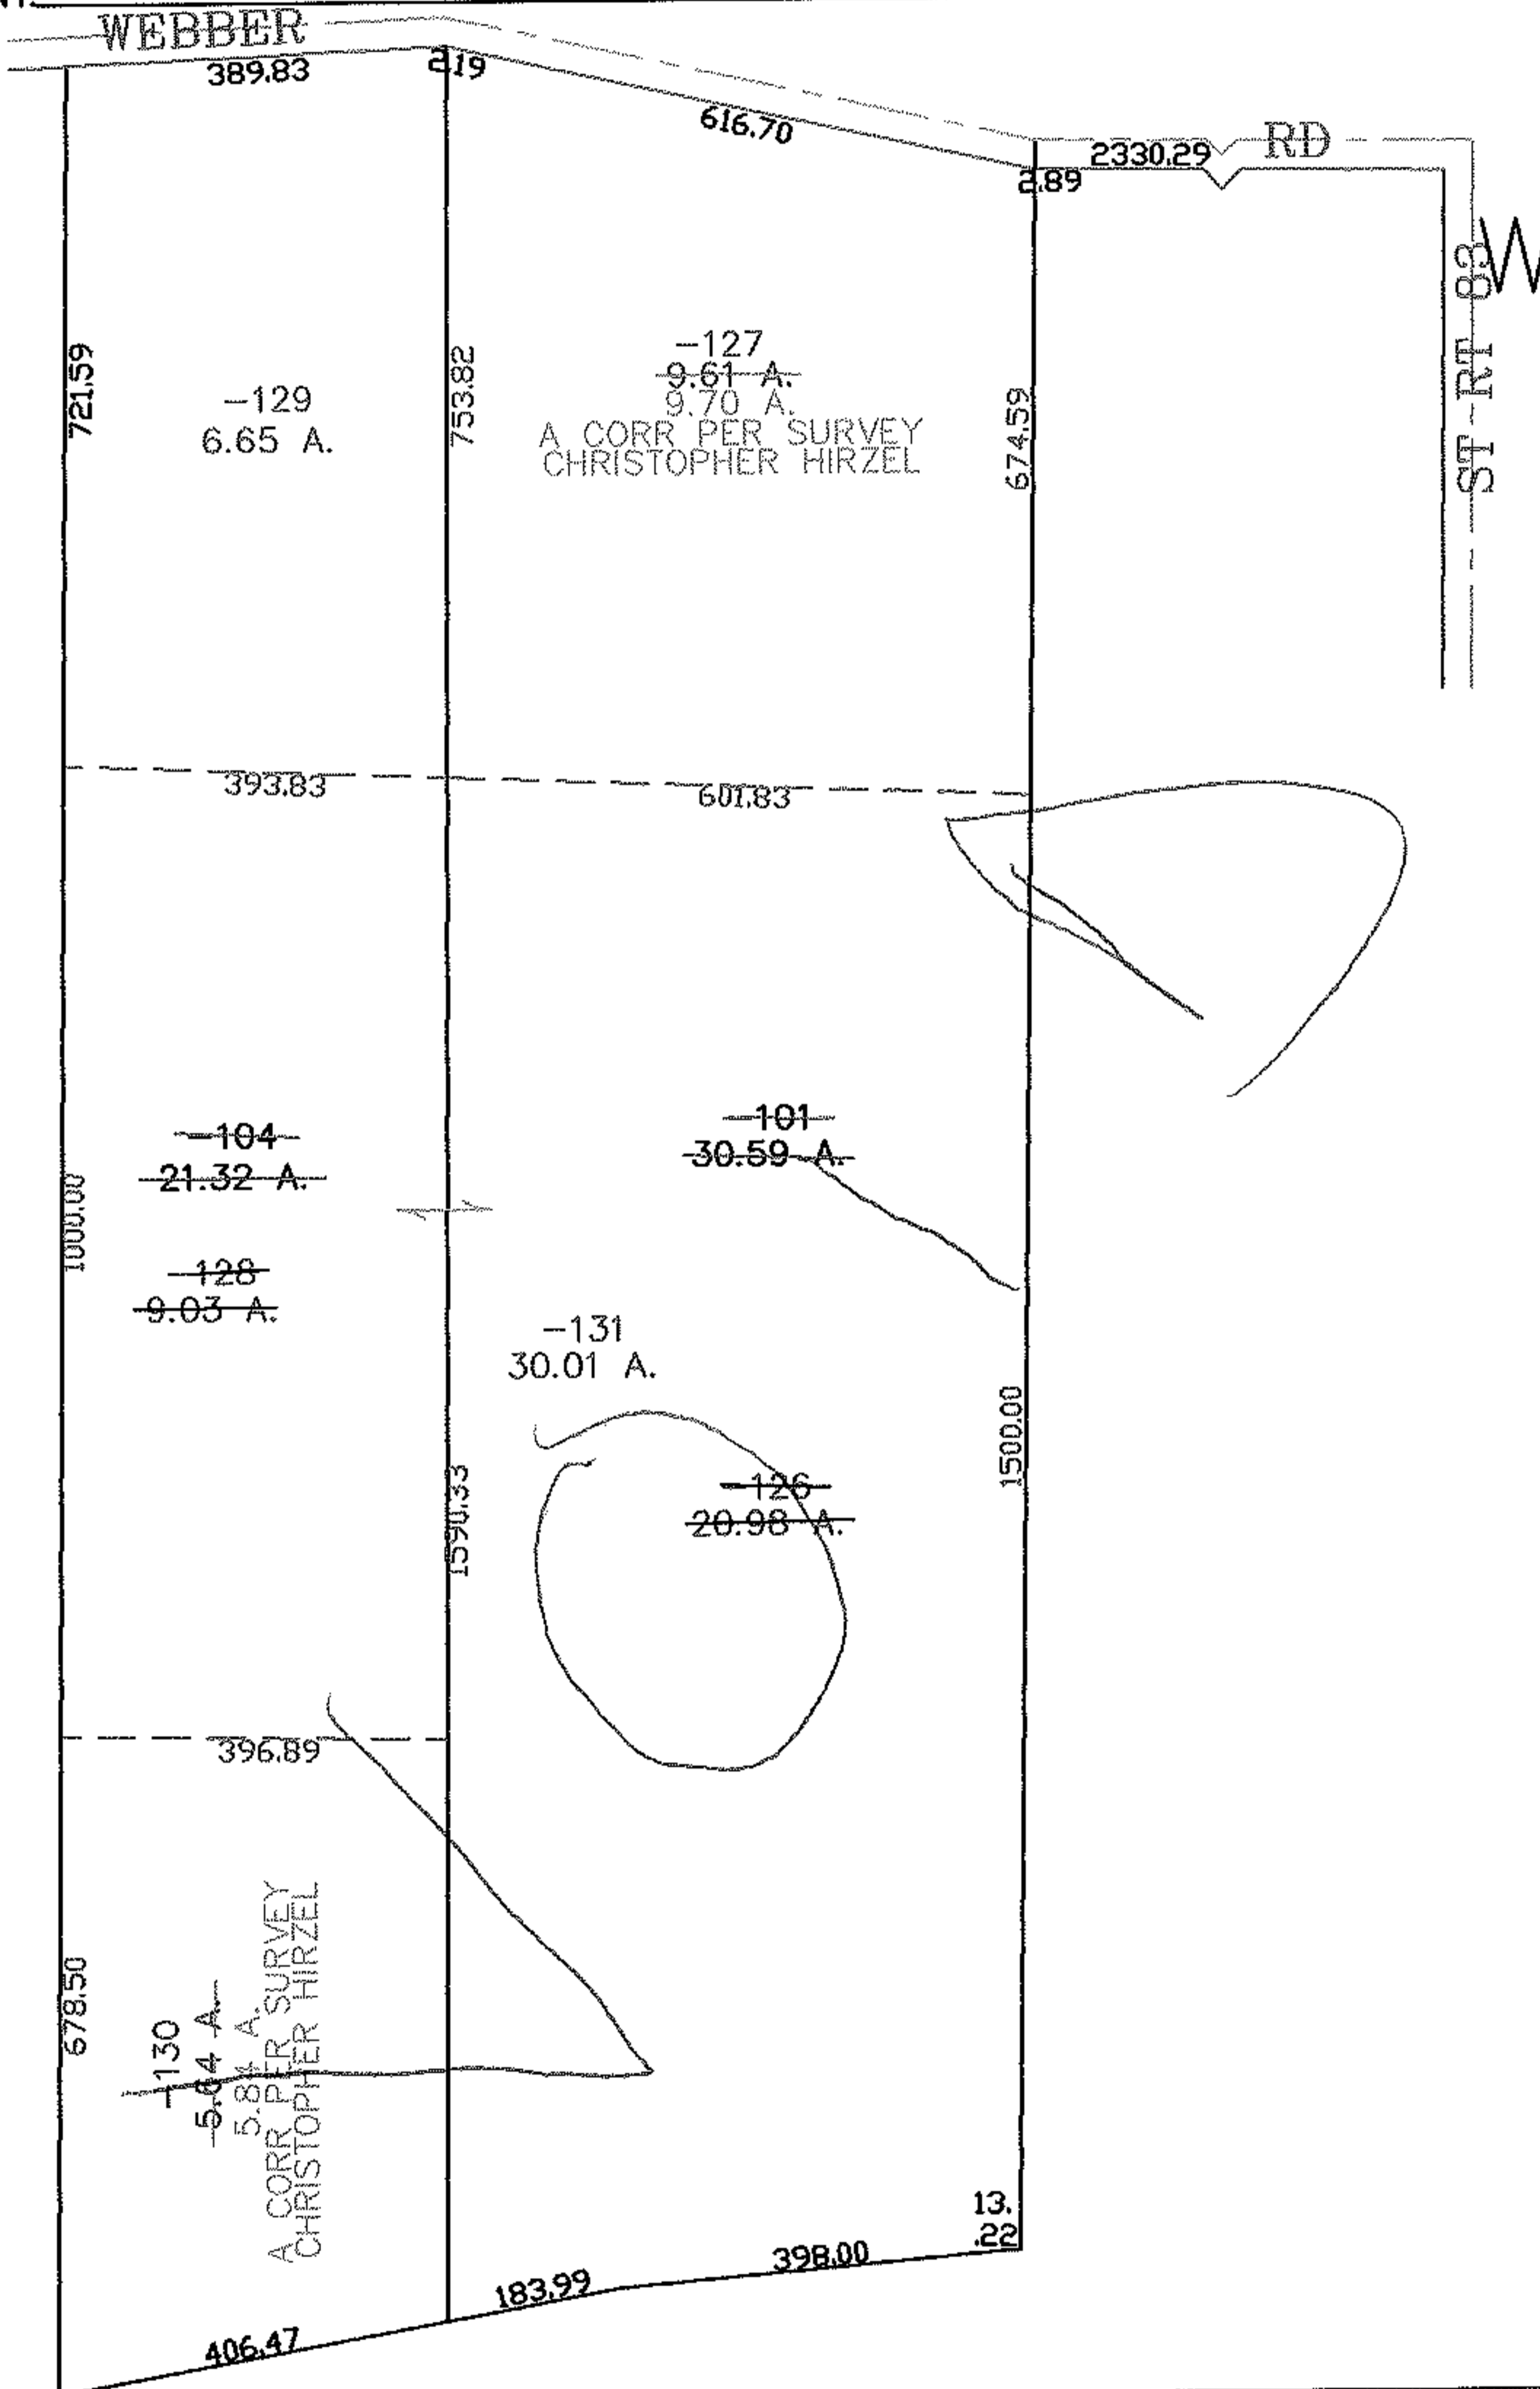

SPLITS/DEEDS PROCESSED
 LORAIN COUNTY TAX MAP DEPARTMENT
 226 MIDDLE AVE. ELYRIA, OHIO

SURVEYED BY: CHRISTOPHER HIRZEL
 CLOSURE: 0.00 : 10.000
 MAP PAGE(S): 04-00-008-D
 APPROVED BY: JAH DATE: 2-27-08
 SCALE: 1" = 300 PRIOR INSTRUMENT: 20040012891