


RASTER

PARENT PARCEL: 08-14-013-000-006

CHILD PARCEL: 08-14-013-000-007, -008

STARTING POINT: CENTERLINE OF BAIRD RD & GARFIELD RD

08-02534

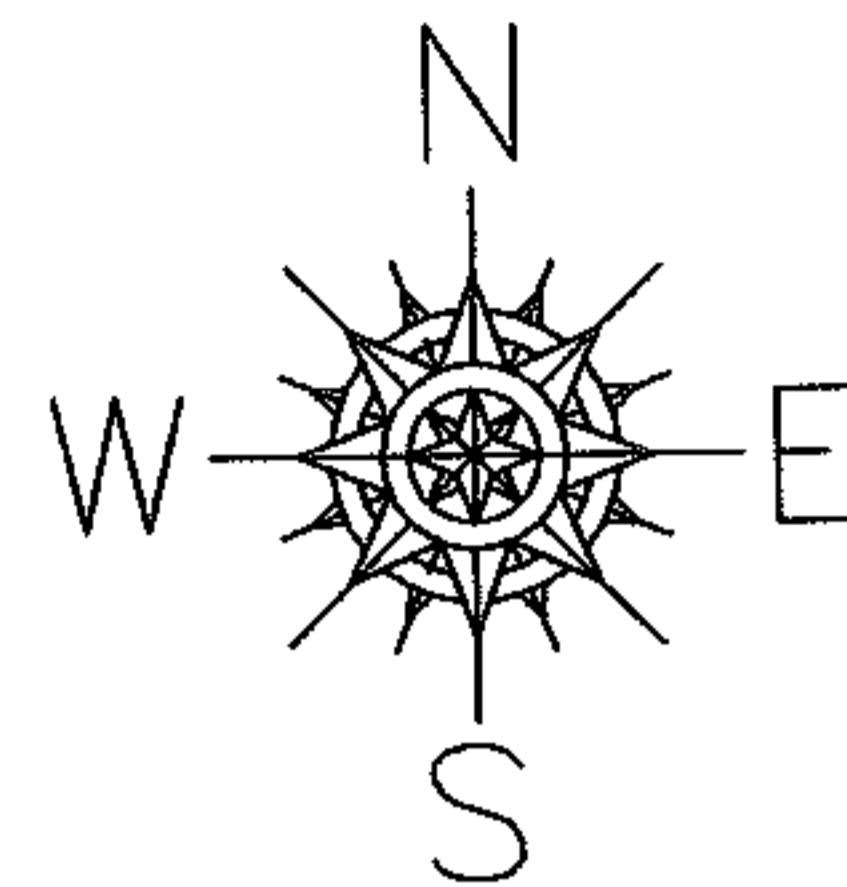

~~-006~~
~~40.22 A.~~
-008
36.97 A.

~~GARFIELD RD~~

774.60

300.00


BAIRD RD

472.70

300.00

-007
3.25 A.

472.70

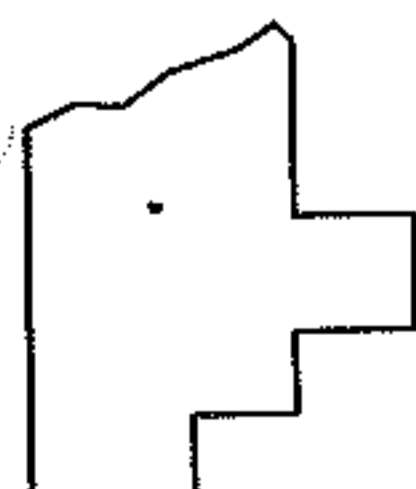

SPLITS/DEEDS PROCESSED

LORAIN COUNTY TAX MAP DEPARTMENT
226 MIDDLE AVE. ELYRIA, OHIO

SURVEYED BY: THOMAS SNEZEK

CLOSURE: 0.00 : 10.000

MAP PAGE(S): 08-14-013

APPROVED BY: JAH DATE: 3-4-08

SCALE: 1" = 100 PRIOR INSTRUMENT: 20030966127