
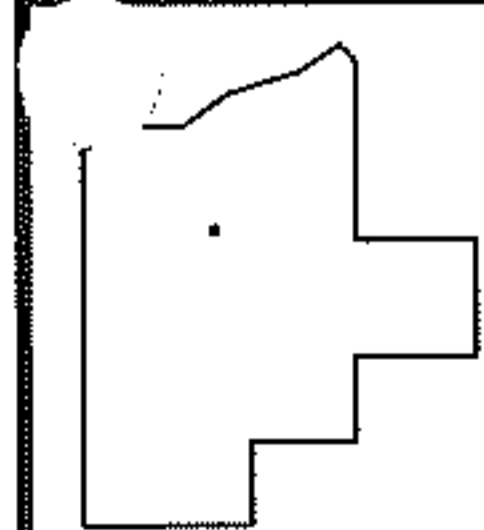
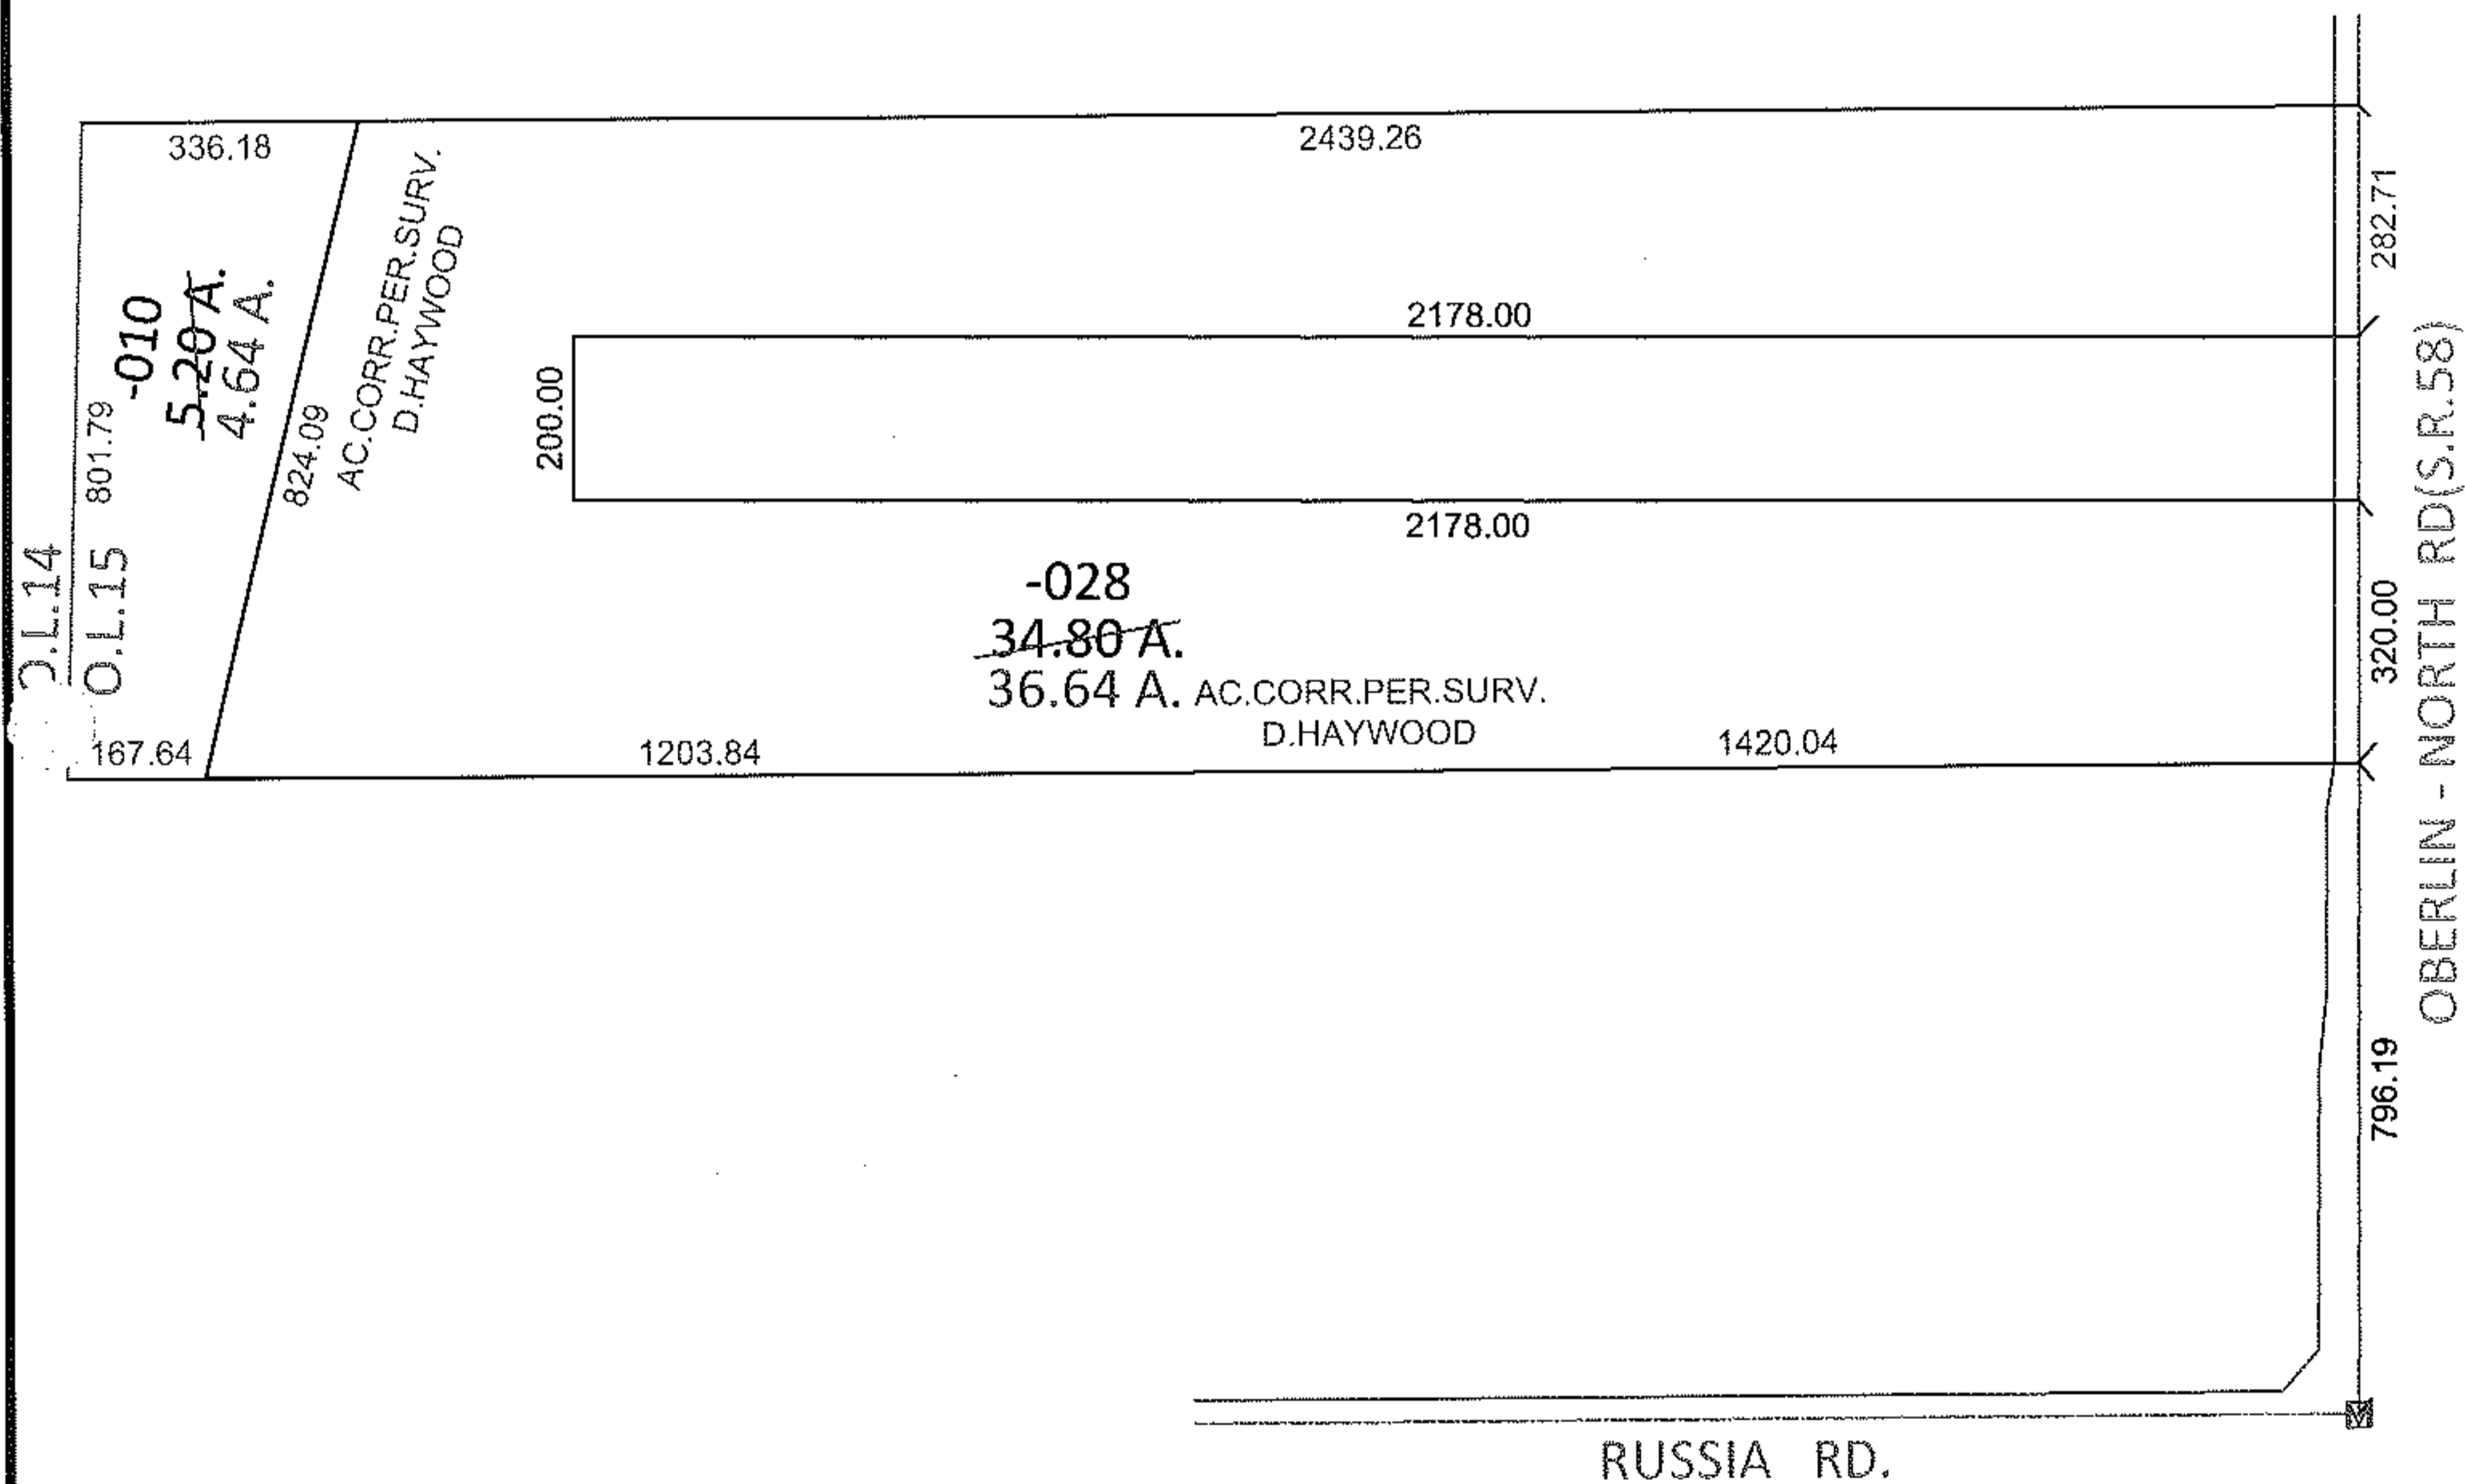


PARENT PARCEL: 09-00-015-000-010, -028

CHILD PARCEL: _____

STARTING POINT: AT A MON BOX AT THE INTERSECTION OF C/L OF RUSSIA RD. AND C/L OF S.R.58

12-02535-A

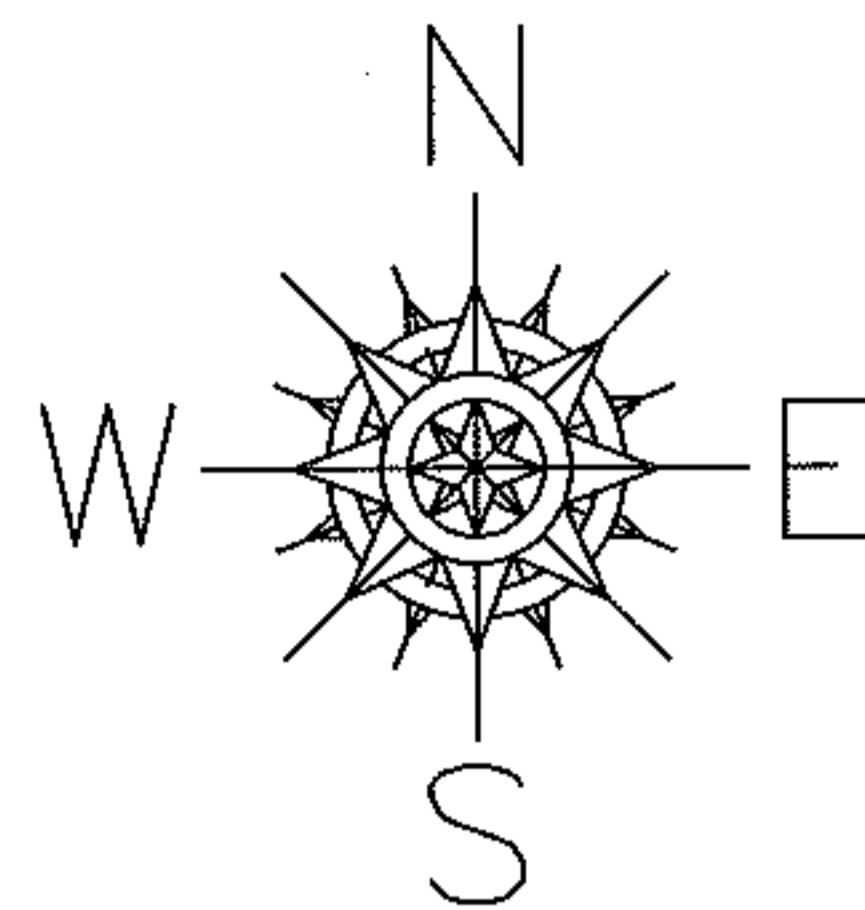

SPLITS/DEEDS PROCESSED

LORAIN COUNTY TAX MAP DEPARTMENT
226 MIDDLE AVE. ELYRIA, OHIO

SURVEYED BY: DALE R. HAYWOOD

CLOSURE: 01:10,000

MAP PAGE(S): 9-B

APPROVED BY: RRM DATE: 7-12-12

SCALE: 1" = 400 PRIOR INST.: 19990645543