




RASTER

PARENT PARCEL: 05-00-026-101-021

CHILD PARCEL: 05-00-026-101-127, -128

STARTING POINT: CENTERLINE OF SLEEPY HOLLOW DR & MIDDLE RIDGE RD

08-02536

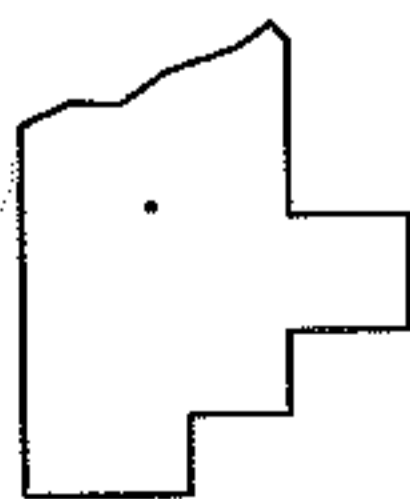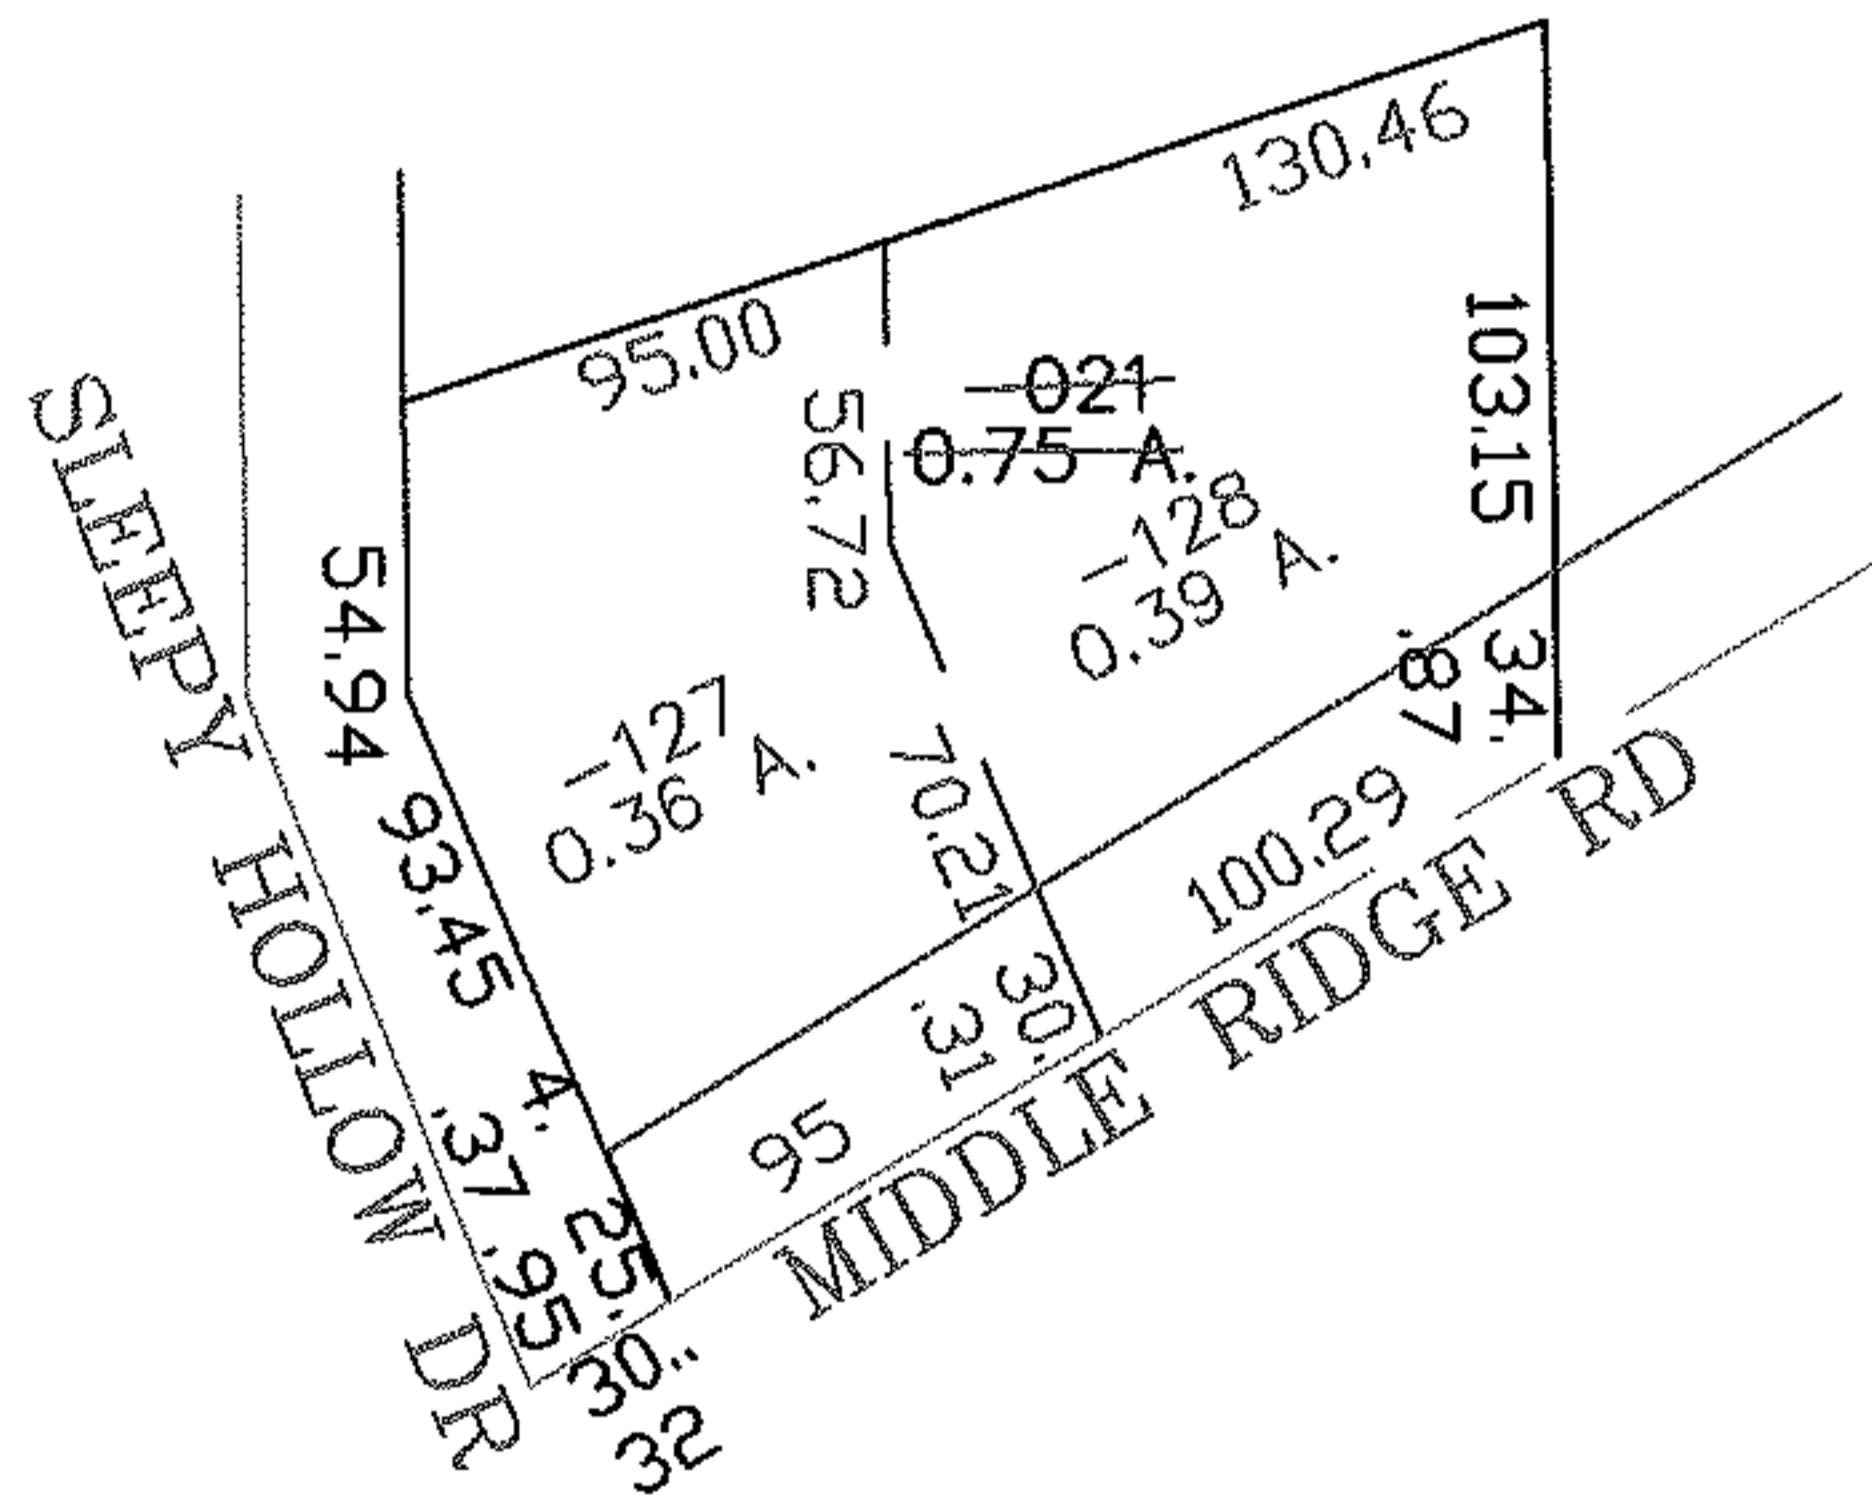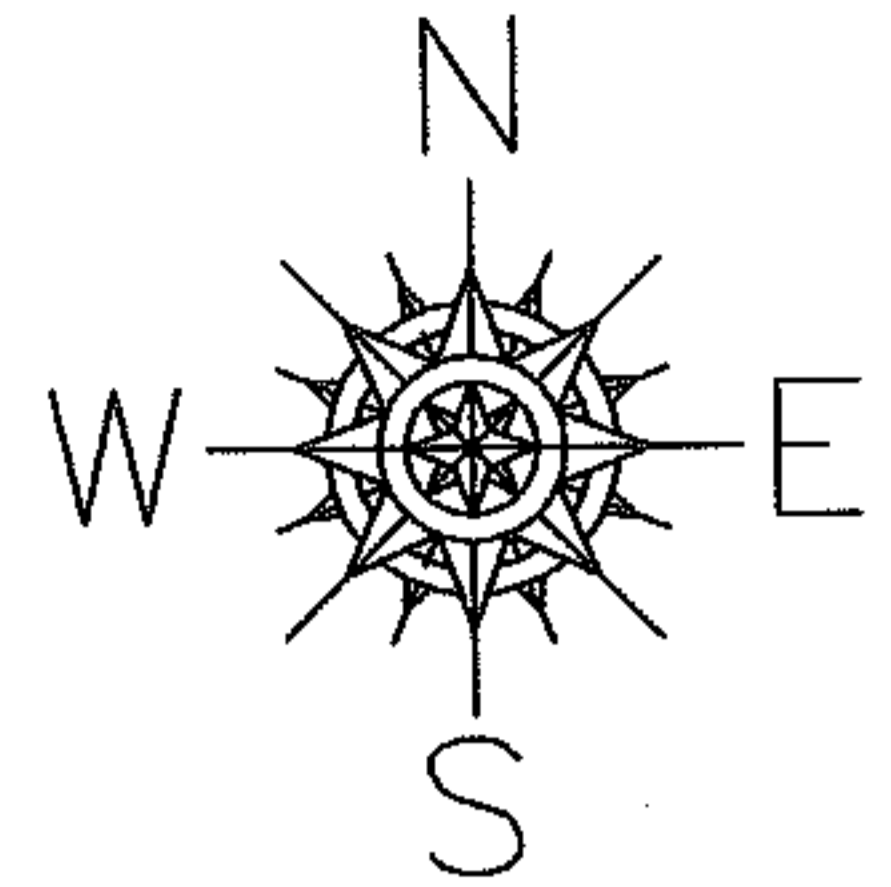

SPLITS/DEEDS PROCESSED

LORAIN COUNTY TAX MAP DEPARTMENT
226 MIDDLE AVE. ELYRIA, OHIO

SURVEYED BY: PATRICK MCGANNON

CLOSURE: 0.00 : 10.000

MAP PAGE(S): 05-00-026-A

APPROVED BY: JAH DATE: 3-7-08

SCALE: 1" = 100 PRIOR INSTRUMENT: 20070216029