
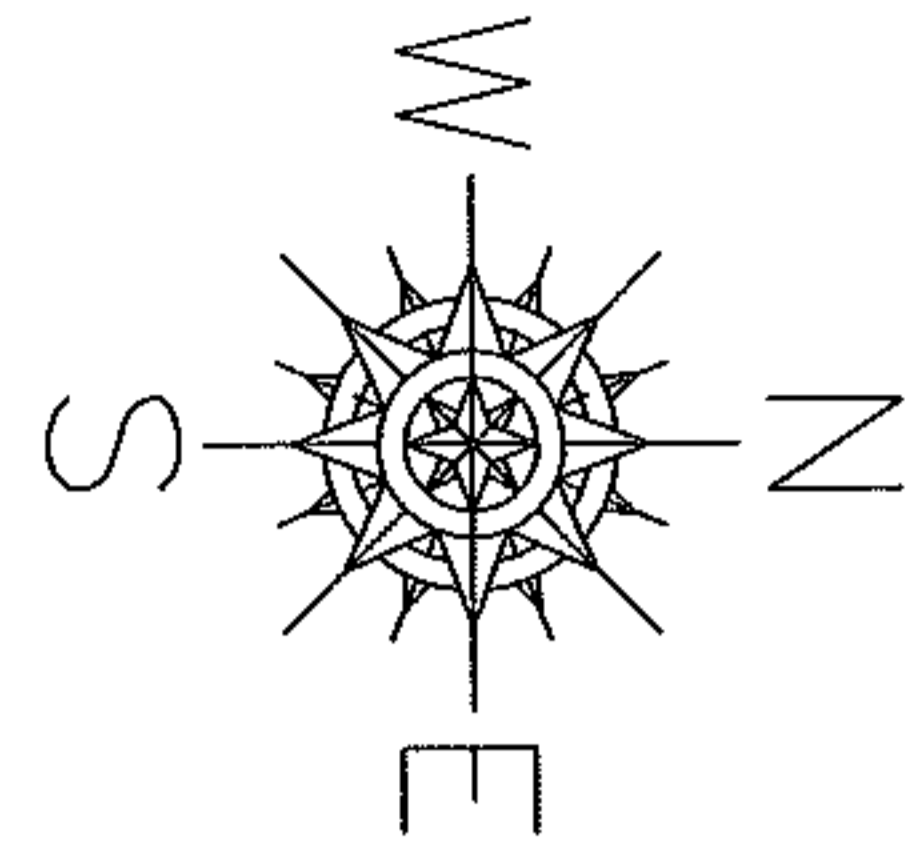


PARENT PARCEL: 04-00-021-000-277

CHILD PARCEL: \_\_\_\_\_

STARTING POINT: MON. BOX, CENTERLINE OF JAYCOX RD & O.L. 21

12-2538-A

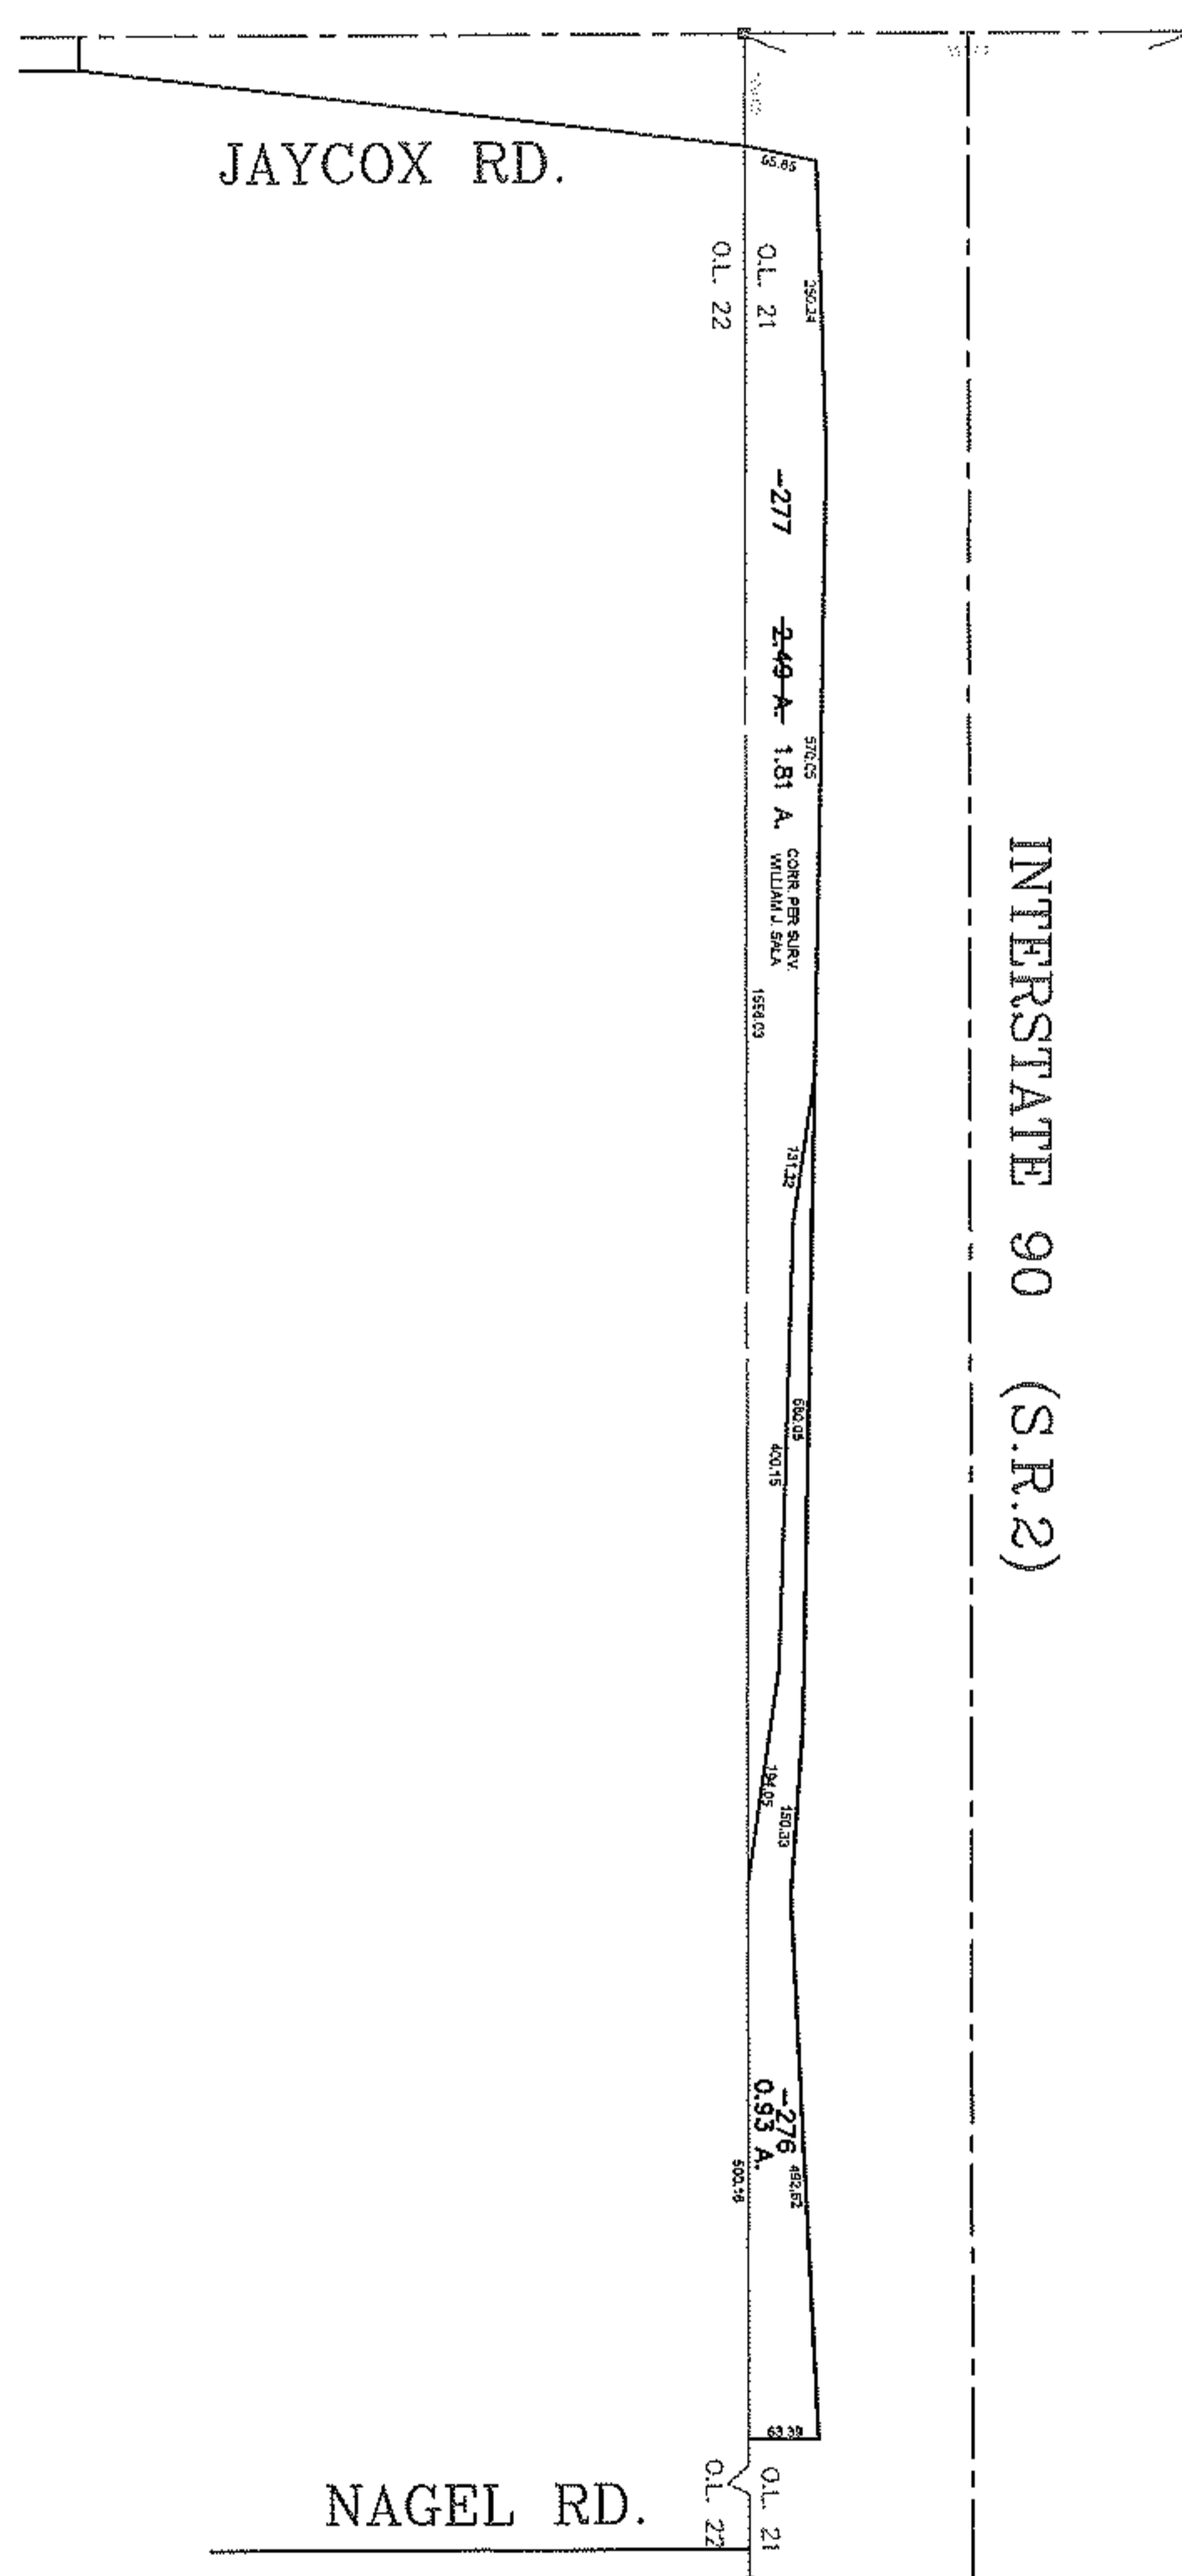


ACREAGE CORRECTION

04-00-021-000-277

~~2.49 A.~~

1.81 A.

CORR. PER SURV.  
WILLIAM J. SALA

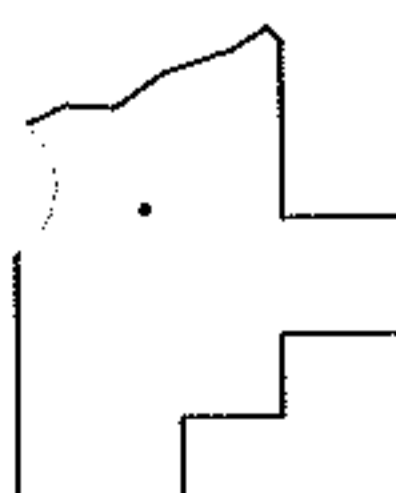

**SPLITS/DEEDS PROCESSED**  
**LORAIN COUNTY TAX MAP DEPARTMENT**  
 226 MIDDLE AVE. ELYRIA, OHIO

SURVEYED BY: WILLIAM J SALA  
 CLOSURE: 0.00 : 10.000  
 MAP PAGE(S): 04-00-021-G  
 APPROVED BY: TJS DATE: 7/18/12  
 SCALE: 1" = 300 PRIOR INSTRUMENT: DV 863/398