

PARENT PARCEL: 10-00-006-104-004

CHILD PARCEL: XX-XX-XXX-XXX-XXX

STARTING POINT: XXXXXX

12-02540-C



ACREAGE CORRECTION

10-00-006-104-004

~~2.30~~ A.

2.50 A.

CORR. PER DEED
DV 621/324

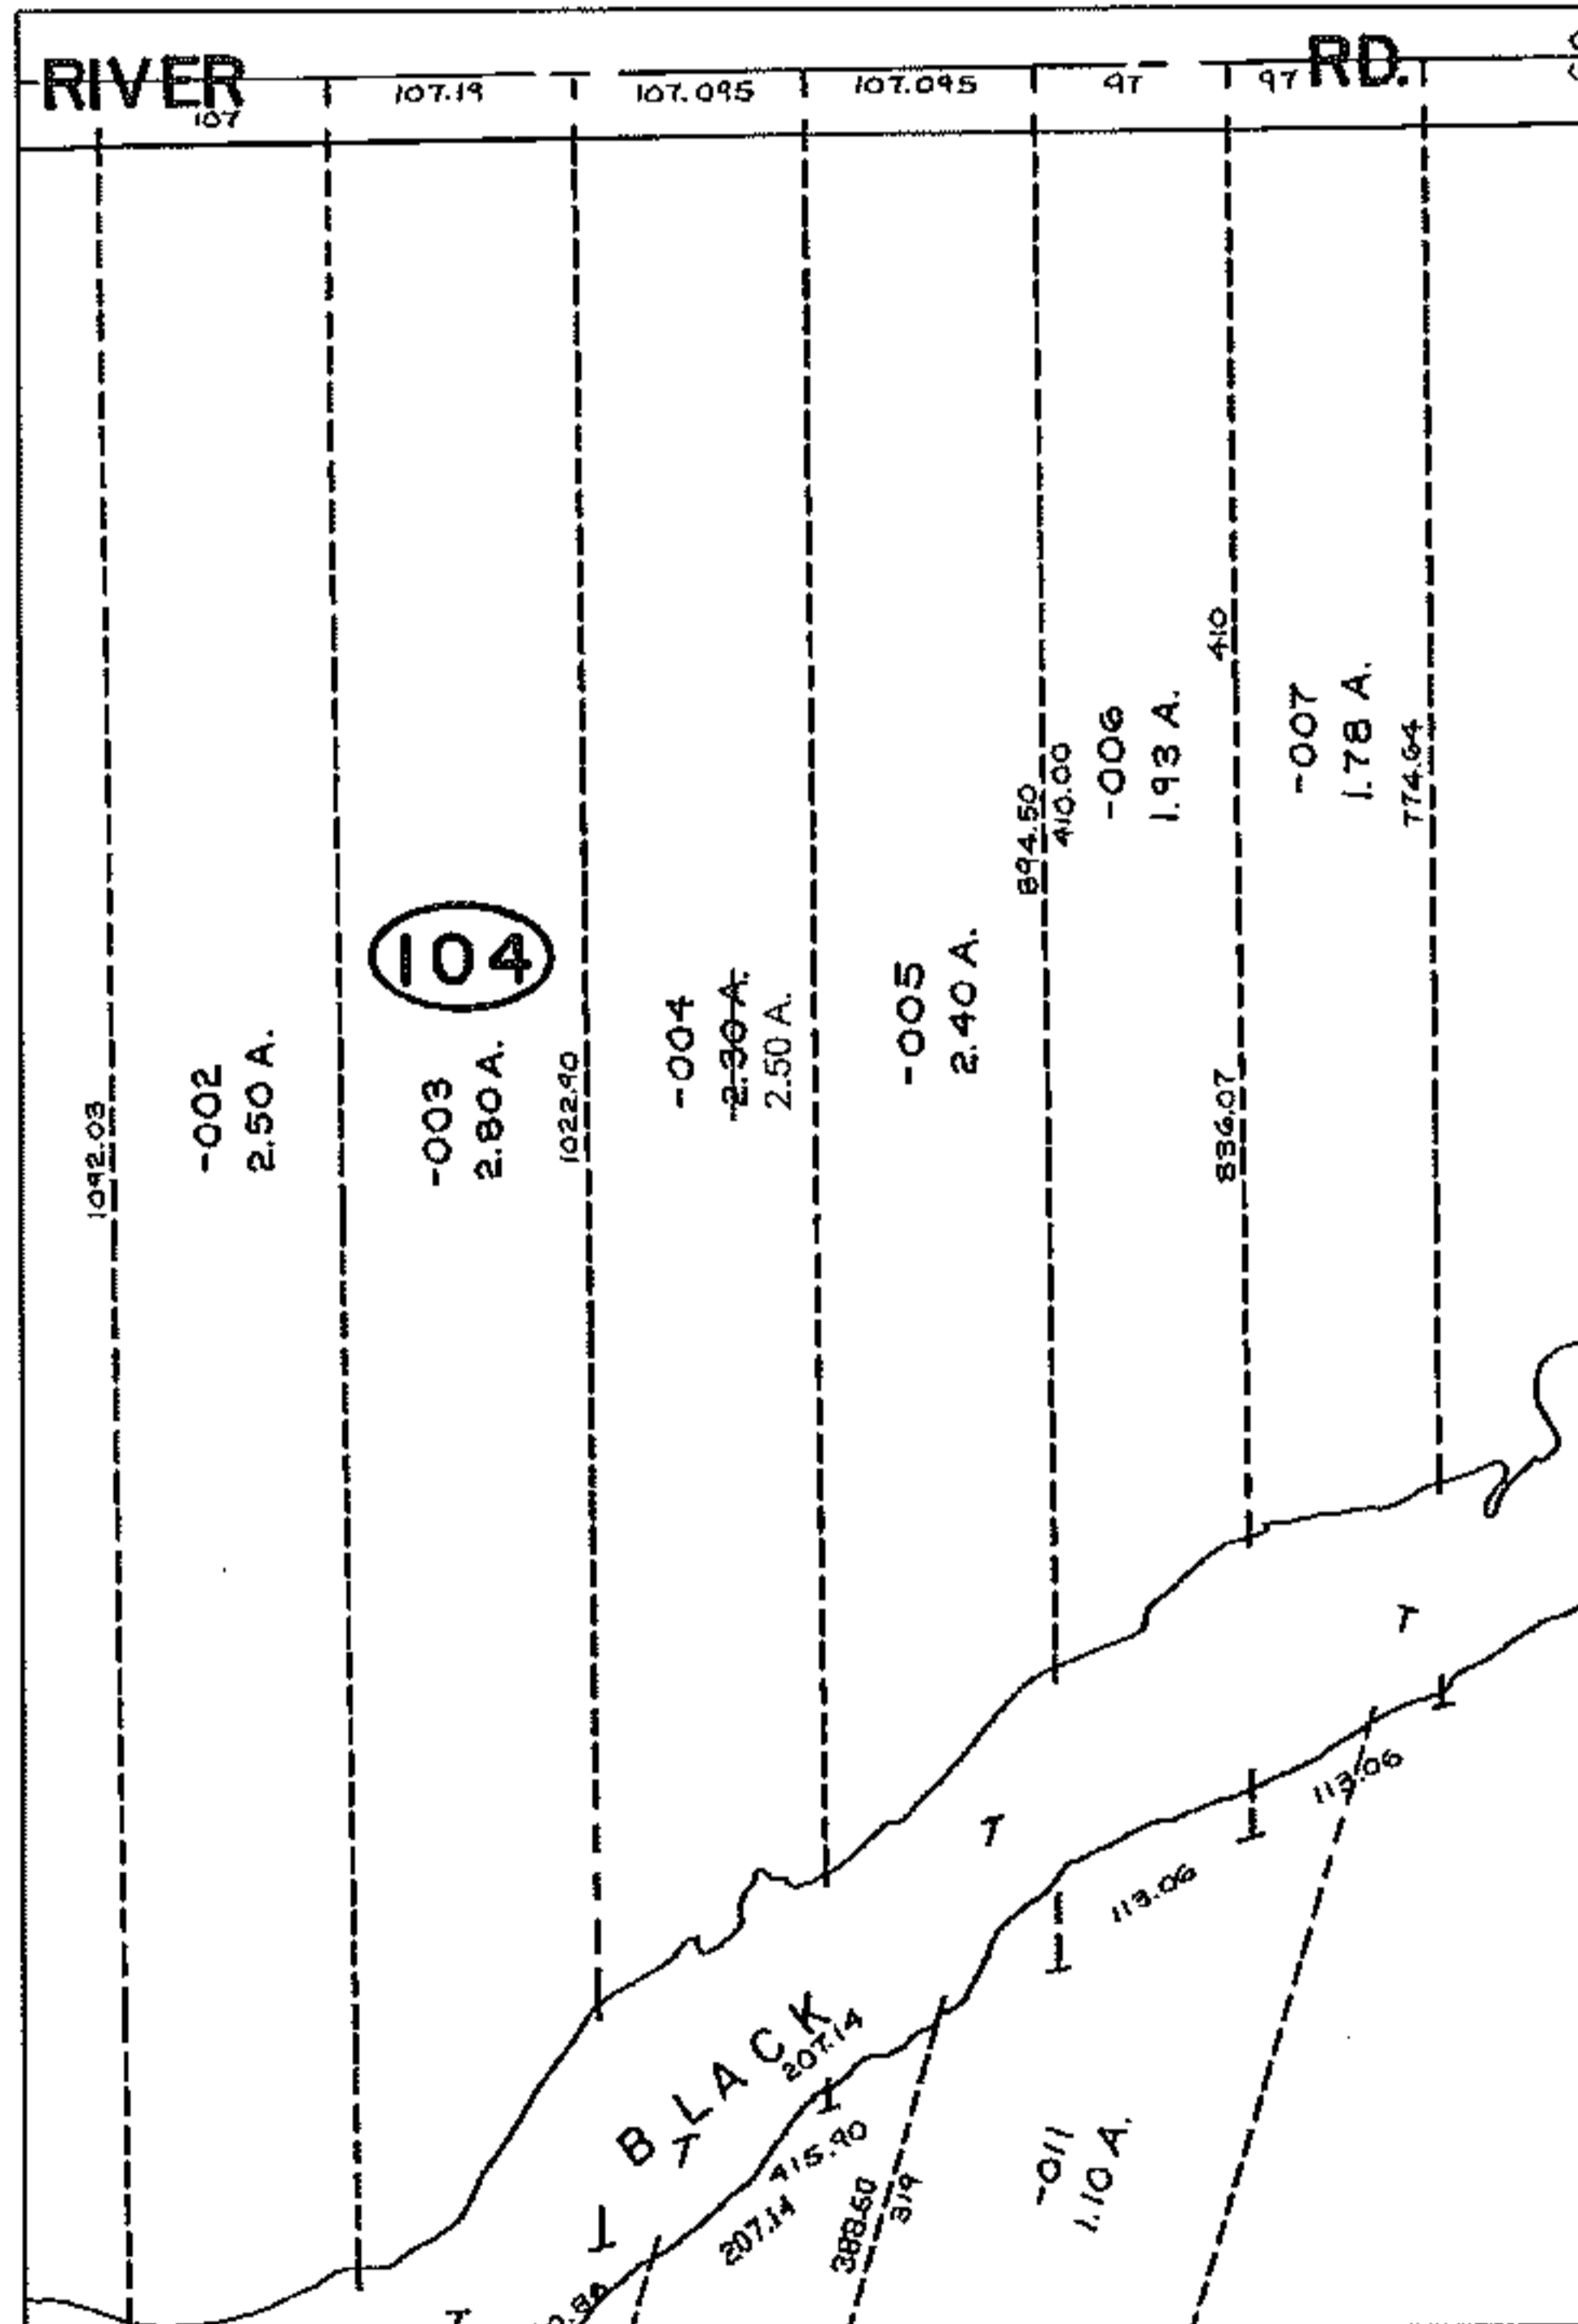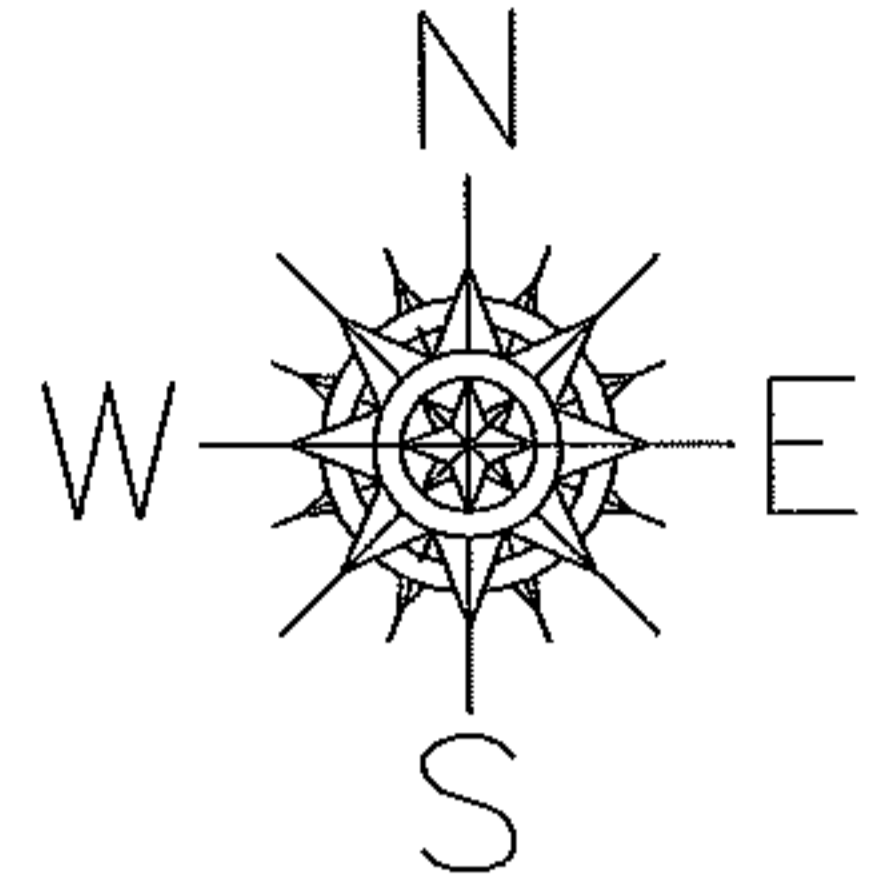

SPLITS/DEEDS PROCESSED

LORAIN COUNTY TAX MAP DEPARTMENT
226 MIDDLE AVE. ELYRIA, OHIO

SURVEYED BY: NONE

CLOSURE: NA

MAP PAGE(S): 10-00-006-B

APPROVED BY: TJS DATE: 7/18/12

SCALE: 1"=200 PRIOR INST.: DV 621/324