



RASTER

PARENT PARCEL: 04-00-029-000-625, -081, -048

CHILD PARCEL: 04-00-029-000-895

STARTING POINT: CENTERLINE OF KREBS RD & NORTH LINE OF NORFOLK & WESTERN RR

08-02541

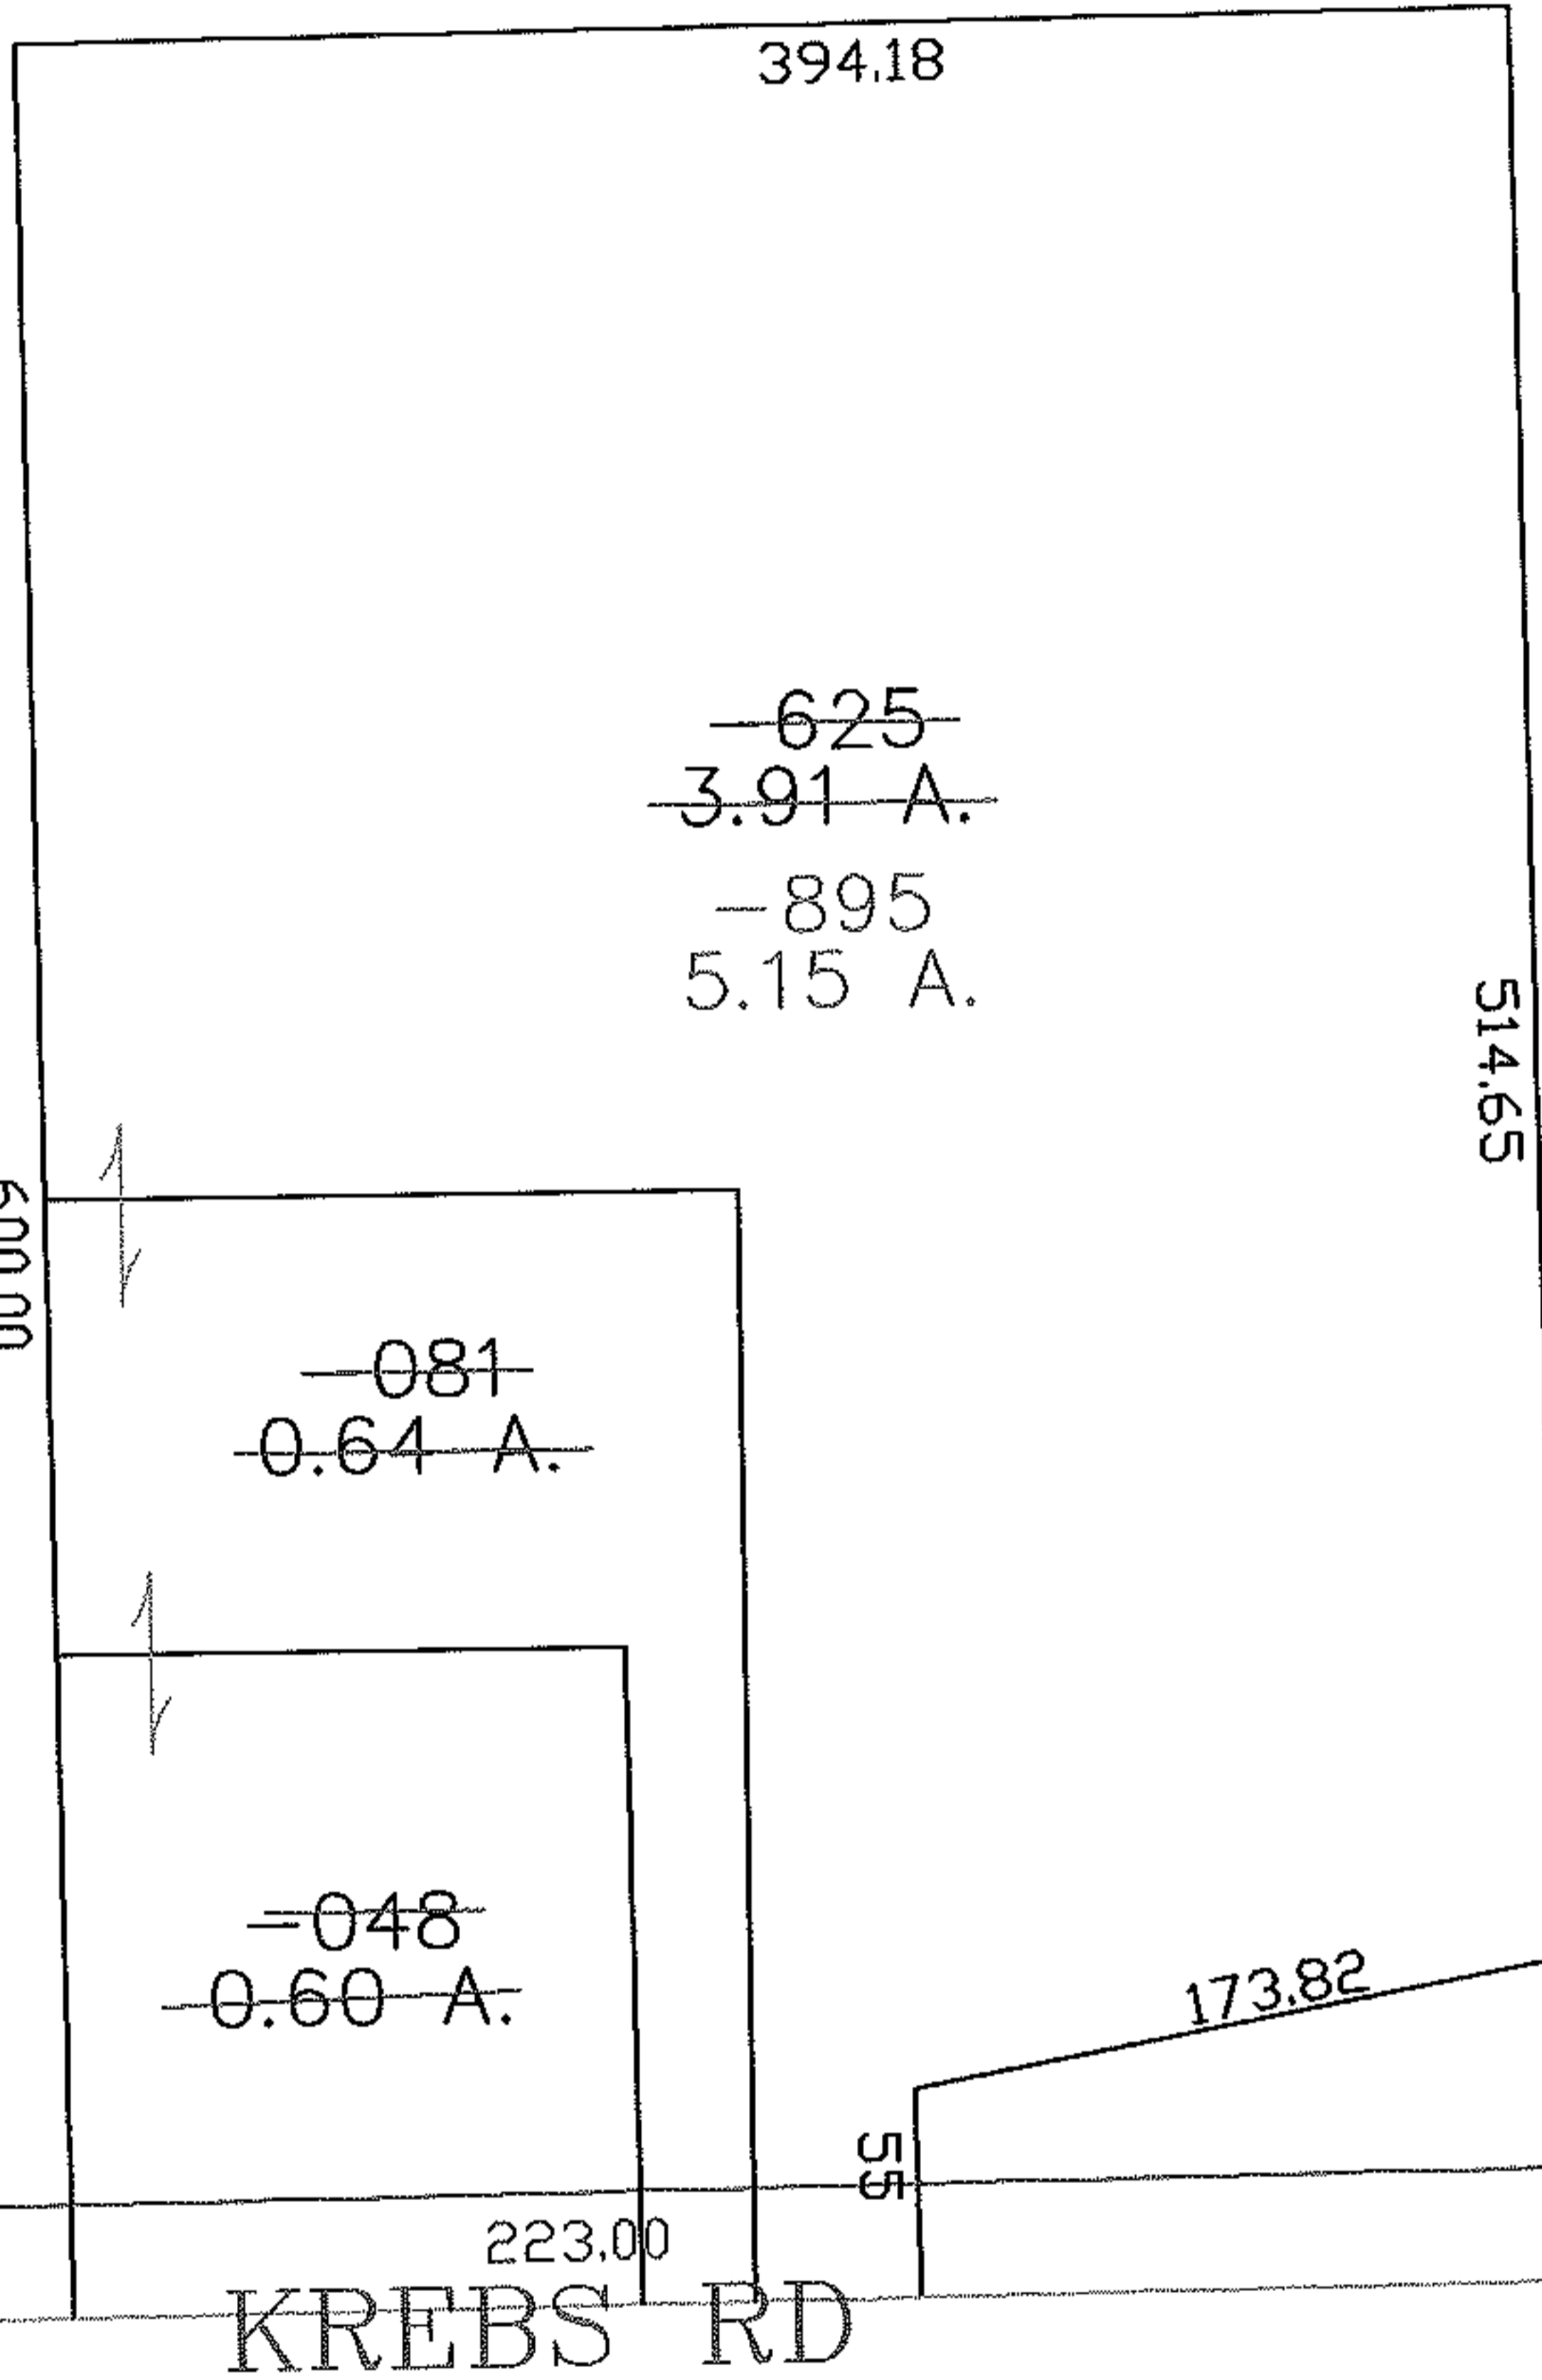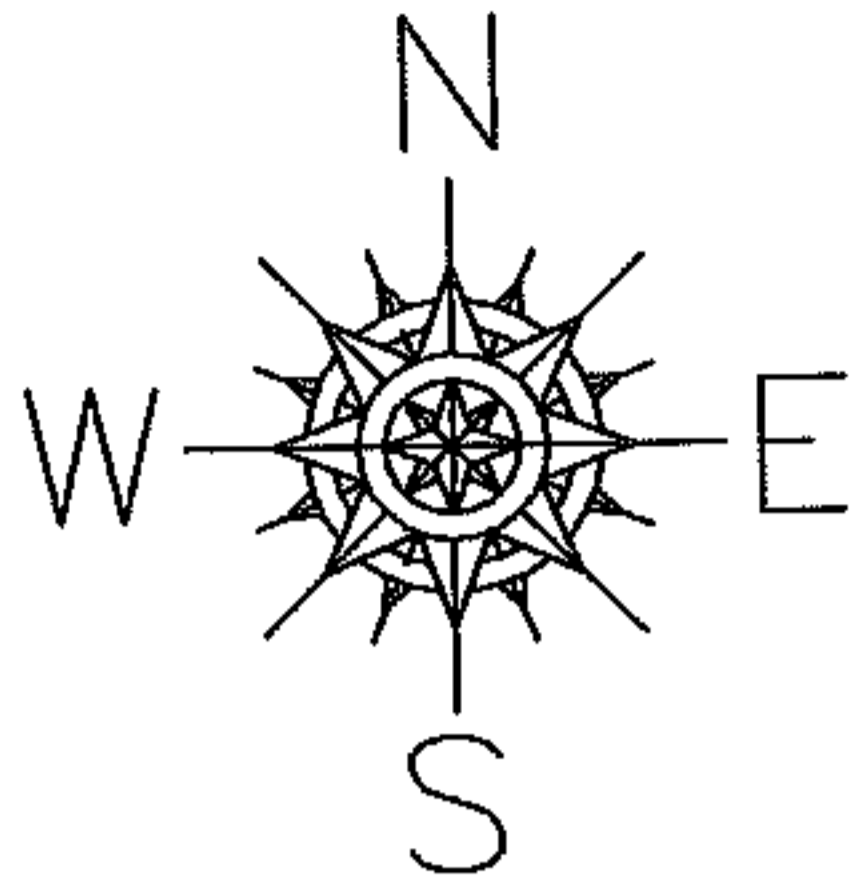

LEAR RD

KREBS RD

NORFOLK & WESTERN RR

SPLITS/DEEDS PROCESSED

LORAIN COUNTY TAX MAP DEPARTMENT  
226 MIDDLE AVE. ELYRIA, OHIO

SURVEYED BY: JAMES T SAYLER  
CLOSURE: 0.00 : 10.000  
MAP PAGE(S): 04-00-029-G  
APPROVED BY: JAH DATE: 3-12-08  
SCALE: 1" = 100 PRIOR INSTRUMENT: 19990595234