




RASTER

PARENT PARCEL: 03-00-076-114-026

CHILD PARCEL: 03-00-076-114-028, -029

STARTING POINT: CENTERLINE OF WEST RIVER RD & NORTH RIDGE RD

08-02543

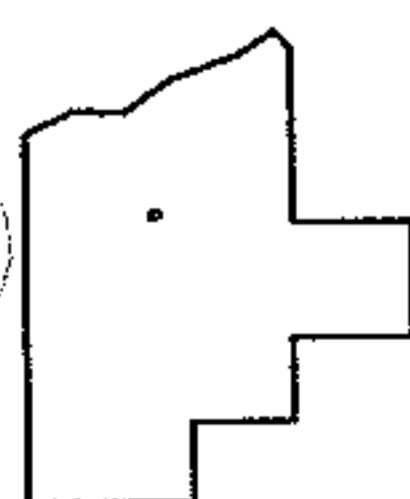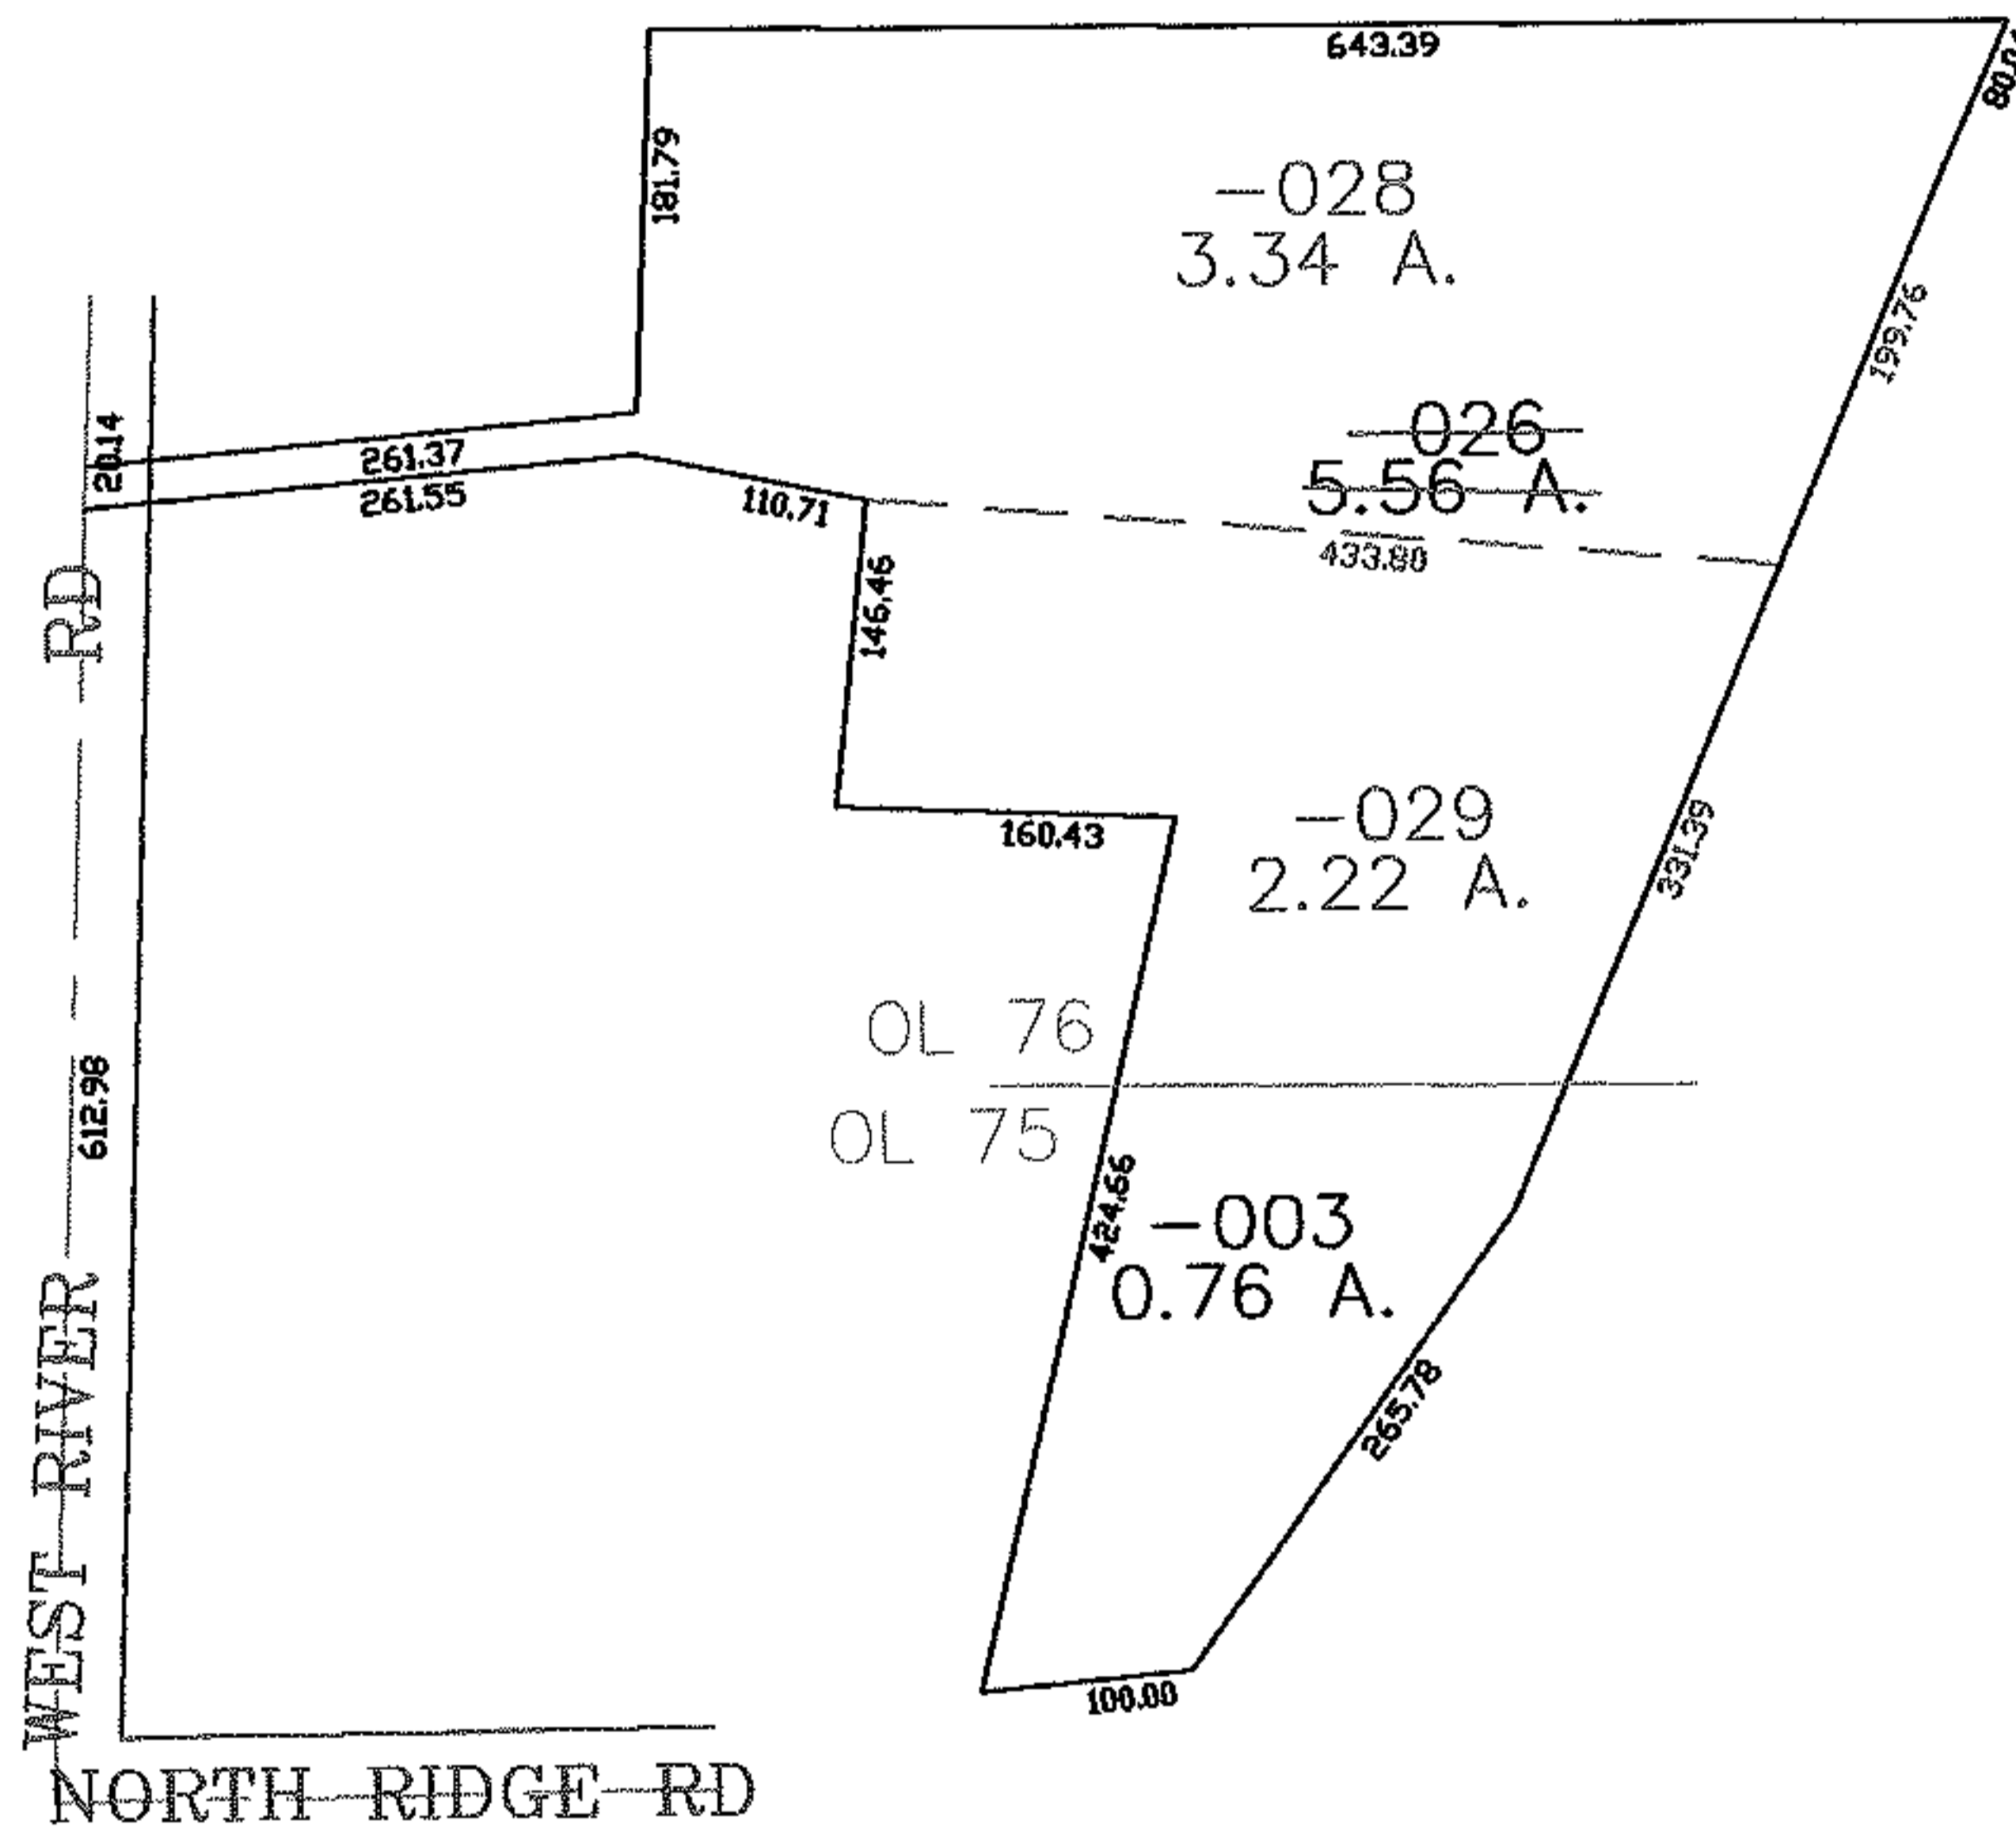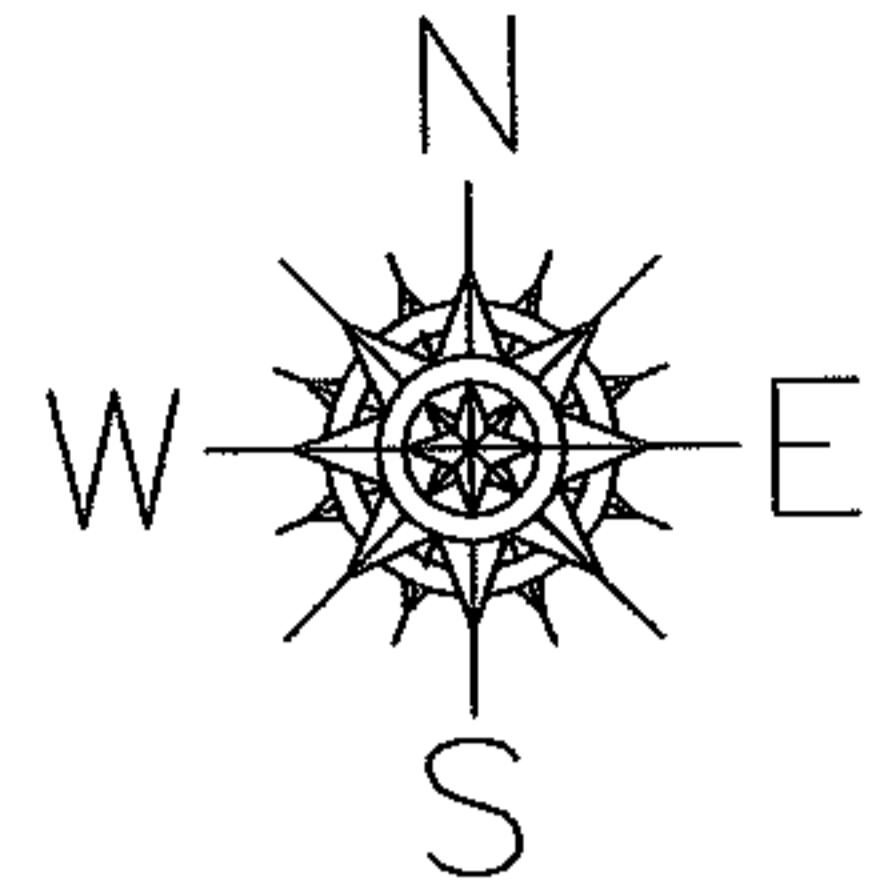

SPLITS/DEEDS PROCESSED
 LORAIN COUNTY TAX MAP DEPARTMENT
 226 MIDDLE AVE. ELYRIA, OHIO

SURVEYED BY: CHRISTOPHER HIRZEL
 CLOSURE: 0.00 : 10.000
 MAP PAGE(S): 03-00-075-C
 APPROVED BY: JAH DATE: 3-17-08
 SCALE: 1" = 200 PRIOR INSTRUMENT: 20070197875