


PARENT PARCEL: 02-02-008-107-044


CHILD PARCEL: 02-02-008-107-045, -046

STARTING POINT: CENTERLINE OF JAEGER RD & O.L. 8

08-02545

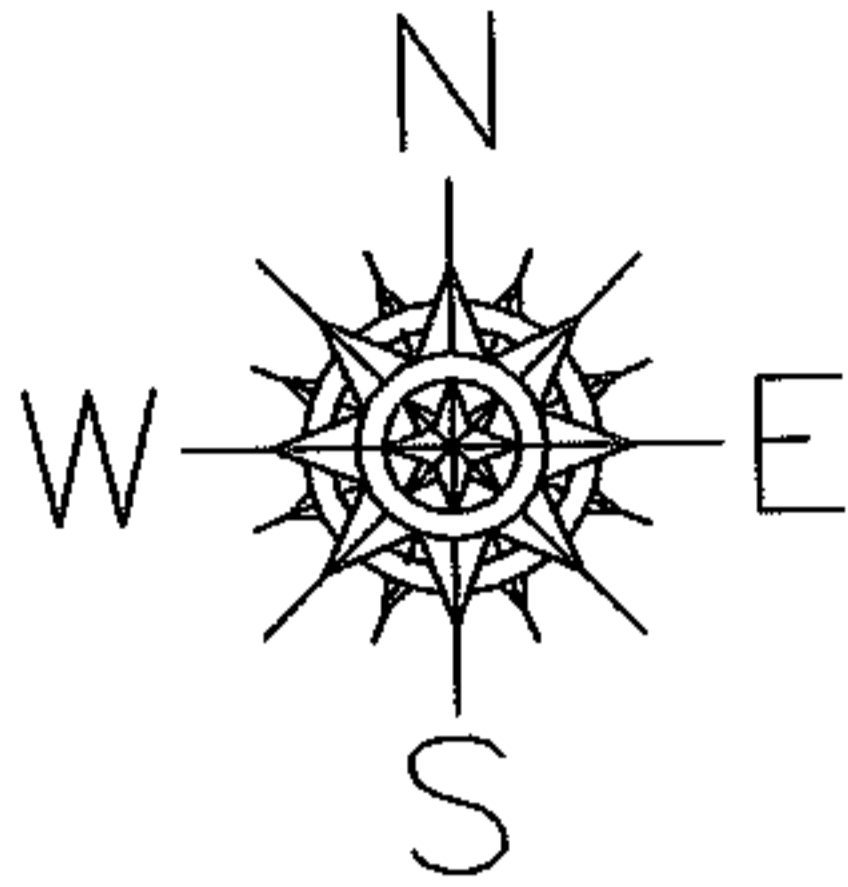

O.L. 13
O.L. 8

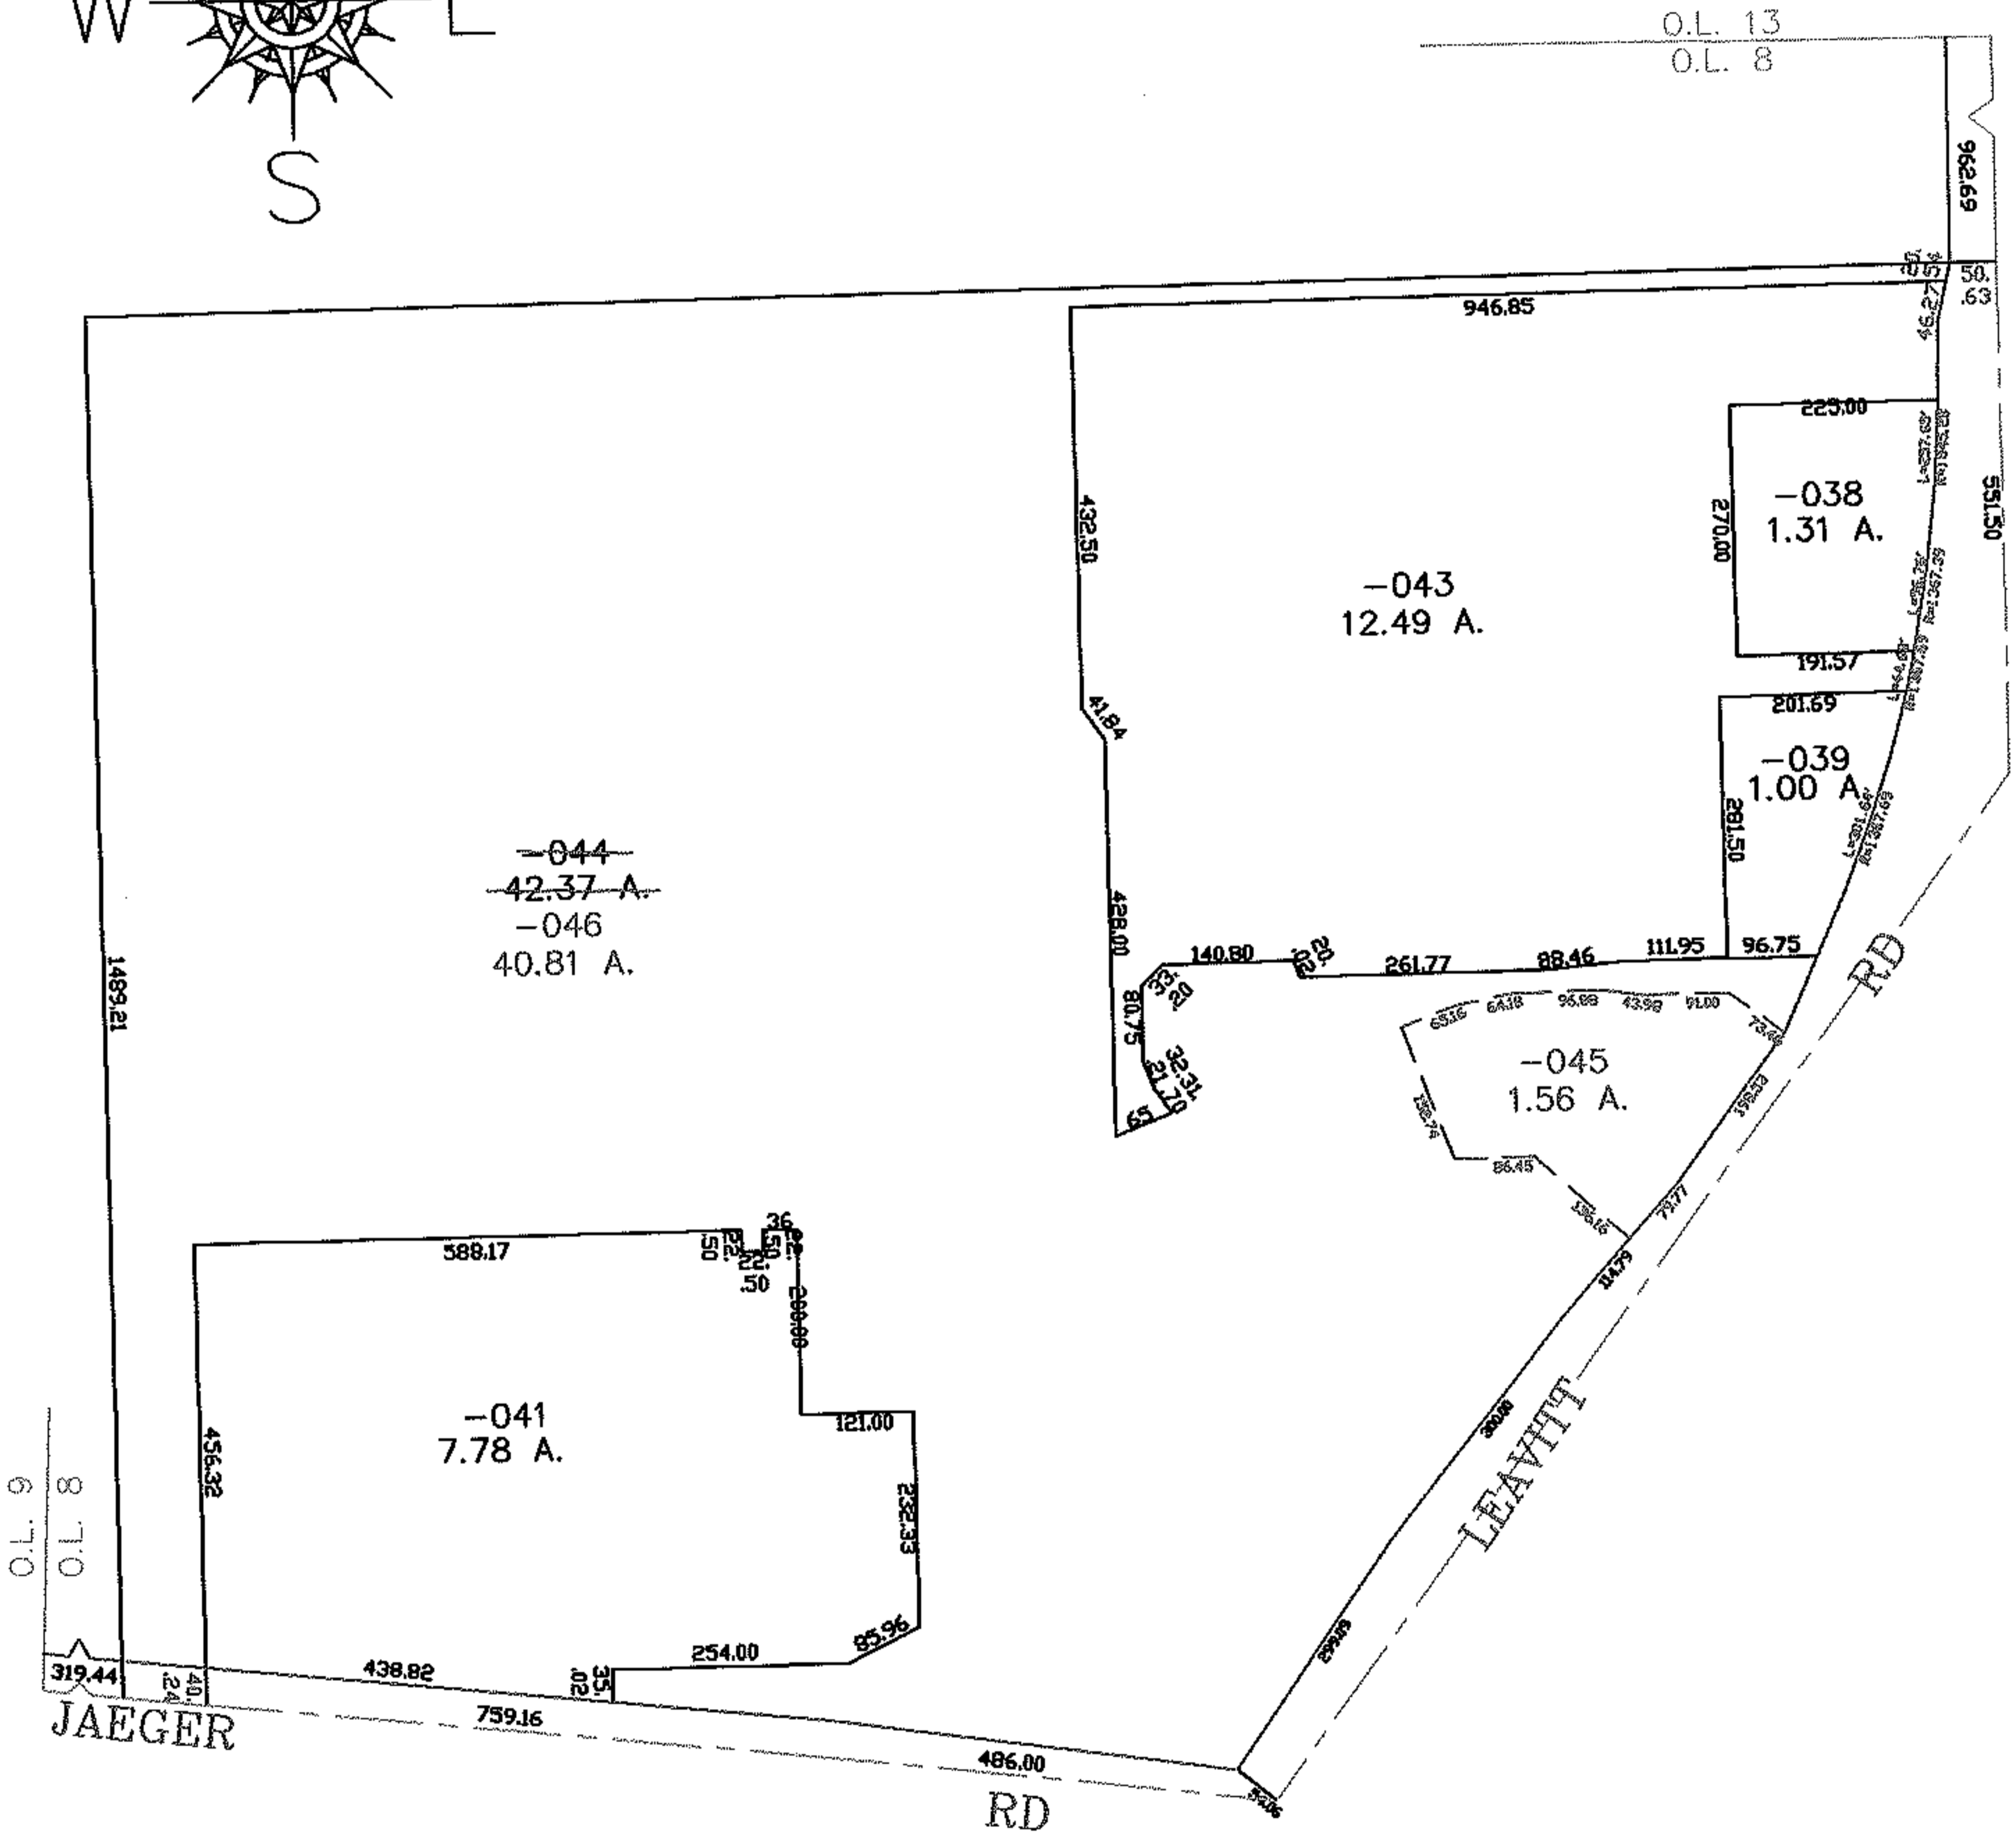

~~-044~~
~~42.37 A.~~
-046
40.81 A.

-041
7.78 A.

-043
12.49 A.

-038
1.31 A.

-039
1.00 A.

-045
1.56 A.

6.70
8.70

JAEGER

LEAVITT

RD



SPLITS/DEEDS PROCESSED

LORAIN COUNTY TAX MAP DEPARTMENT
226 MIDDLE AVE. ELYRIA, OHIO

SURVEYED BY: JAMES E. KARING
CLOSURE: 0.00 : 10.000
MAP PAGE(S): 02-02-008-A,B
APPROVED BY: JAH DATE: 3-27-08
SCALE: 1" = 300 PRIOR INSTRUMENT: 19980514138