
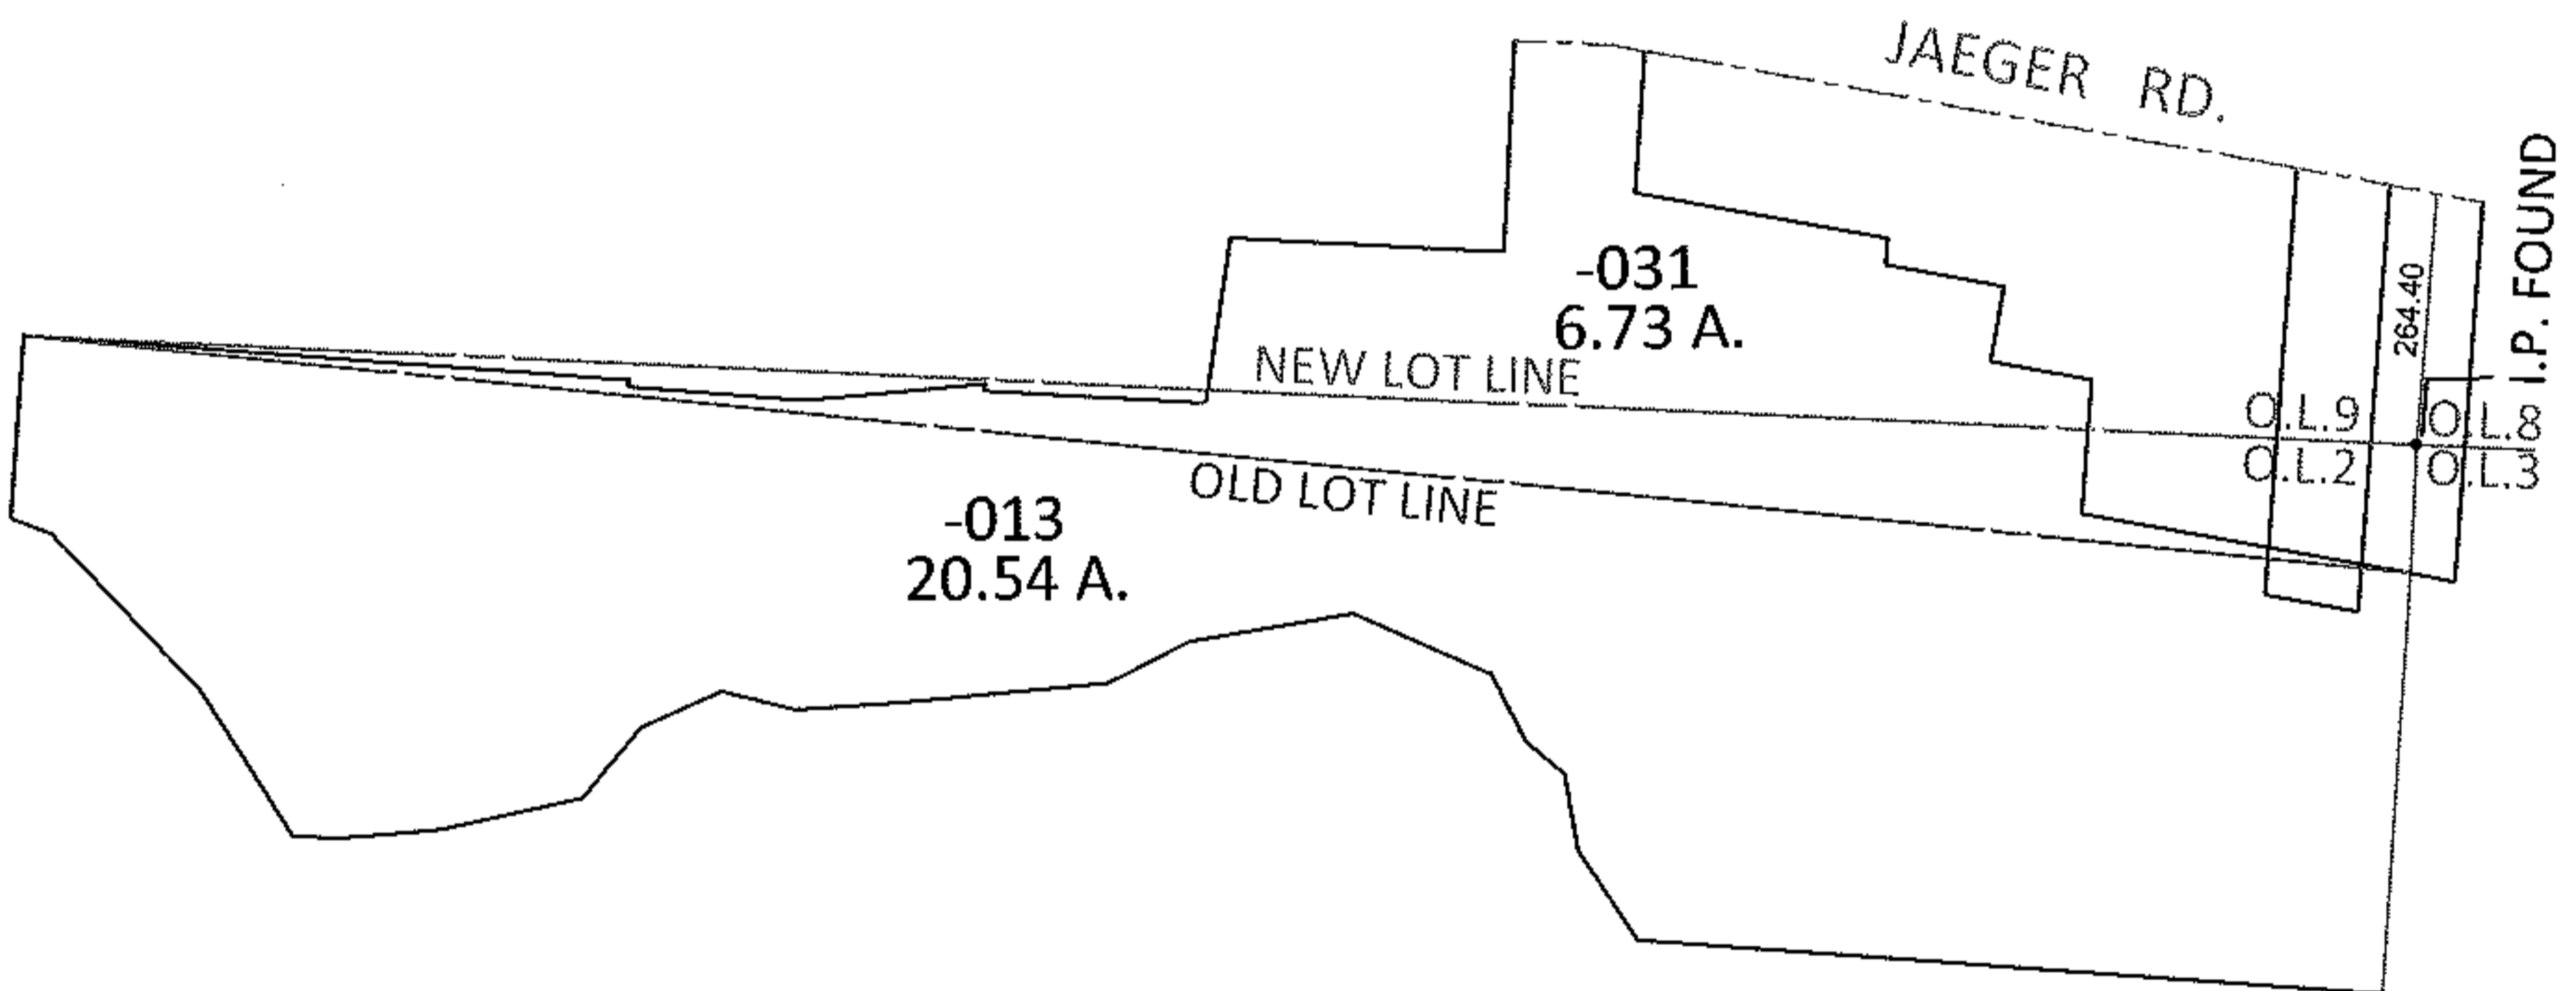


PARENT PARCEL: 02-02-009-102-XXX, 02-02-008-107-XXX

12-02548-C


CHILD PARCEL: _____

STARTING POINT: _____

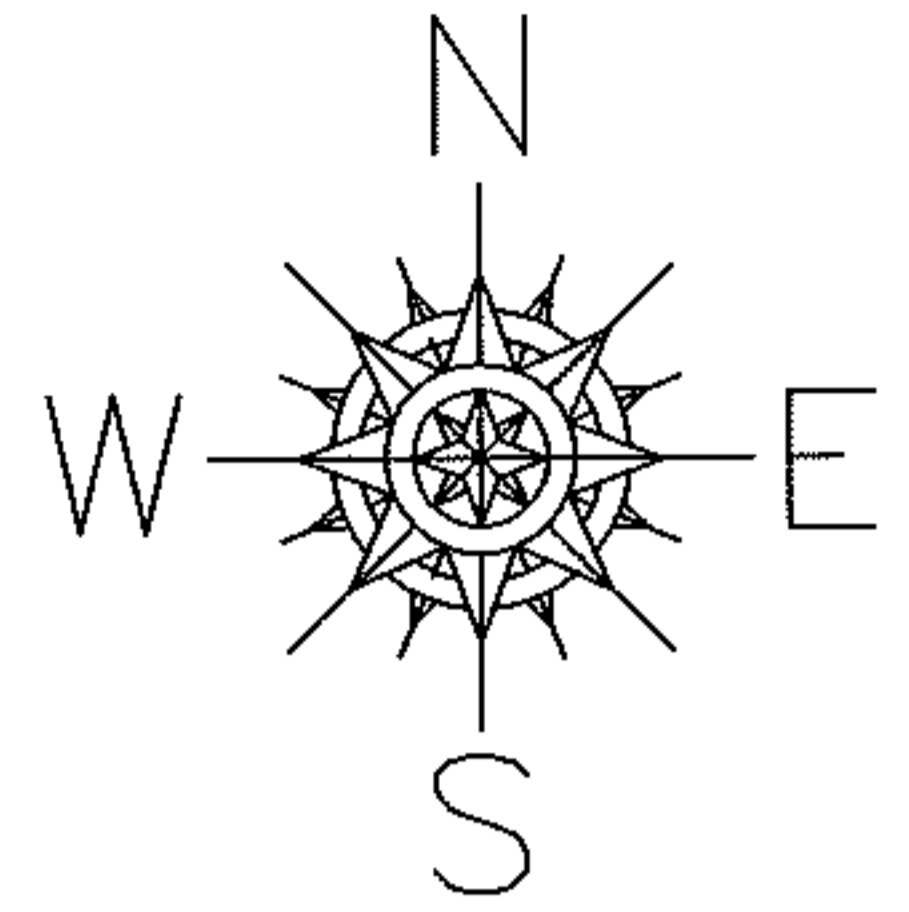

MAP CORRECTION ONLY

PER SURVEY BY JOHN MENO ON APRIL 3, 1973
ON FILE IN SURVEY BANK #20335
AND DEEDS #20090308754 &
#20060128363

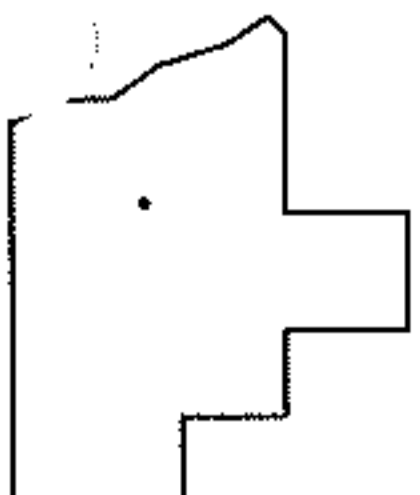

SPLITS/DEEDS PROCESSED

LORAIN COUNTY TAX MAP DEPARTMENT
226 MIDDLE AVE. ELYRIA, OHIO

SURVEYED BY: JOHN MENO

CLOSURE: N/A

MAP PAGE(S): 2-02-009-A & B

APPROVED BY: RRM DATE: 8-6-12

SCALE: 1" = 400 PRIOR INST.: SEE ABOVE