




RASTER

PARENT PARCEL: 01-00-063-000-047

CHILD PARCEL: 01-00-063-000-048, -049

STARTING POINT: SOUTHEAST CORNER OF O.L. 63

08-02548

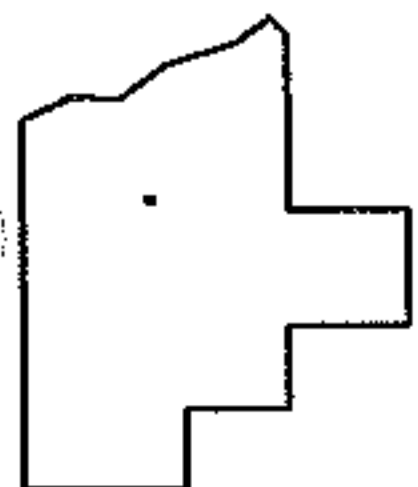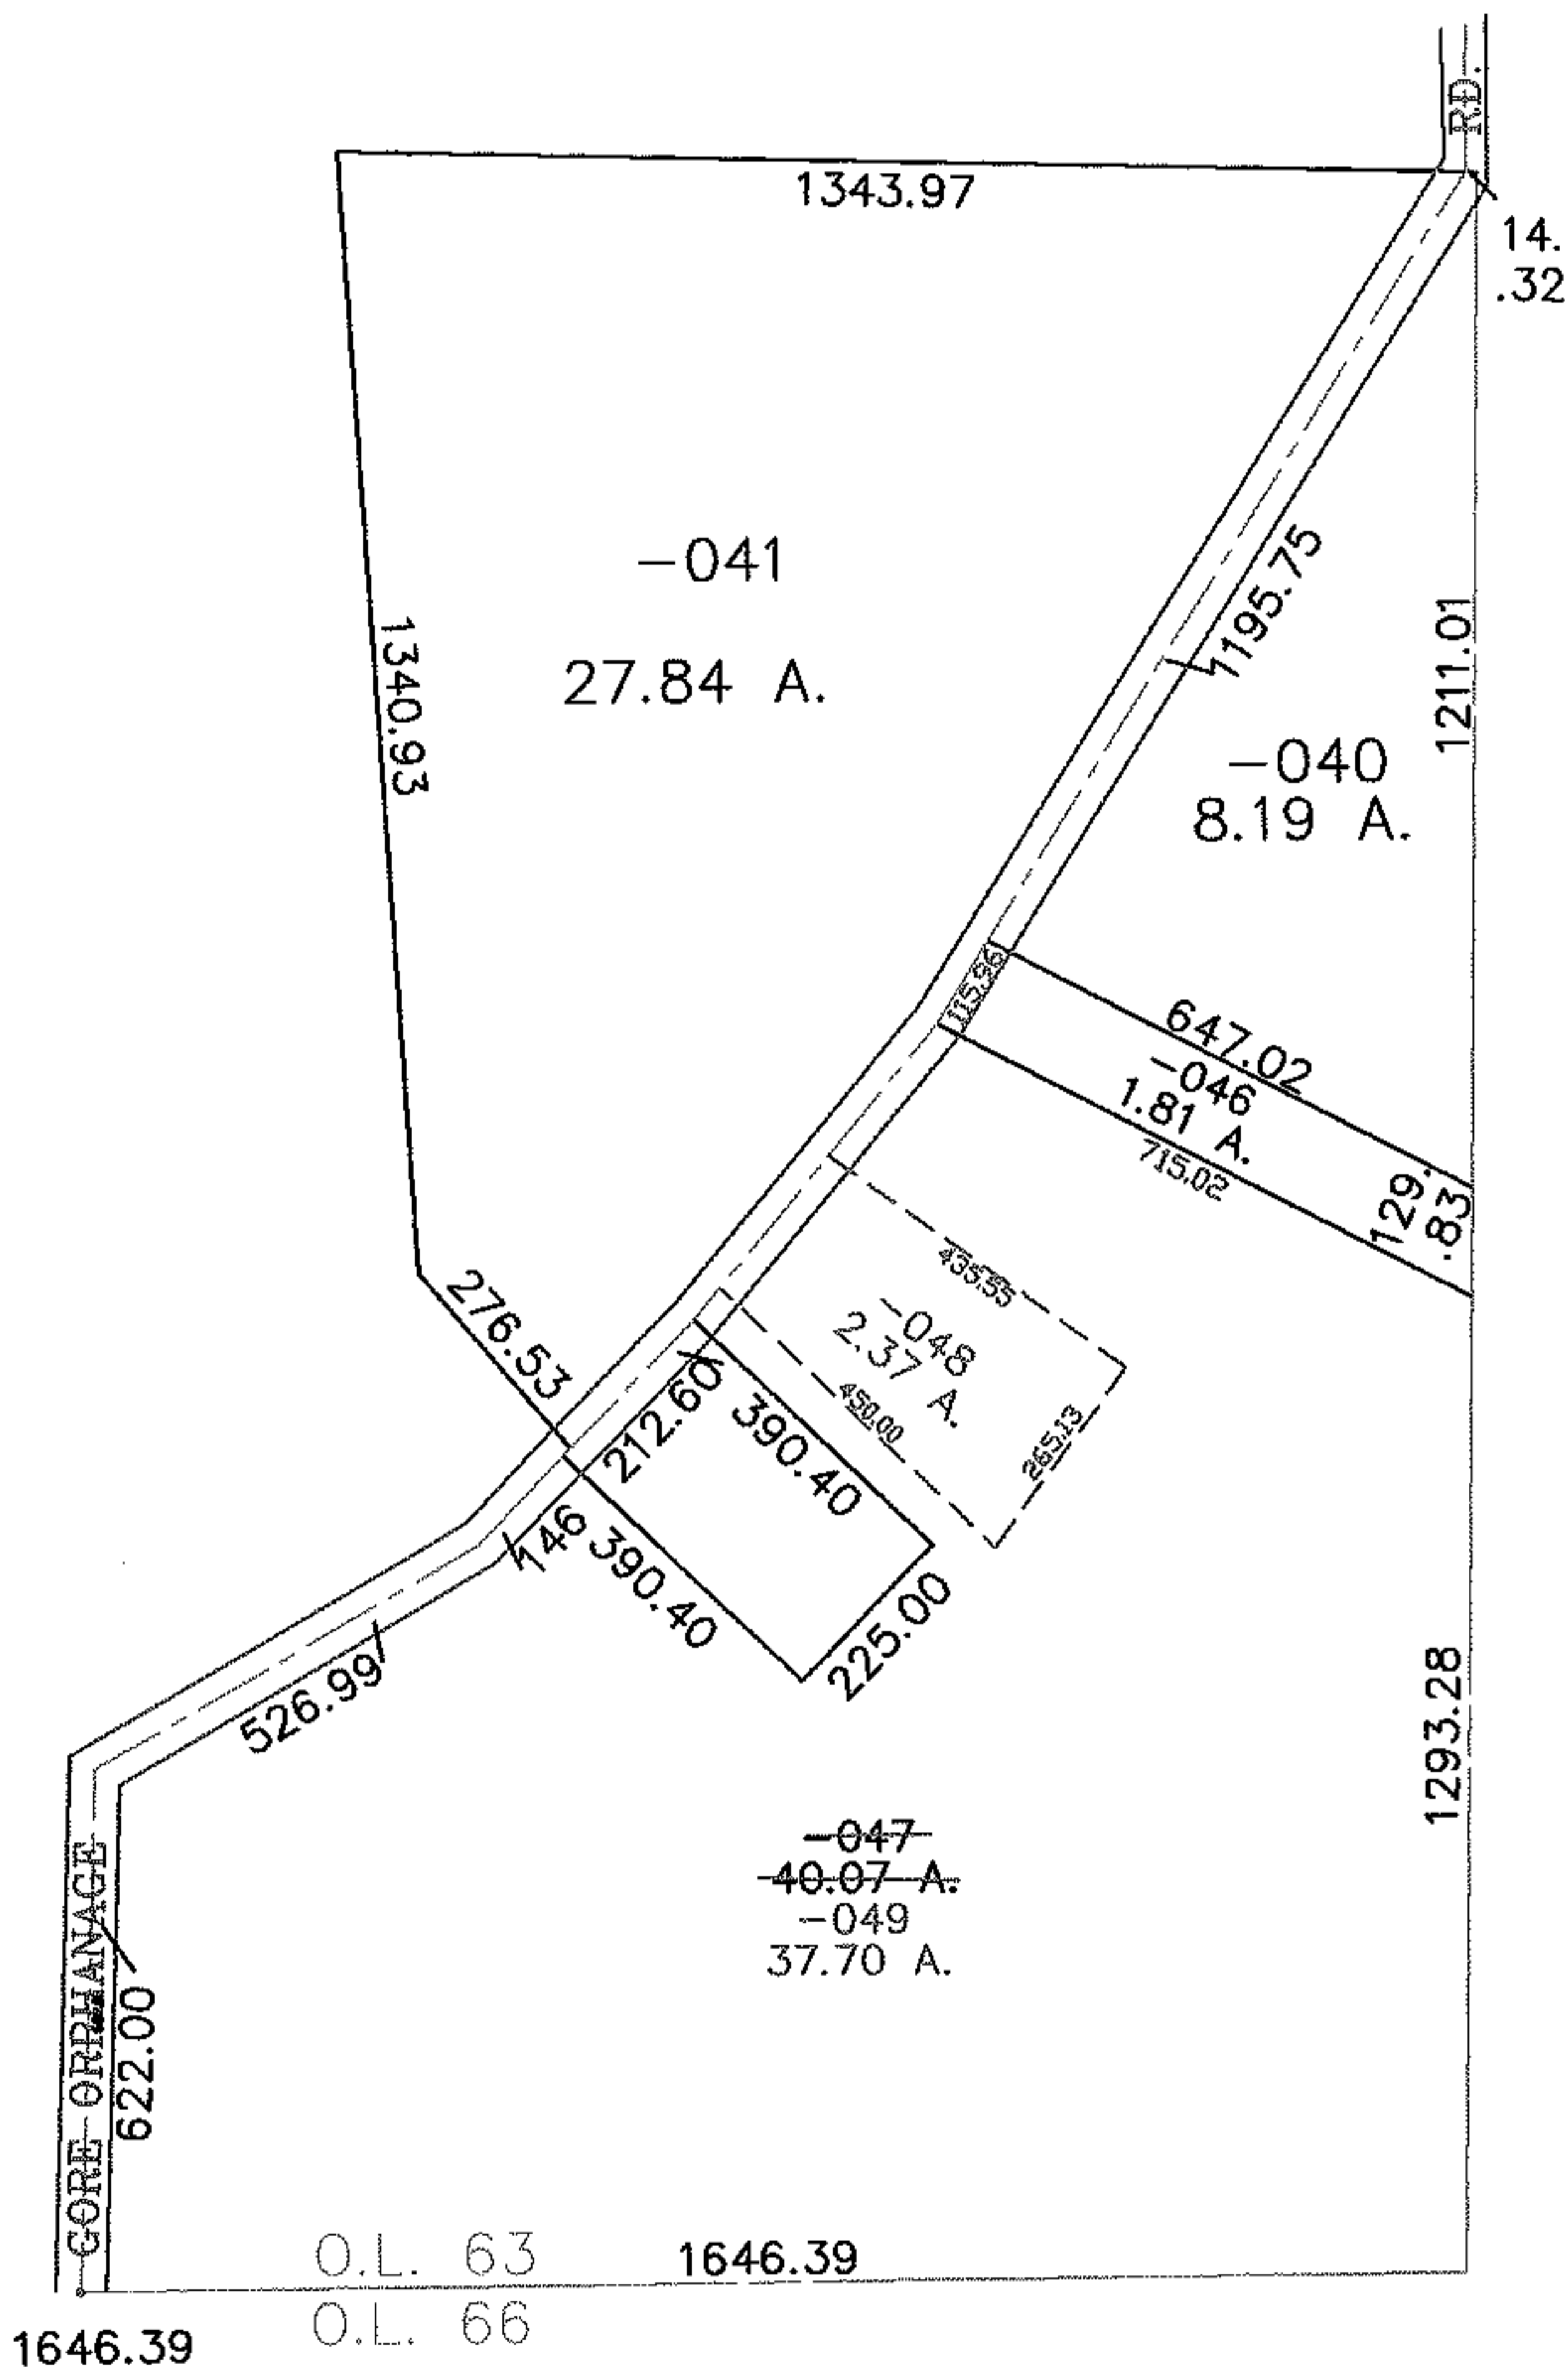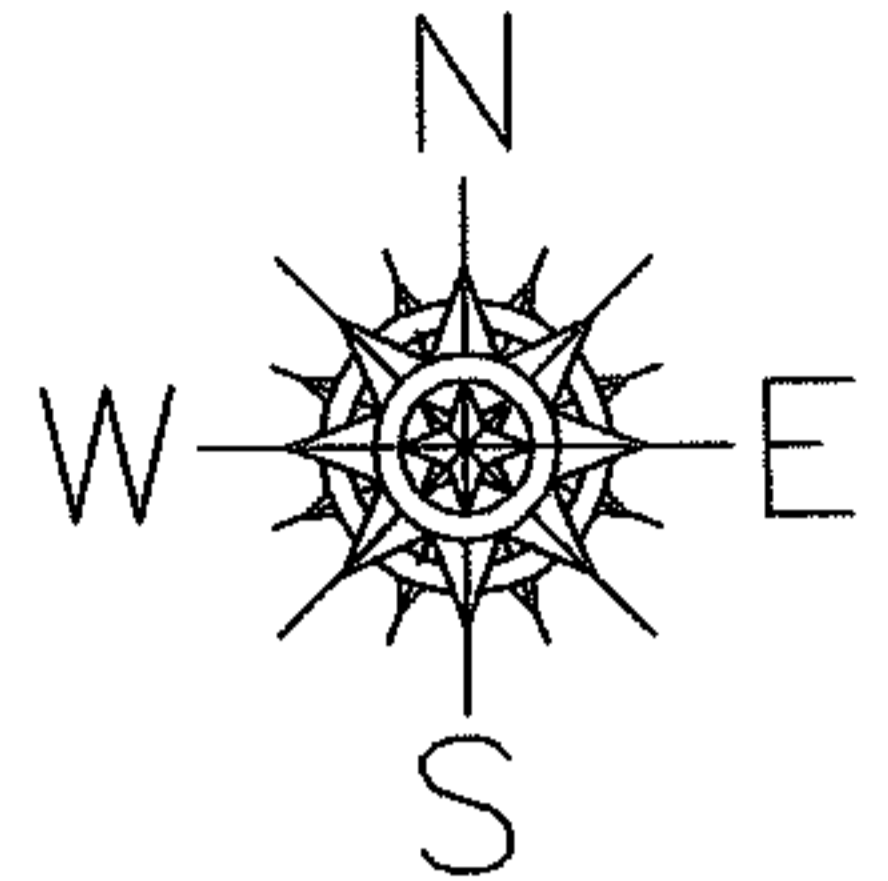

SPLITS/DEEDS PROCESSED
 LORAIN COUNTY TAX MAP DEPARTMENT
 226 MIDDLE AVE. ELYRIA, OHIO

SURVEYED BY: CHARLES WARYU
 CLOSURE: 0.00 : 10.000
 MAP PAGE(S): 1-1
 APPROVED BY: JAH DATE: 4-4-08
 SCALE: 1" = 400 PRIOR INSTRUMENT: 20030935060