

PARENT PARCEL: 06-23-008-102-023

CHILD PARCEL: XX-XX-XXX-XXX-XXX

STARTING POINT: S.E. CORNER OF S/L 11 IN FRANK YUHAS SUB. NO. 1

12-02549-A



ACREAGE CORRECTION

06-23-008-102-023

~~0.36 A.~~

0.35 A.

CORR. PER SURV.  
W. BARBOSA

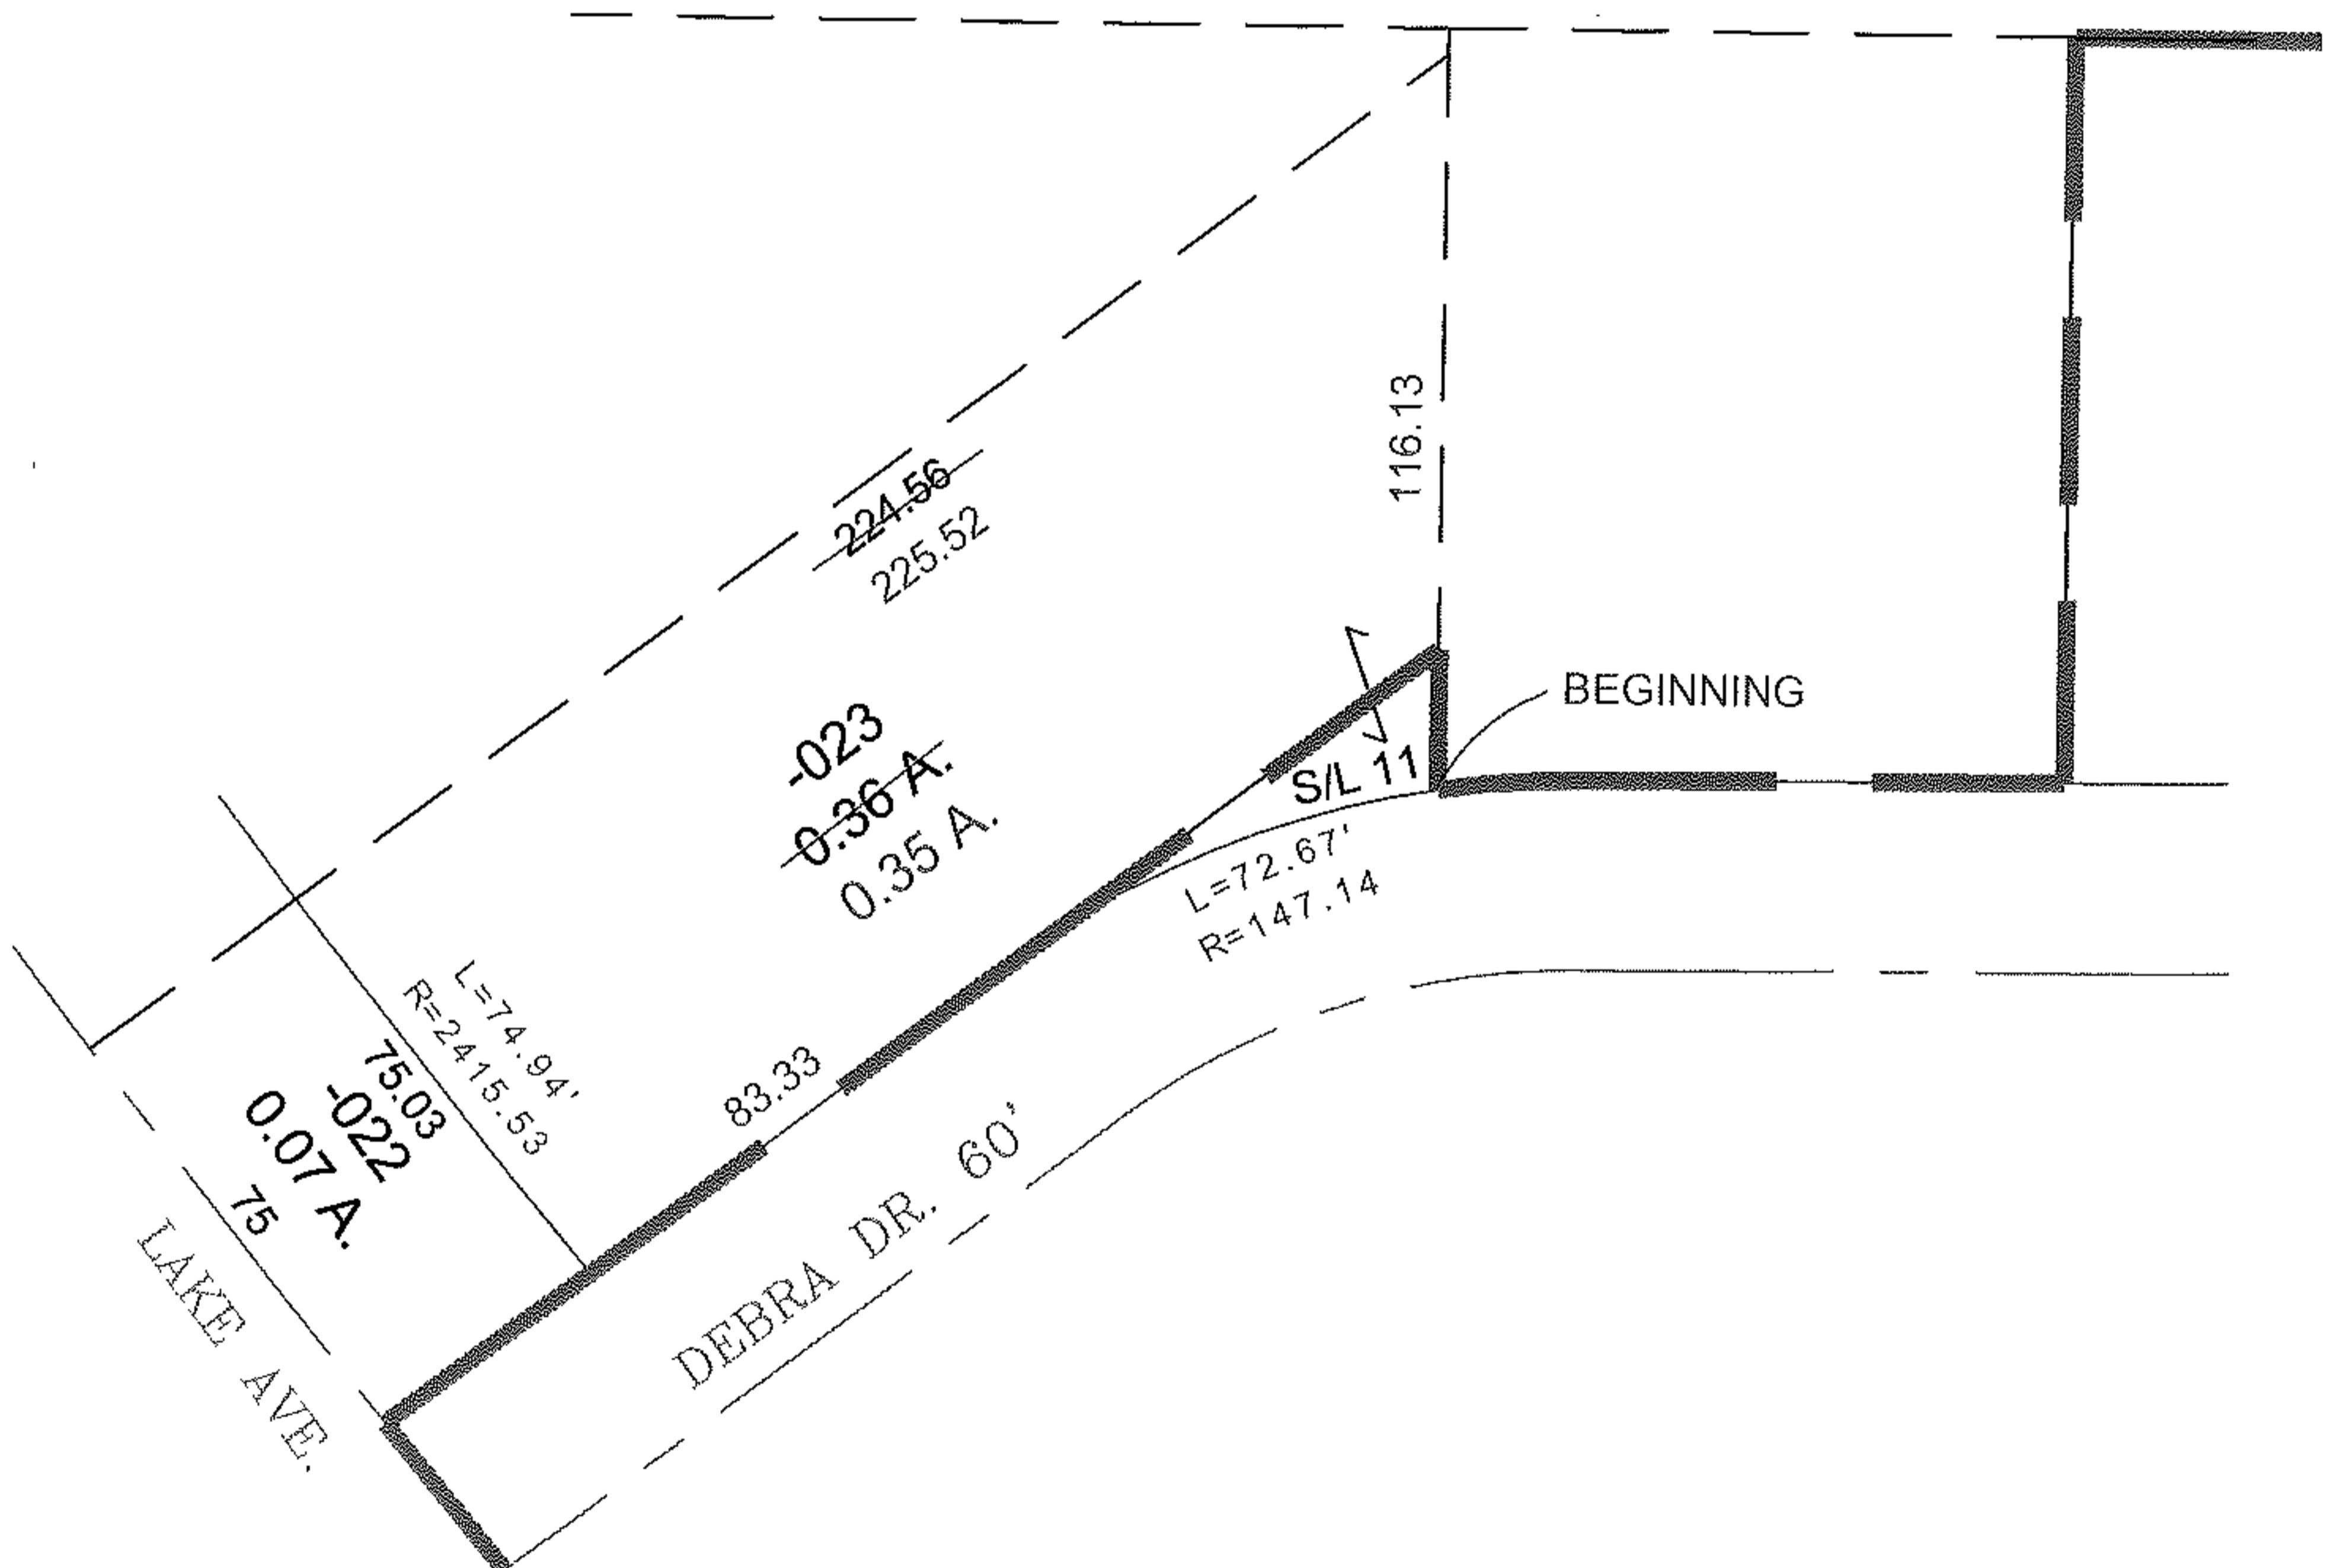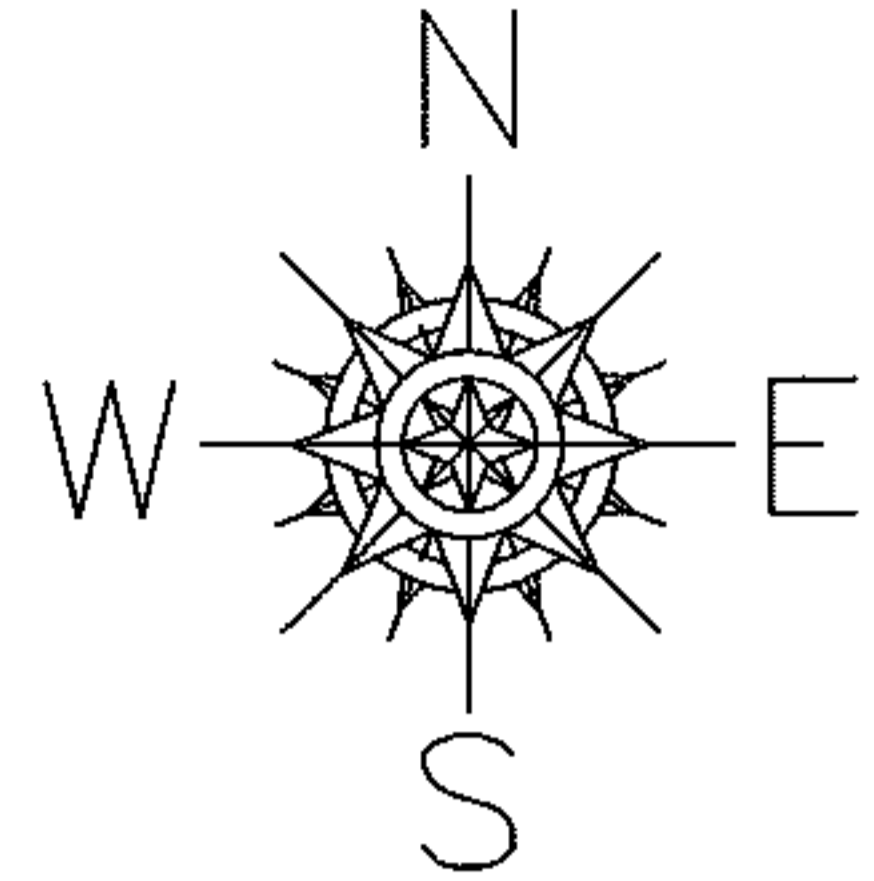

SPLITS/DEEDS PROCESSED

LORAIN COUNTY TAX MAP DEPARTMENT  
226 MIDDLE AVE. ELYRIA, OHIO

SURVEYED BY: WILFREDO BARBOSA

CLOSURE: 0.01 : 10,000

MAP PAGE(S): 6-24

APPROVED BY: TJS DATE: 8/15/12

SCALE: 1"= 50' PRIOR INST.: DV XXXX/XXX