




RASTER

PARENT PARCEL: 16-00-008-000-012, -009

08-02550

CHILD PARCEL: 16-00-008-000-018, -019

STARTING POINT: CENTERLINE OF ISLAND RD & GRAFTON/EATON TWP LINE

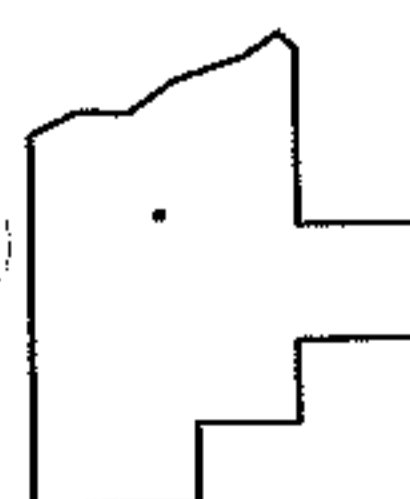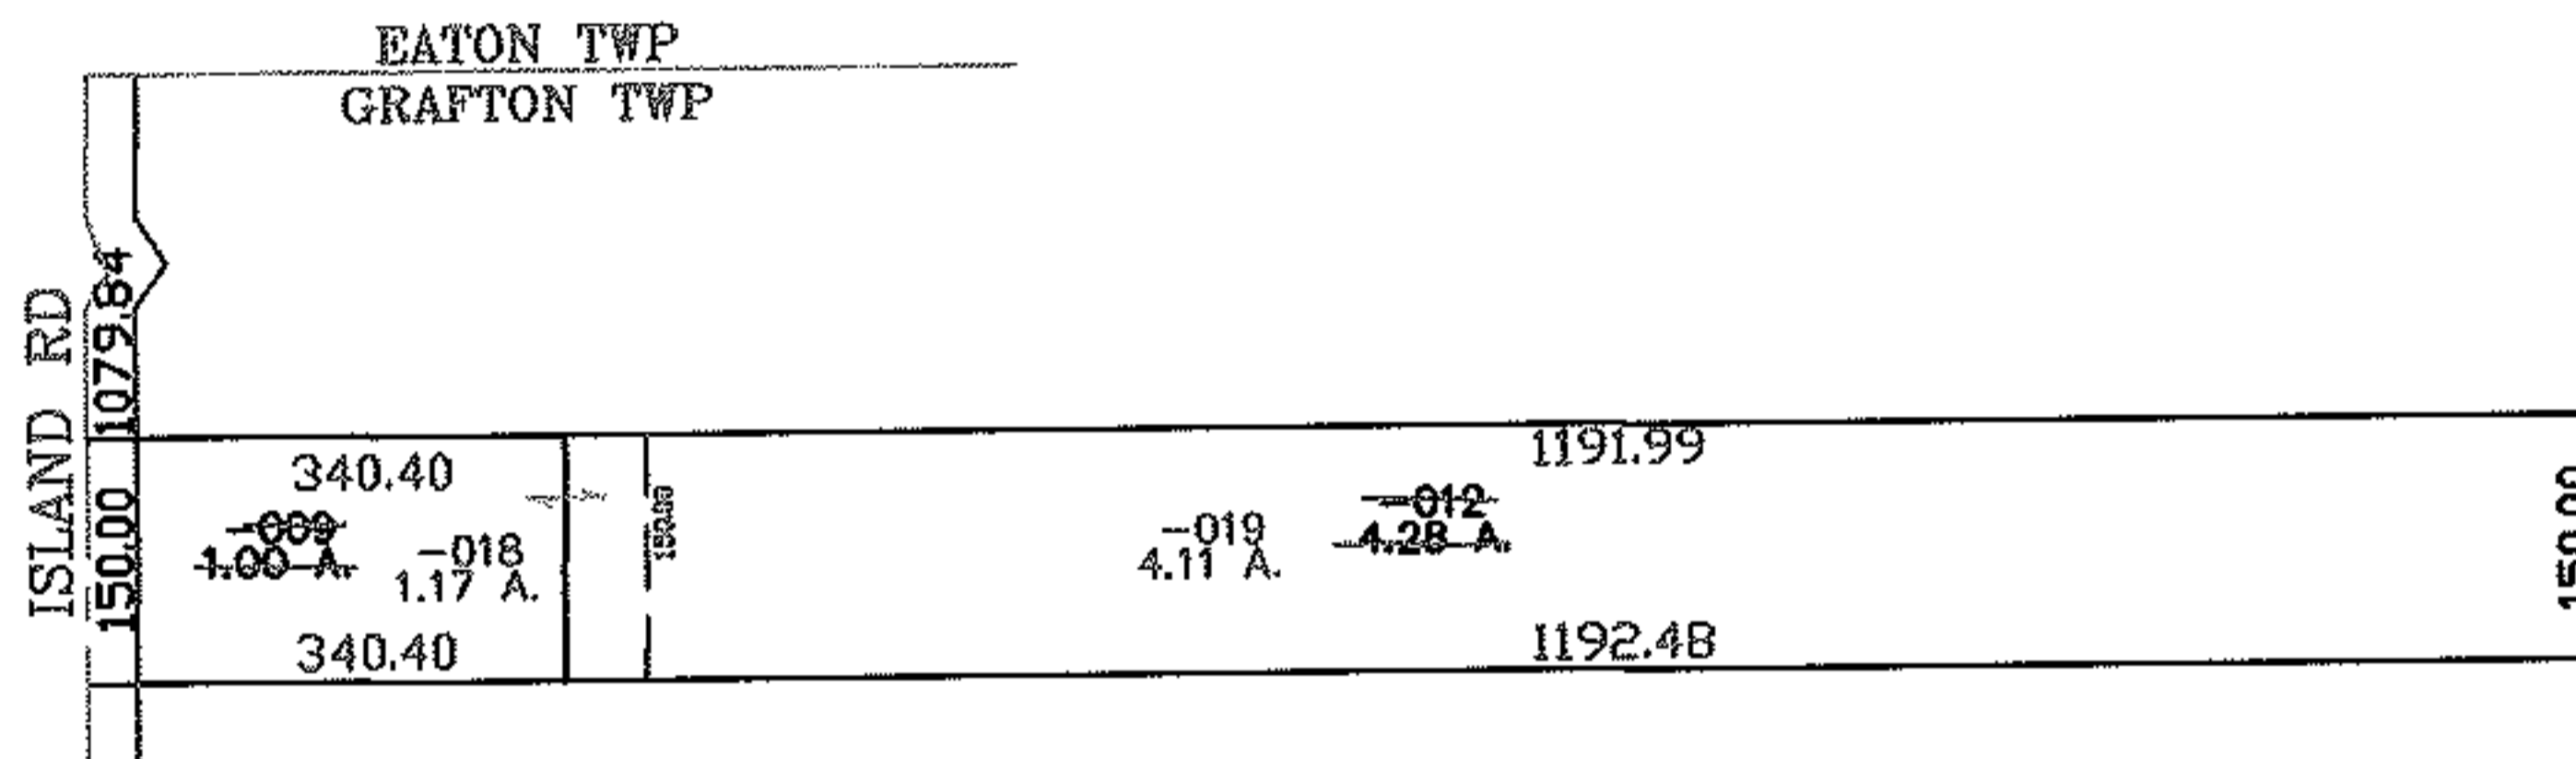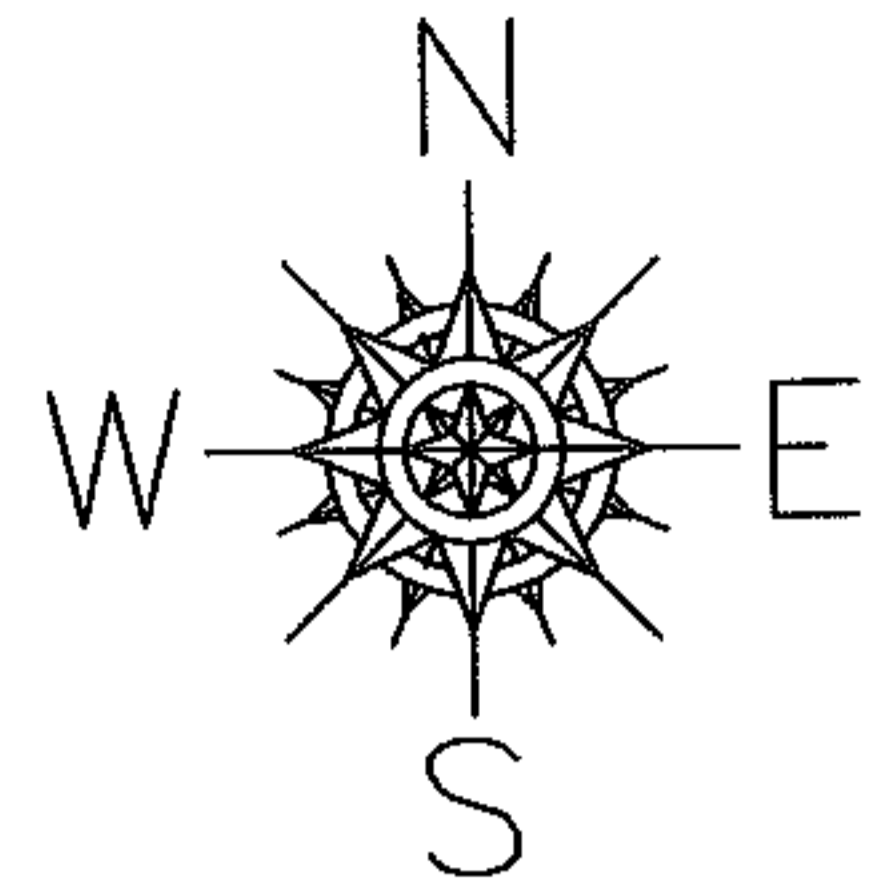

**SPLITS/DEEDS PROCESSED**  
**LORAIN COUNTY TAX MAP DEPARTMENT**  
**226 MIDDLE AVE. ELYRIA, OHIO**

SURVEYED BY: RICHARD CARLSON  
 CLOSURE: 0.00 : 10.000  
 MAP PAGE(S): 16-00-008-A  
 APPROVED BY: JAH DATE: 4-9-08  
 SCALE: 1" = 300 PRIOR INSTRUMENT: DV 1073/98