
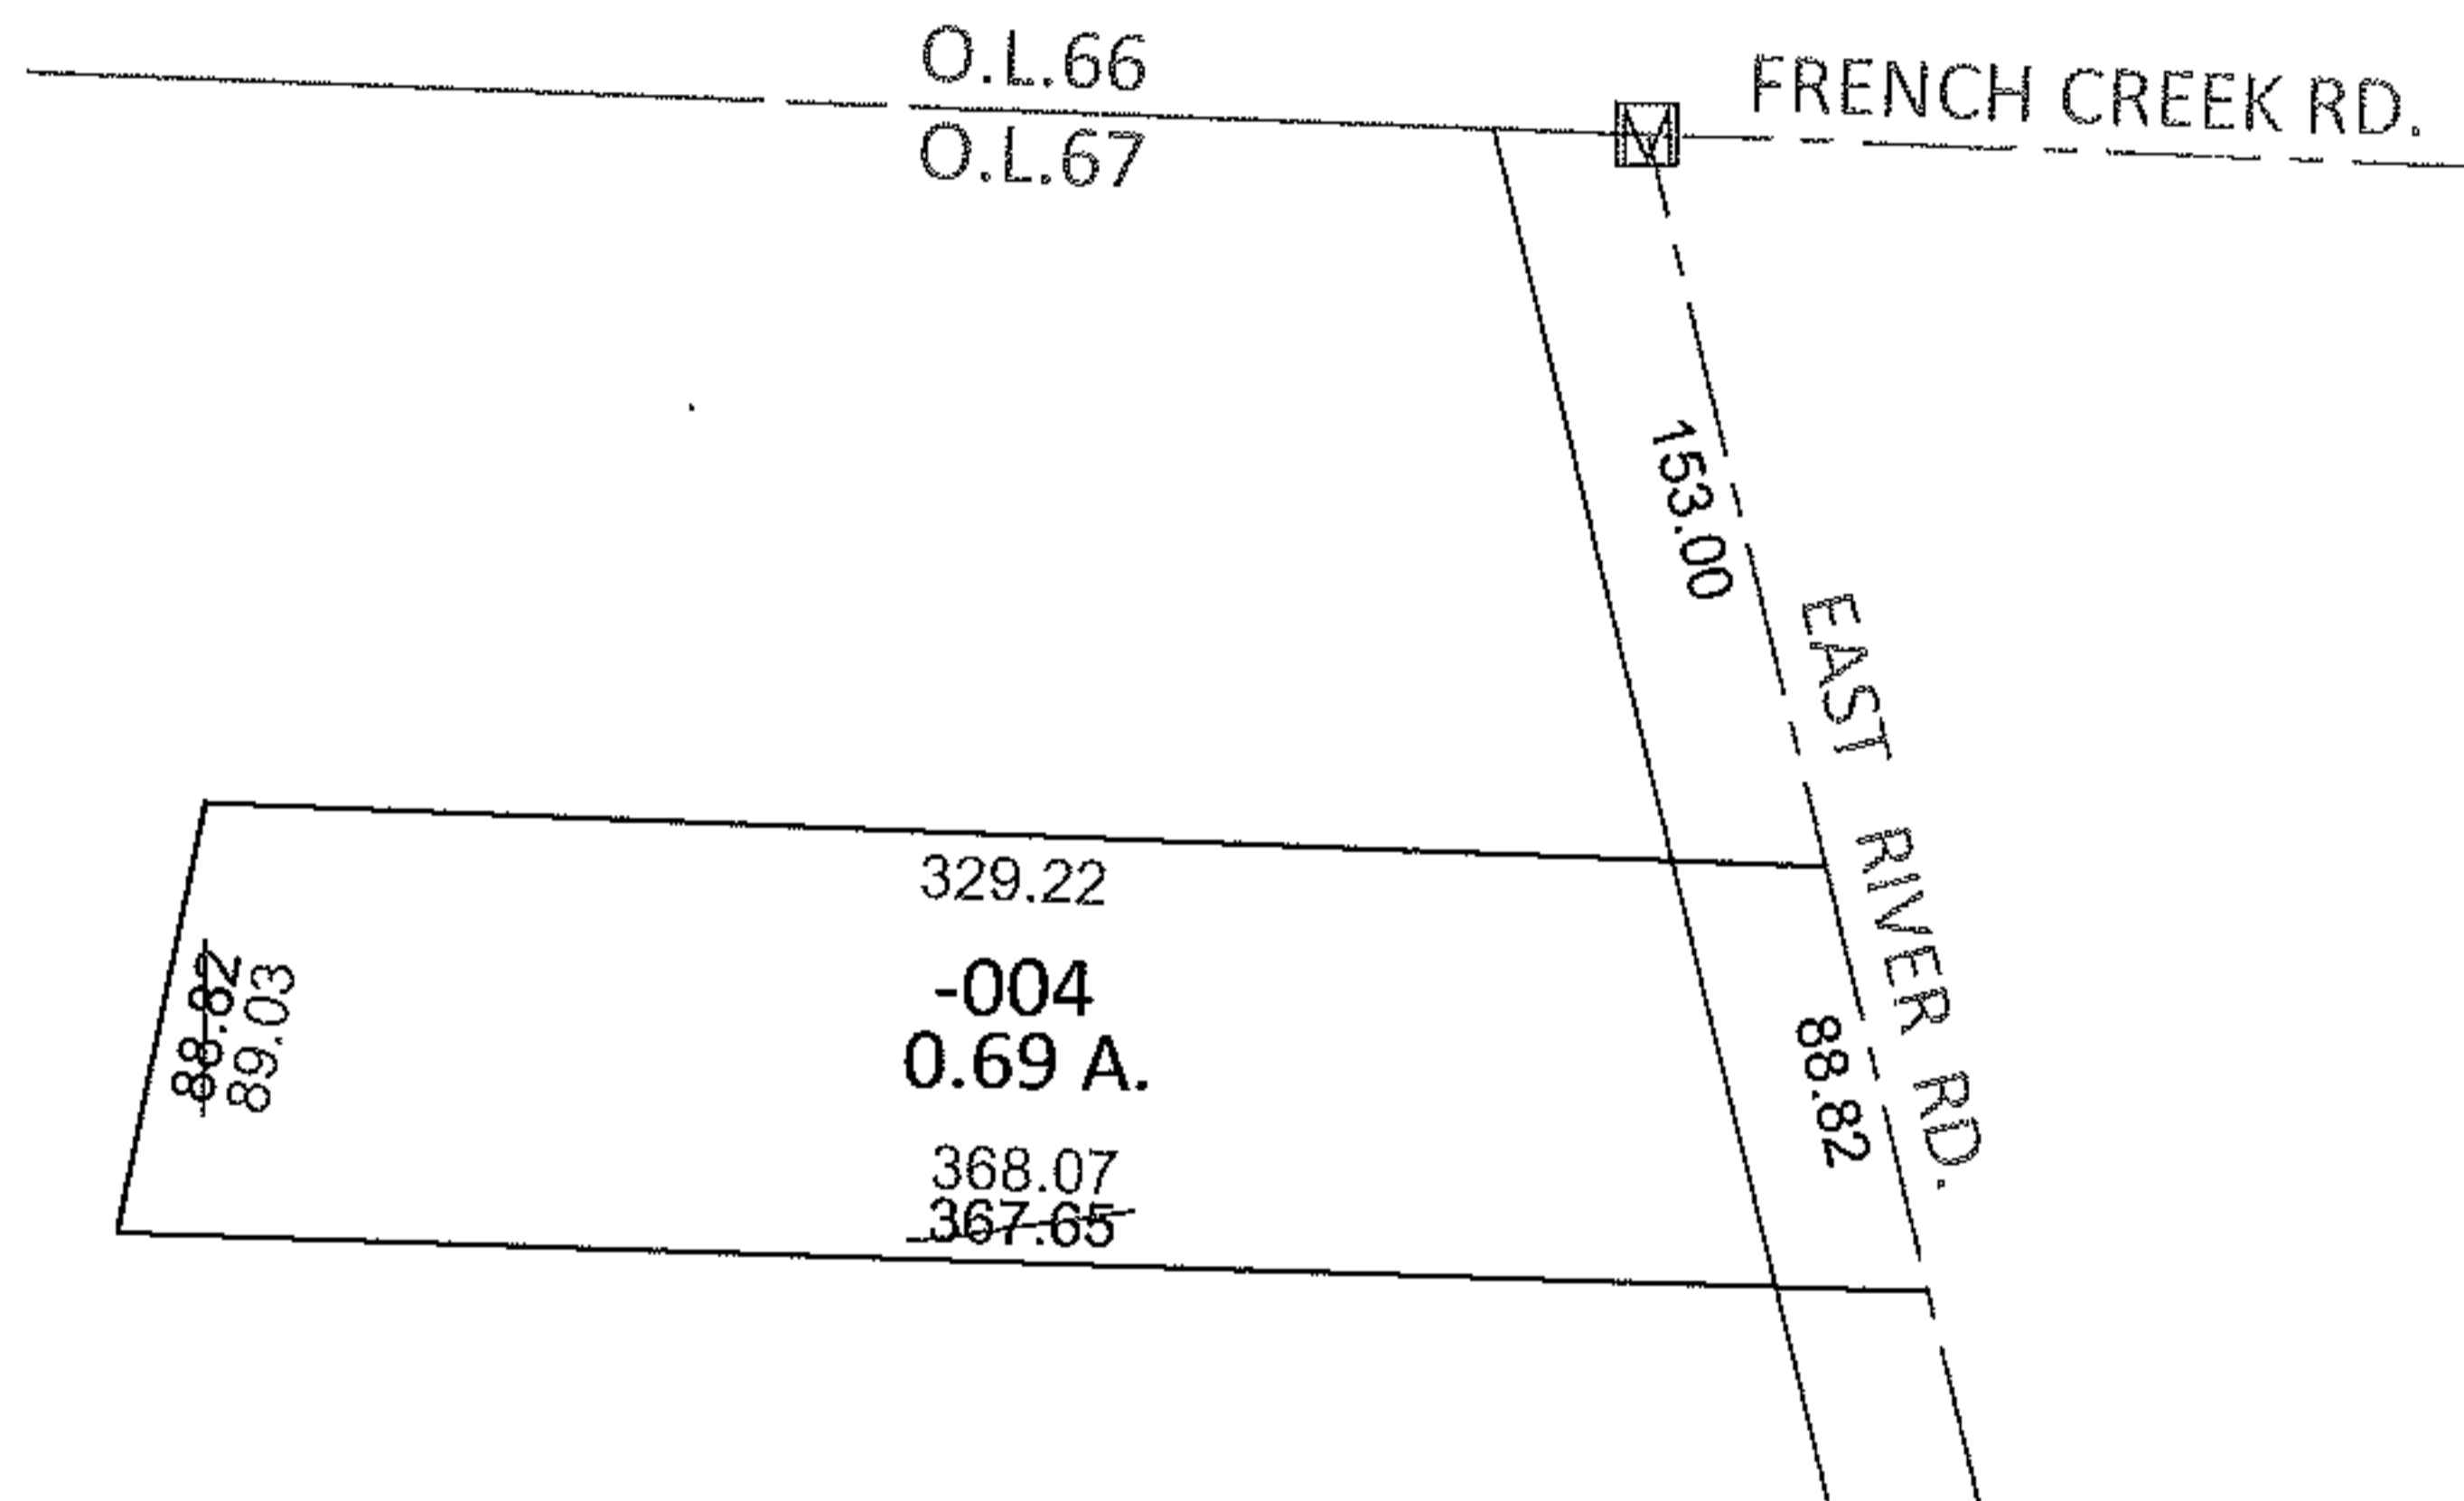


PARENT PARCEL: 03-00-067-000-004


CHILD PARCEL: _____

12-02551-D

STARTING POINT: AT A MON BOX AT THE INTERSECTION OF C/L OF EAST RIVER RD. AND C/L OF FRENCH CREEK RD.

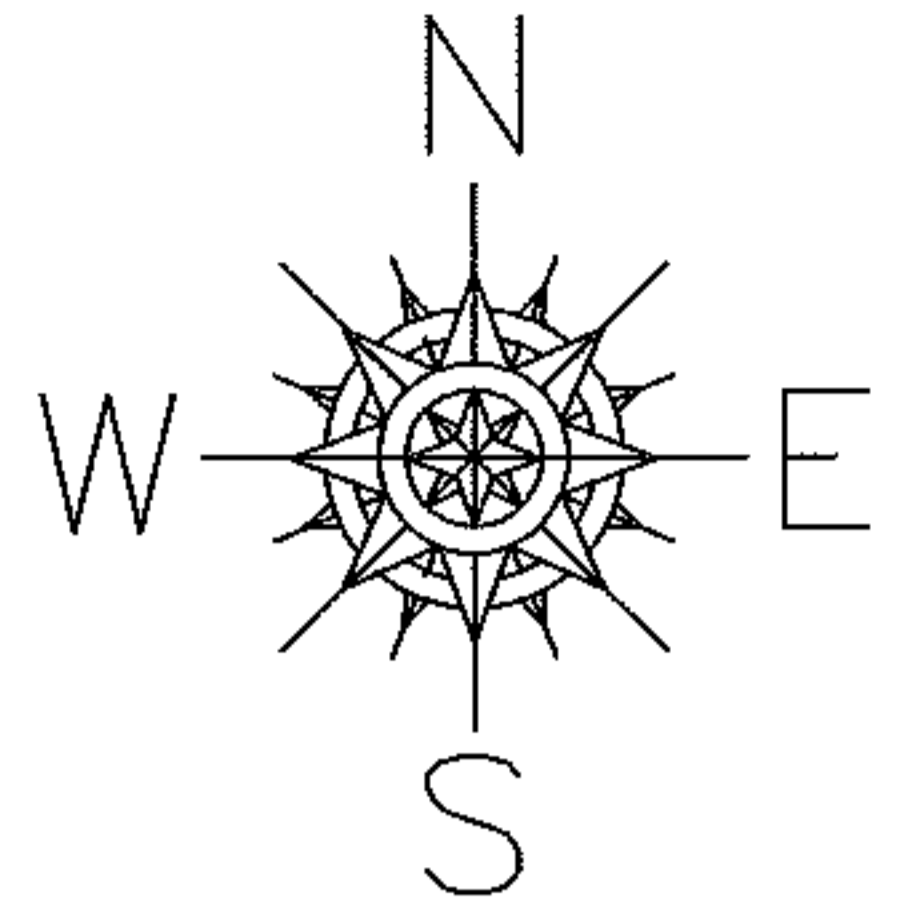

MAP CORRECTION ONLY

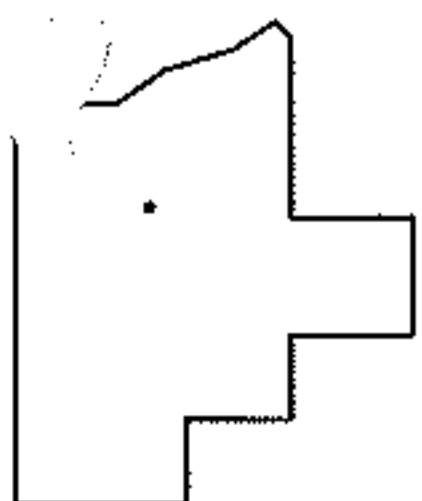

SPLITS/DEEDS PROCESSED

LORAIN COUNTY TAX MAP DEPARTMENT
226 MIDDLE AVE. ELYRIA, OHIO

SURVEYED BY: EDWARD B. DUDLEY III

CLOSURE: .01:10,000

MAP PAGE(S): 3-00-066-B

APPROVED BY: RRM DATE: 8-15-12

SCALE: 1" = 100 PRIOR INST.: 20110386317