

PARENT PARCEL: 06-24-084-101-006 & -007

CHILD PARCEL: XX-XX-XXX-XXX-XXX

STARTING POINT: NA

12-02552-C

FRONTAGE & DEPTH CORRECTION

06-24-084-101-006

~~73.33 X 165~~

73.6 X 165



CORR. PER INST. #20020846369

06-24-084-101-007

~~46.66 X 165~~

46.4 X 165

CORR. PER INST. #20050070744

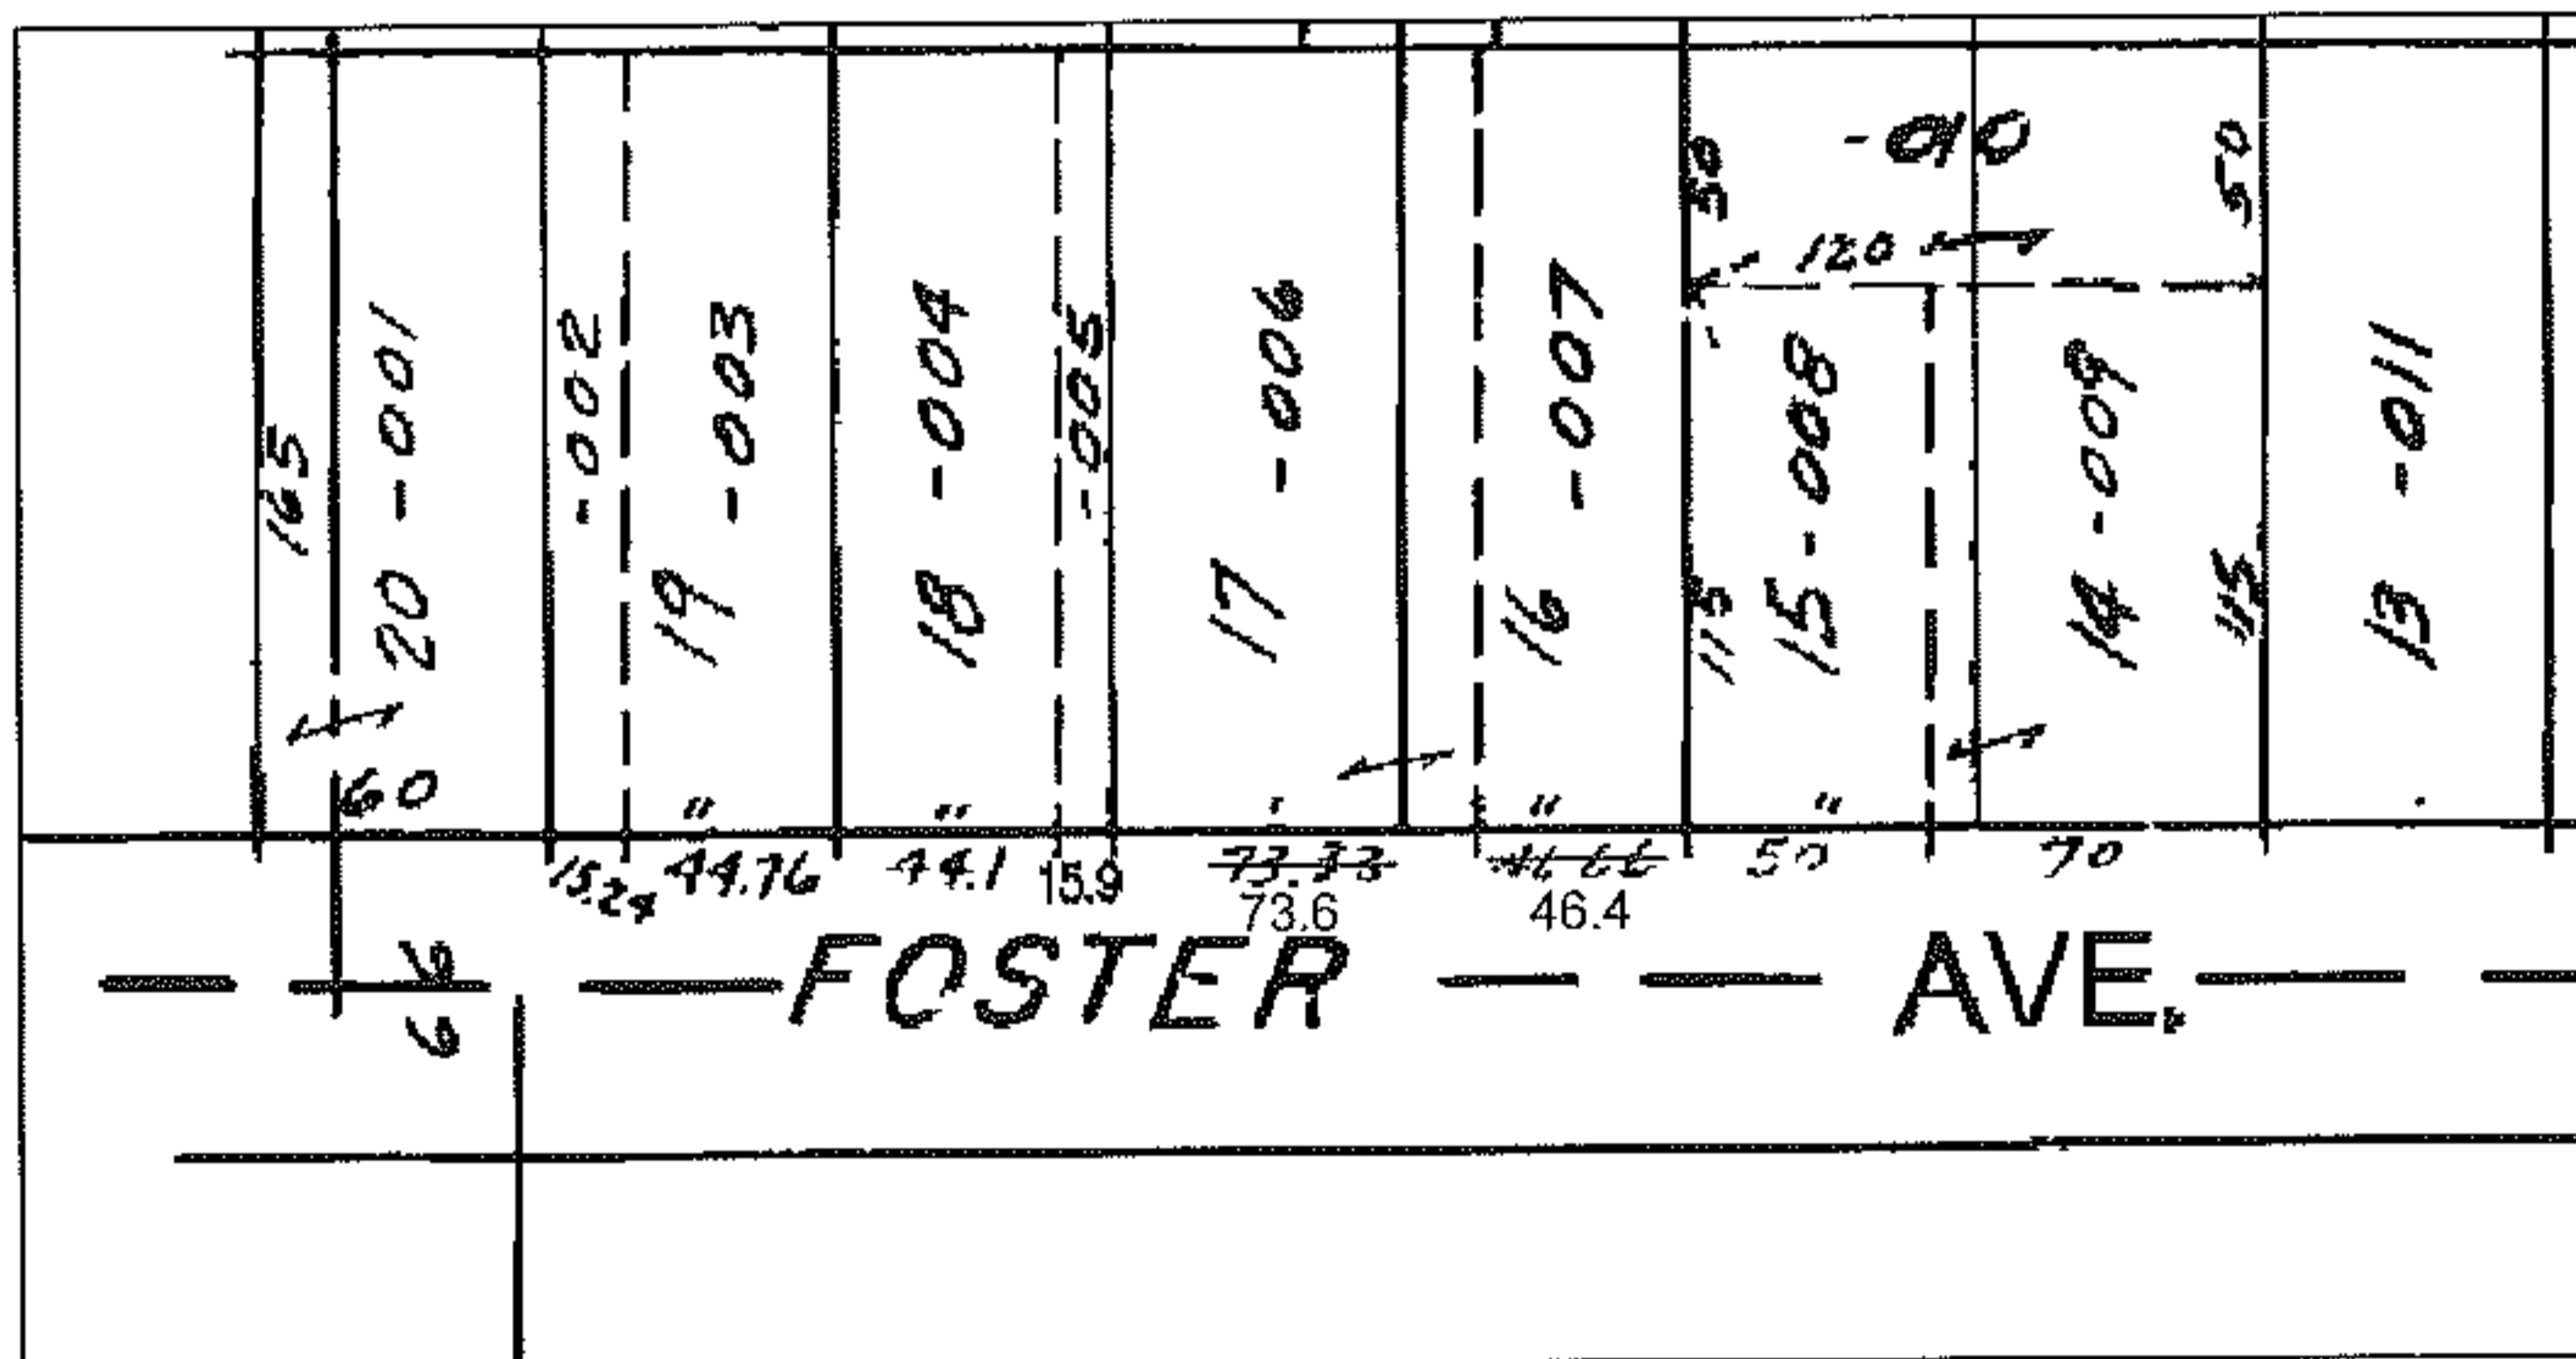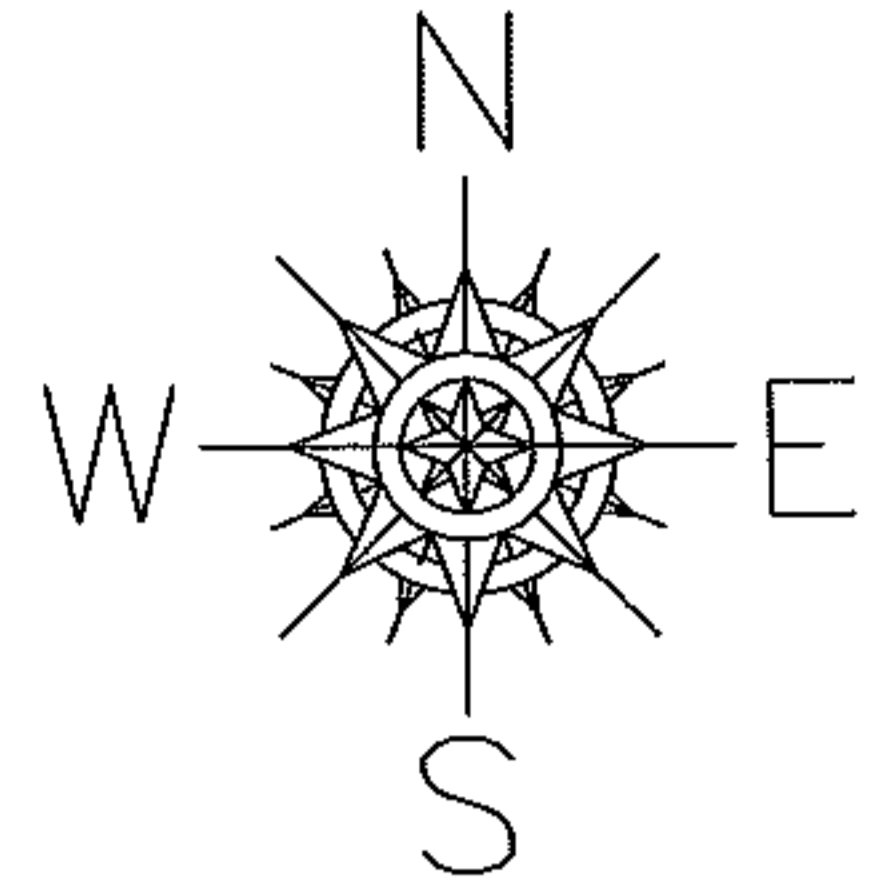

SPLITS/DEEDS PROCESSED

LORAIN COUNTY TAX MAP DEPARTMENT  
226 MIDDLE AVE. ELYRIA, OHIO

SURVEYED BY: NONE

CLOSURE: NA

MAP PAGE(S): 6-80

APPROVED BY: TJS DATE: 8/15/12

SCALE: 1"= 100 PRIOR INST.: NA