
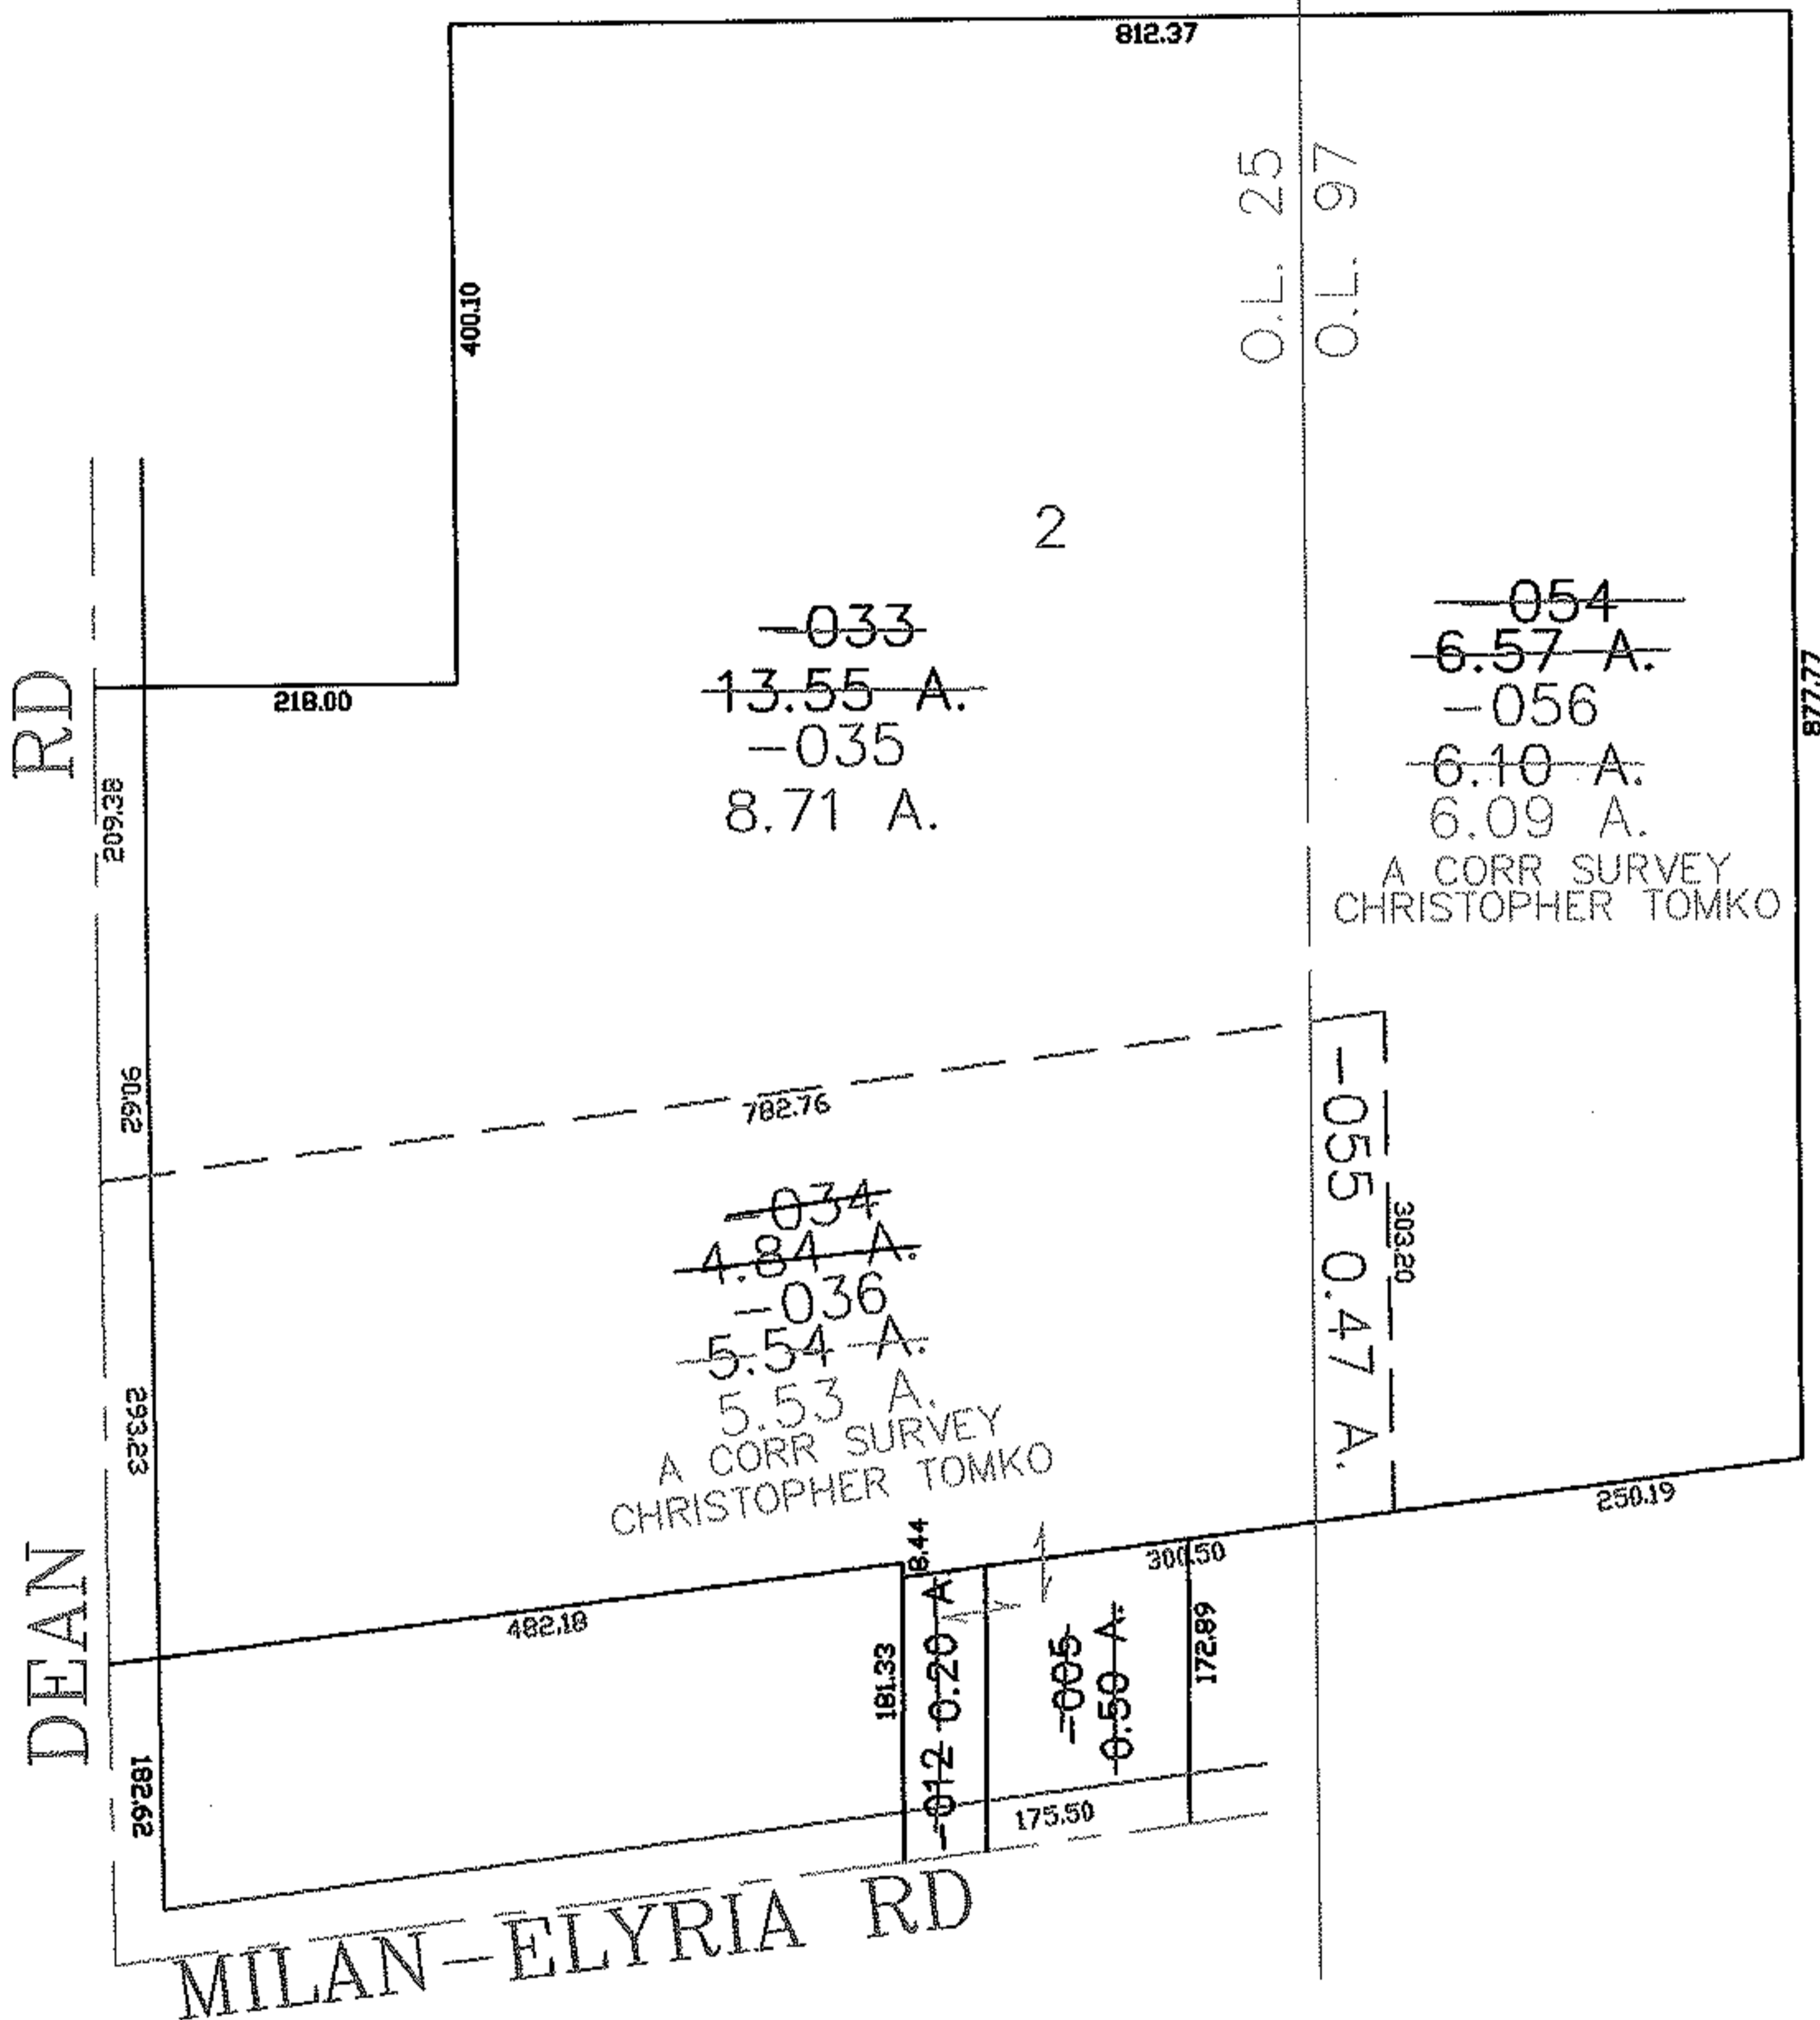


PARENT PARCEL: 08-20-025-000-033, -012, 005 08-00-097-000-054

CHILD PARCEL: 08-20-025-000-034 THRU -036, 08-00-097-000-055, -056


STARTING POINT: CENTERLINE OF DEAN RD & MILAN-ELYRIA RD

08-02552

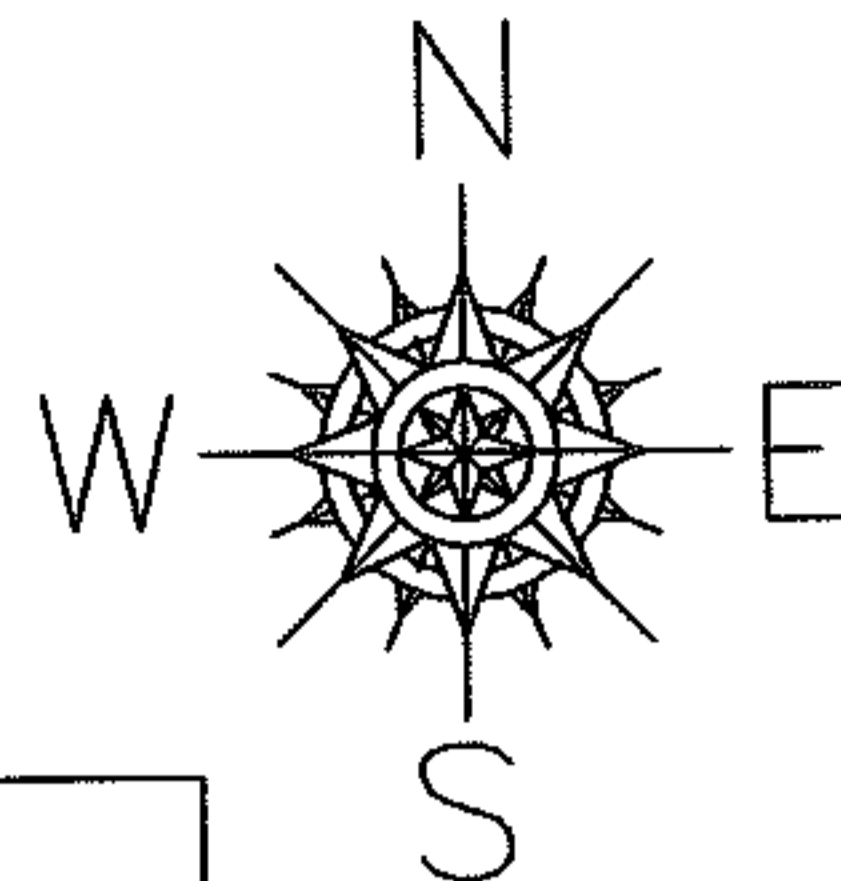

A CORR SURVEY
CHRISTOPHER TOMKO

A CORR SURVEY
CHRISTOPHER TOMKO

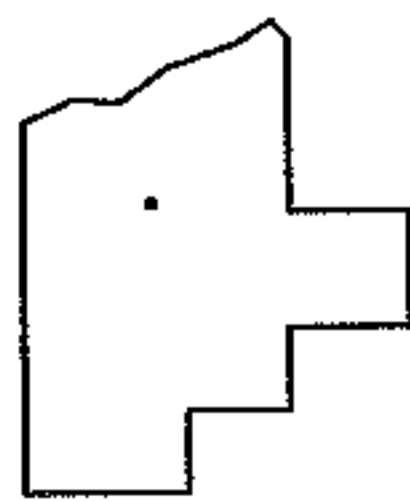

SPLITS/DEEDS PROCESSED
LORAIN COUNTY TAX MAP DEPARTMENT
226 MIDDLE AVE. ELYRIA, OHIO

SURVEYED BY: CHRISTOPHER TOMKO
CLOSURE: 0.00 : 10.000
MAP PAGE(S): 08-00-097-A
APPROVED BY: JAH DATE: 4-16-08
SCALE: 1" = 200 PRIOR INSTRUMENT: 20040031498