


PARENT PARCEL: 06-21-003-101-020, 06-23-002-101-005

CHILD PARCEL: 06-21-003-101-020, 06-23-002-101-006, 06-23-004-101-004

STARTING POINT: INTERSECTION OF C/L OF MURRAY RIDGE RD. AND C/L OF DELLEFIELD RD.

12-02555-A

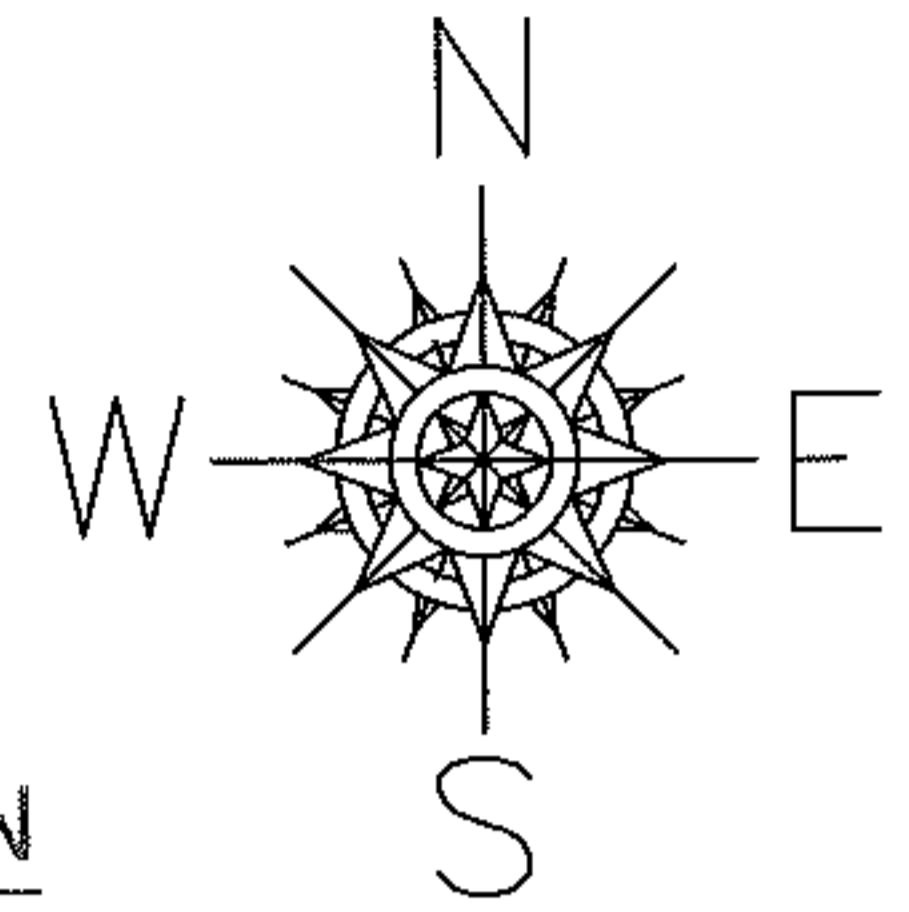

ACREAGE BREAKDOWN

~~06-23-002-101-005~~

~~25.73 A.~~

06-23-002-101-006
22.50 A.



06-23-004-101-004
~~3.23 A.~~
4.03 A.

PER SURV. T.SIMON

~~-020~~
~~11.62 A.~~
10.83 A.
AC.CORR.PER.SURV.
T.SIMON

~~-004~~
~~3.23 A.~~
4.03 A.
AC.CORR.PER.SURV.
T.SIMON

~~-005~~
~~25.73 A.~~
-006
22.50 A.

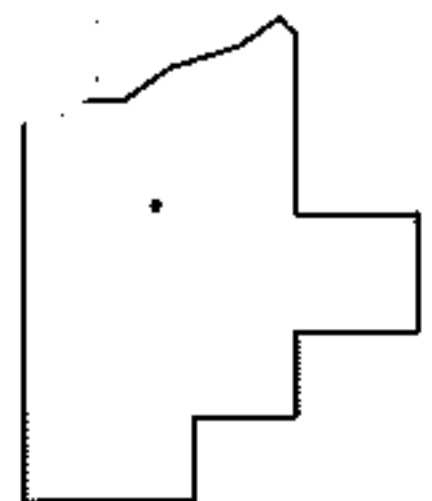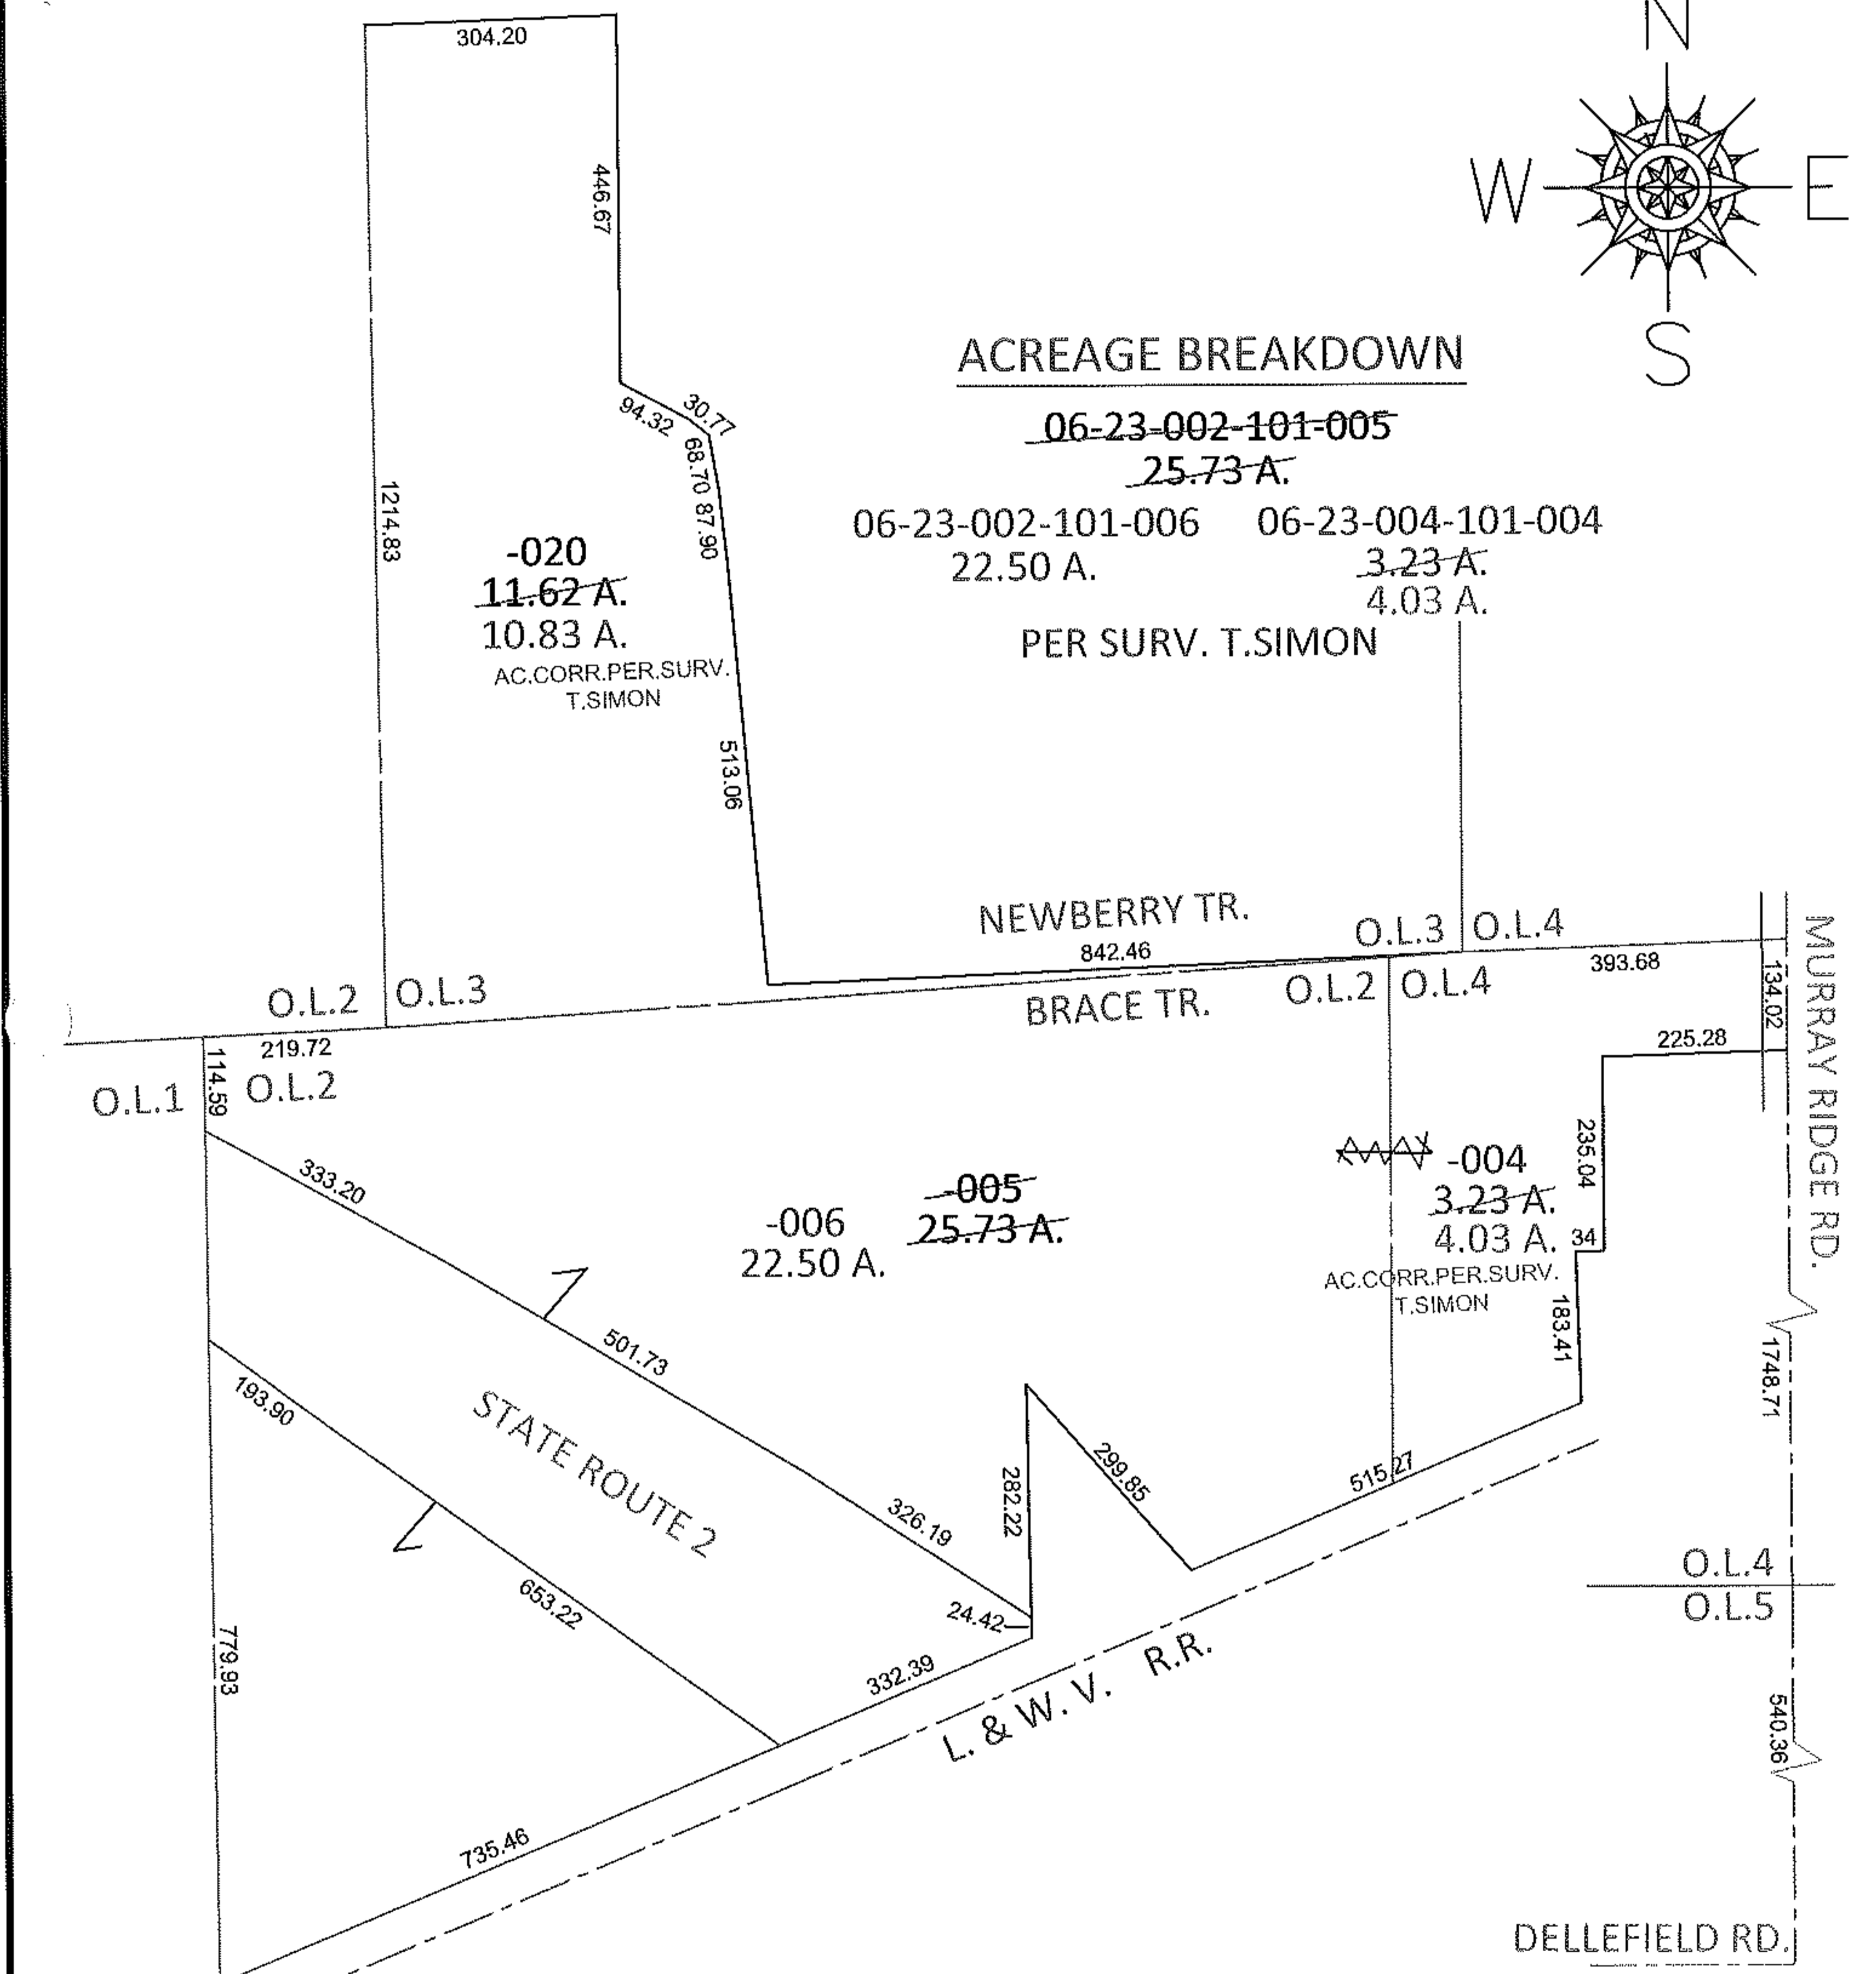

SPLITS/DEEDS PROCESSED

LORAIN COUNTY TAX MAP DEPARTMENT
226 MIDDLE AVE. ELYRIA, OHIO

SURVEYED BY: THOMAS A. SIMON

CLOSURE: .01:10,000

MAP PAGE(S): 6-21, 6-22, 6-3, 6-4

APPROVED BY: RRM DATE: 8-17-12

SCALE: 1" = 300 PRIOR INST.: DV 1418/234