
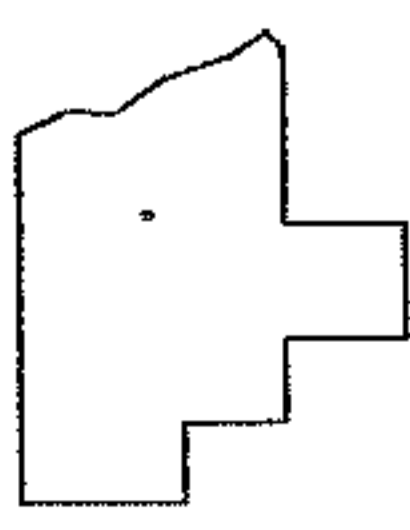
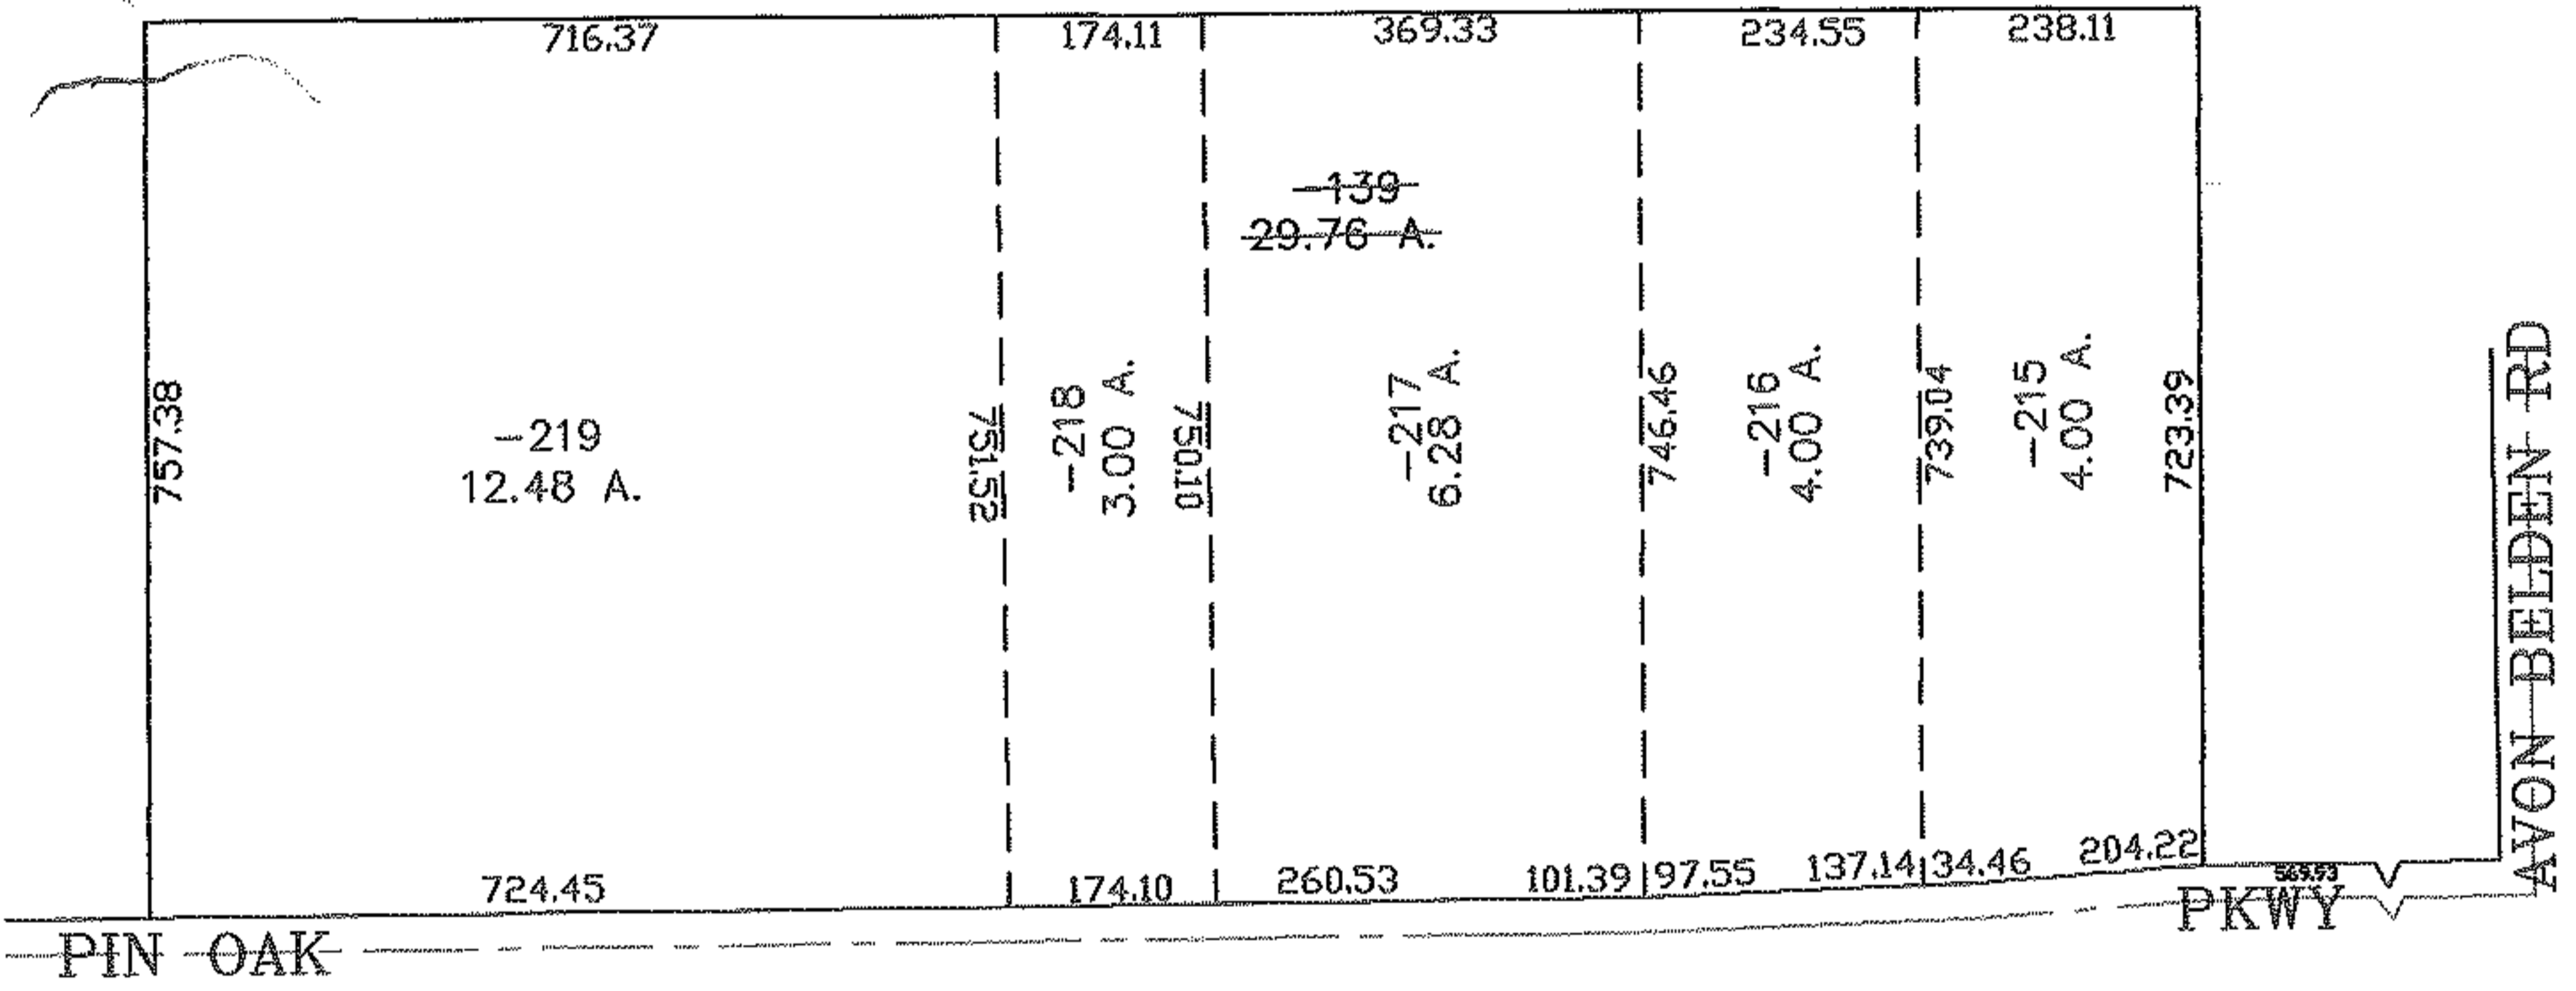


PARENT PARCEL: 04-00-017-102-139

CHILD PARCEL: 04-00-017-102-215 THRU -219

STARTING POINT: SIDELINE OF AVON BELDEN RD & PIN OAK PKWY

08-02556

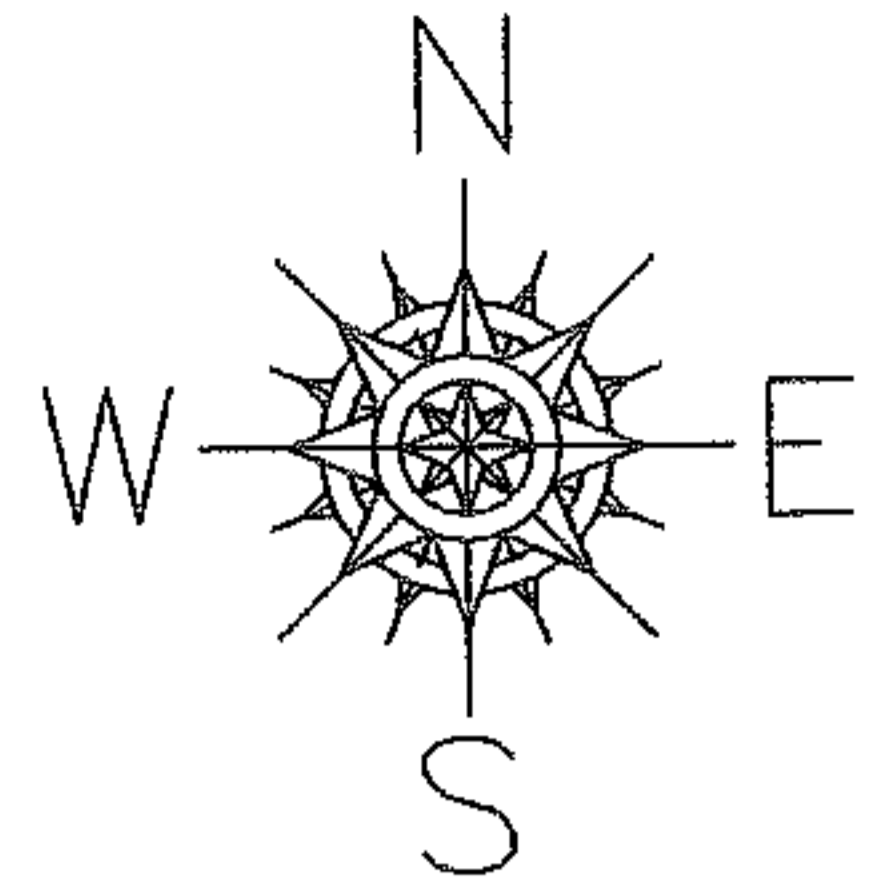

SPLITS/DEEDS PROCESSED

LORAIN COUNTY TAX MAP DEPARTMENT
 226 MIDDLE AVE. ELYRIA, OHIO

SURVEYED BY: DALE HAYWOOD
 CLOSURE: 0.00 : 10.000
 MAP PAGE(S): 04-00-017-E
 APPROVED BY: JAH DATE: 4-17-08
 SCALE: 1" = 300' PRIOR INSTRUMENT: 19990586884