




PARENT PARCEL: 05-00-094-103-027, -008

CHILD PARCEL: 05-00-094-103-068 THRU -070

STARTING POINT: CENTERLINE OF MIDDLE RIDGE RD & QUARRY RD

08-02559

MIDDLE RIDGE RD

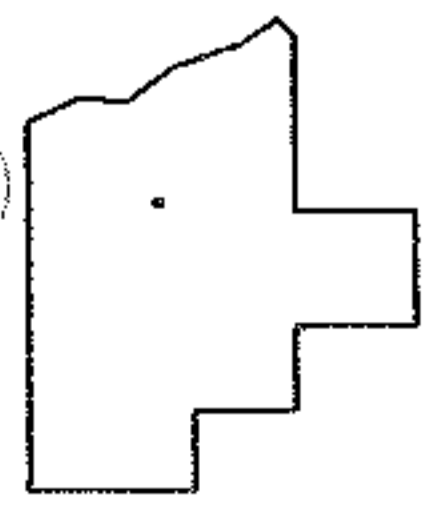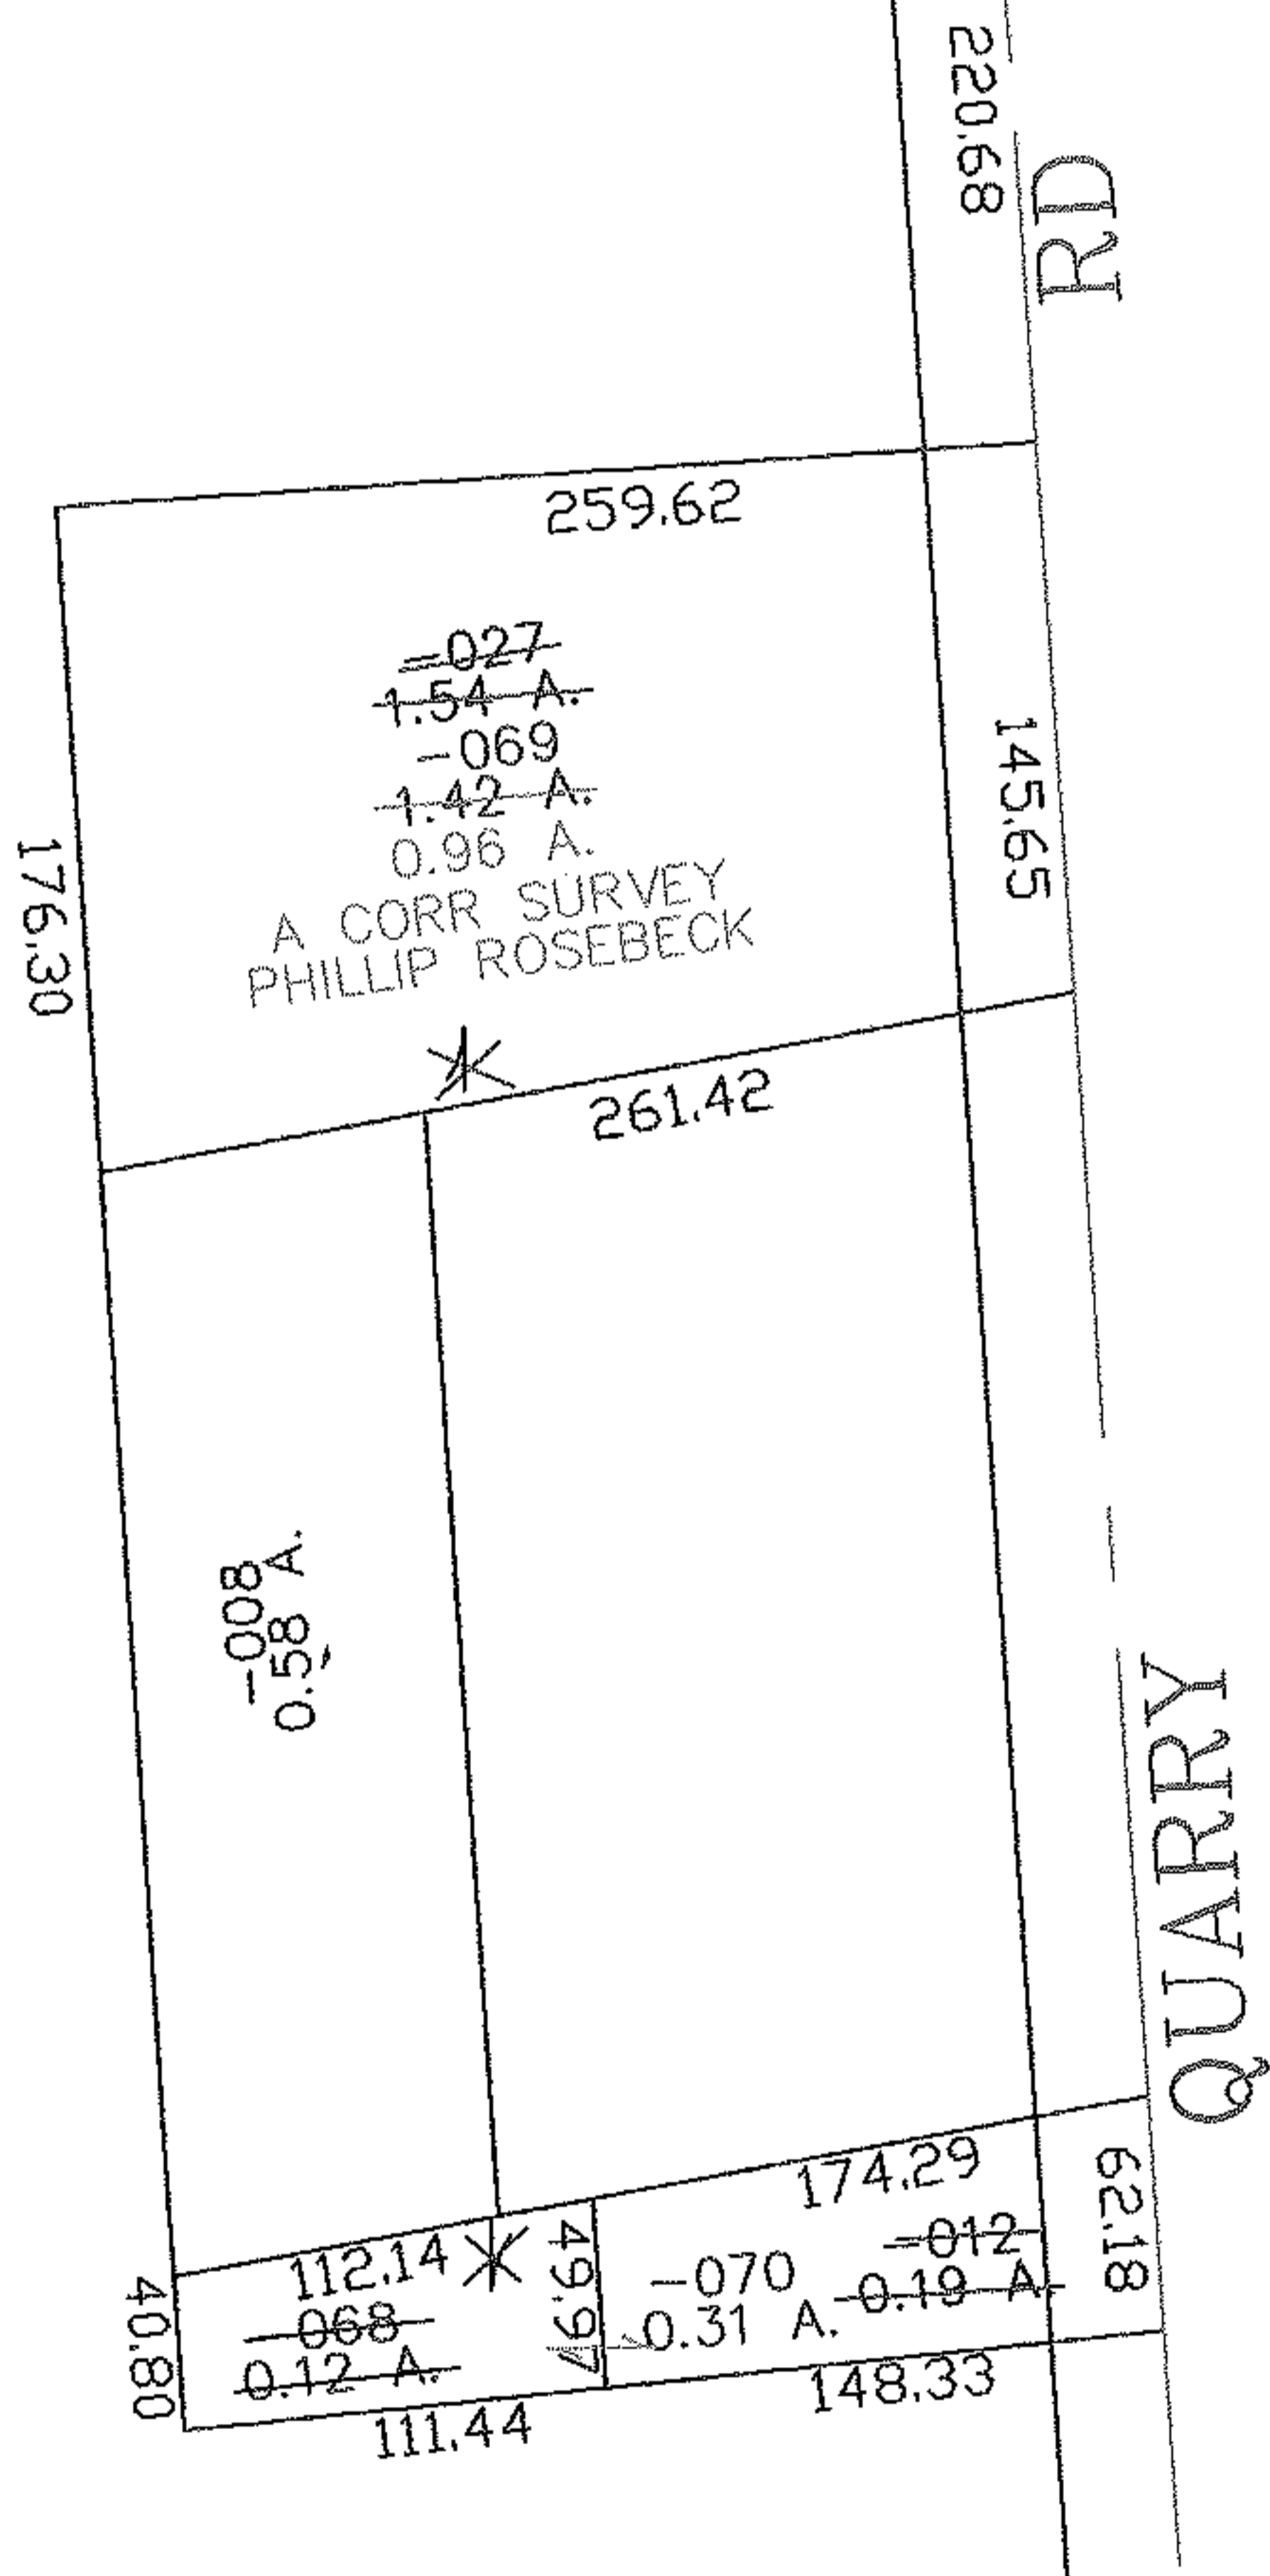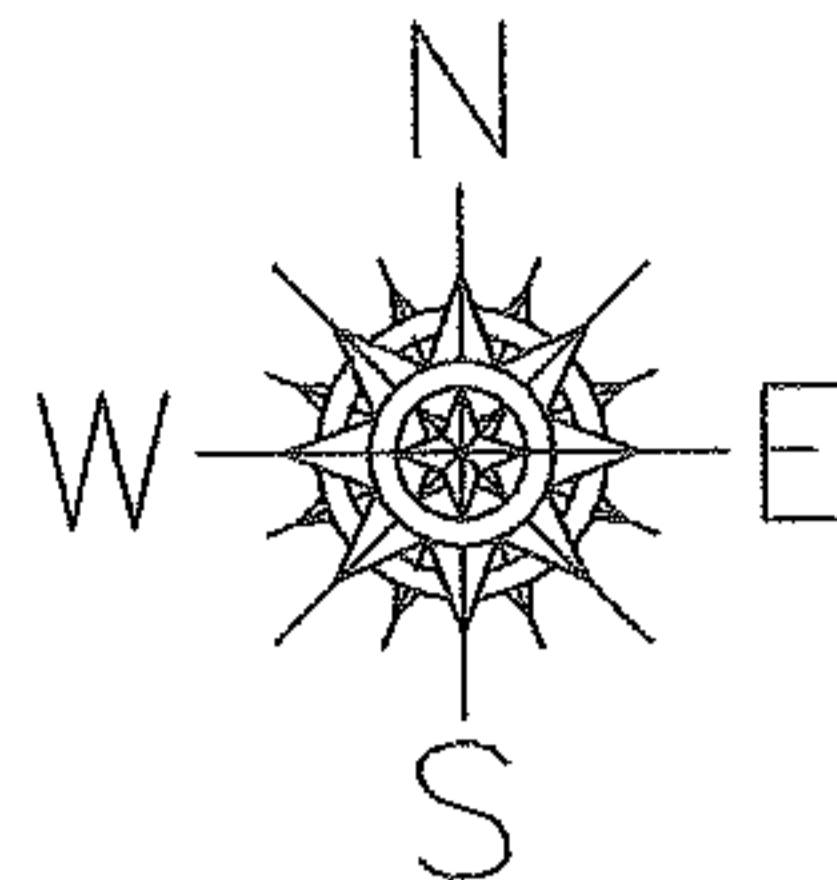

SPLITS/DEEDS PROCESSED

LORAIN COUNTY TAX MAP DEPARTMENT  
226 MIDDLE AVE. ELYRIA, OHIO

SURVEYED BY: PHILLIP ROSEBECK

CLOSURE: 0.00 : 10,000

MAP PAGE(S): 05-00-094-B

APPROVED BY: JAH DATE: 4-25-08

SCALE: 1" = 100 PRIOR INSTRUMENT: 20030955076