




RASTER

PARENT PARCEL: 04-00-013-000-090

CHILD PARCEL: 04-00-013-000-564 THRU -567

STARTING POINT: CENTERLINE OF RIEGELSBERGER RD & O.L. 13

08-02560

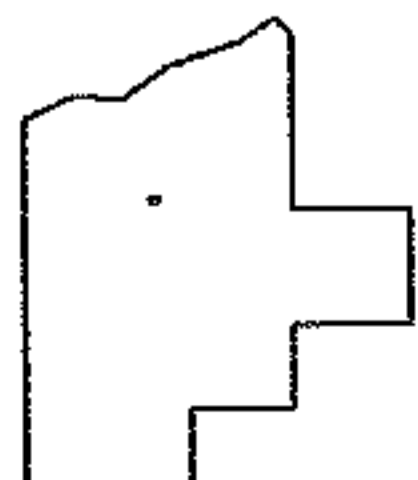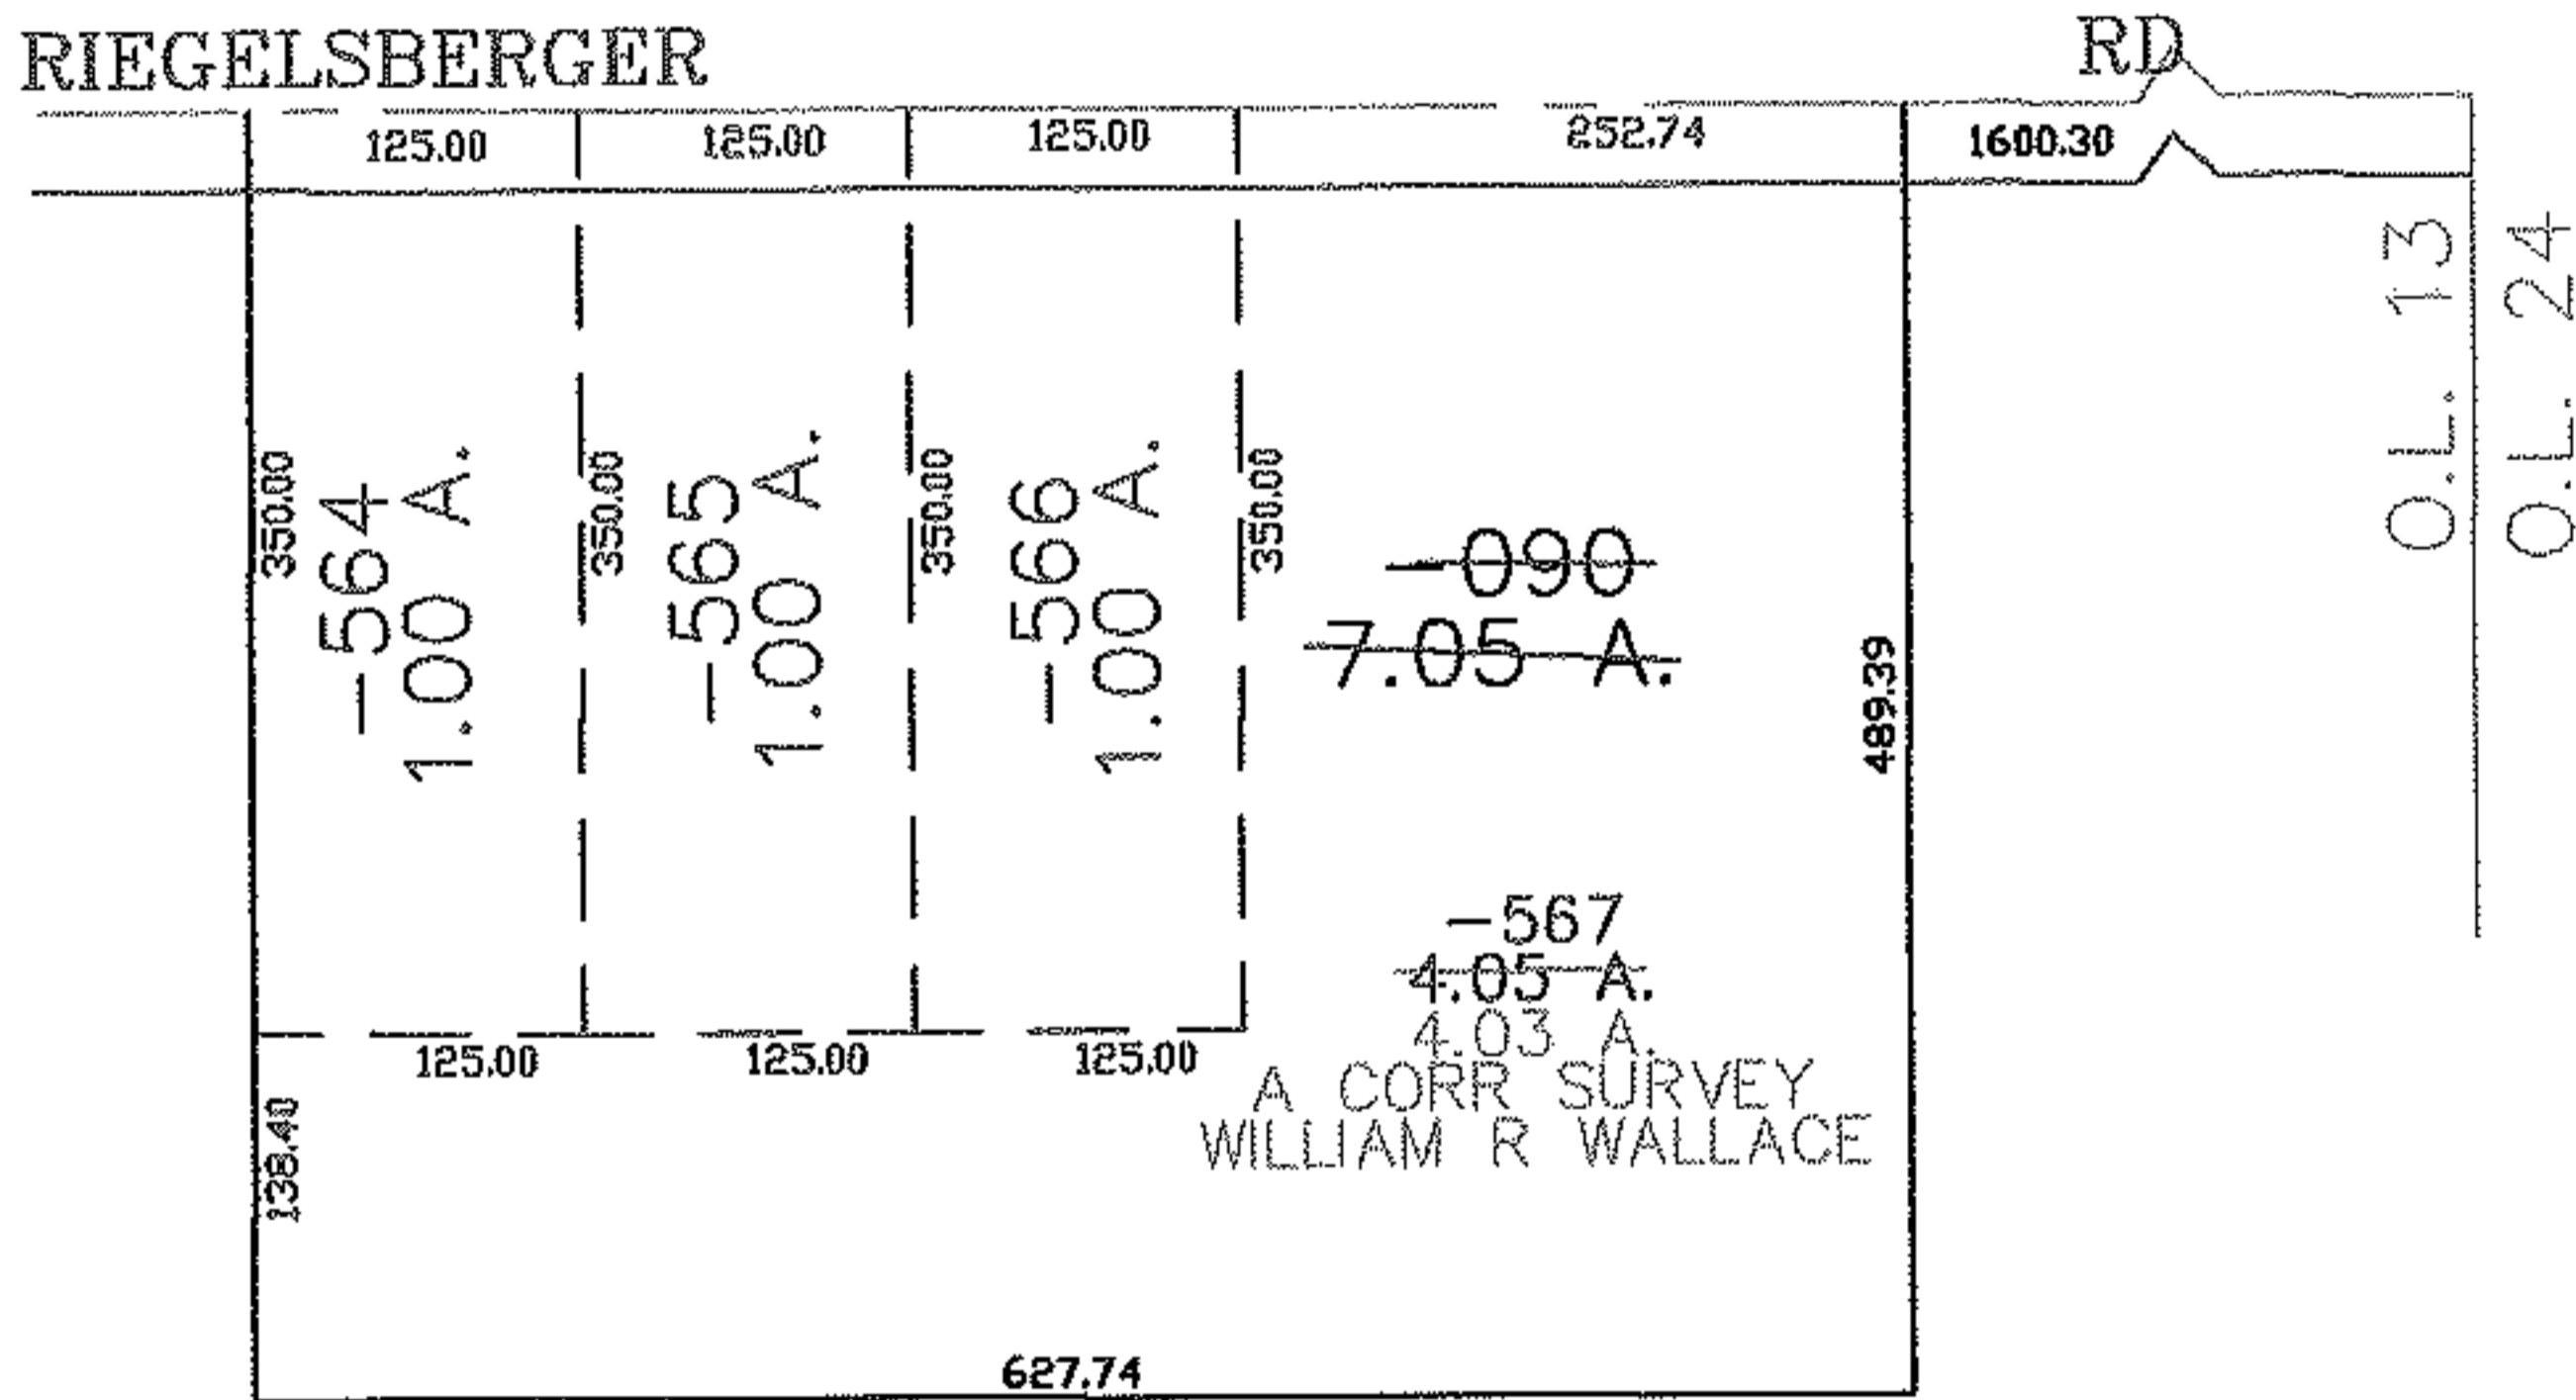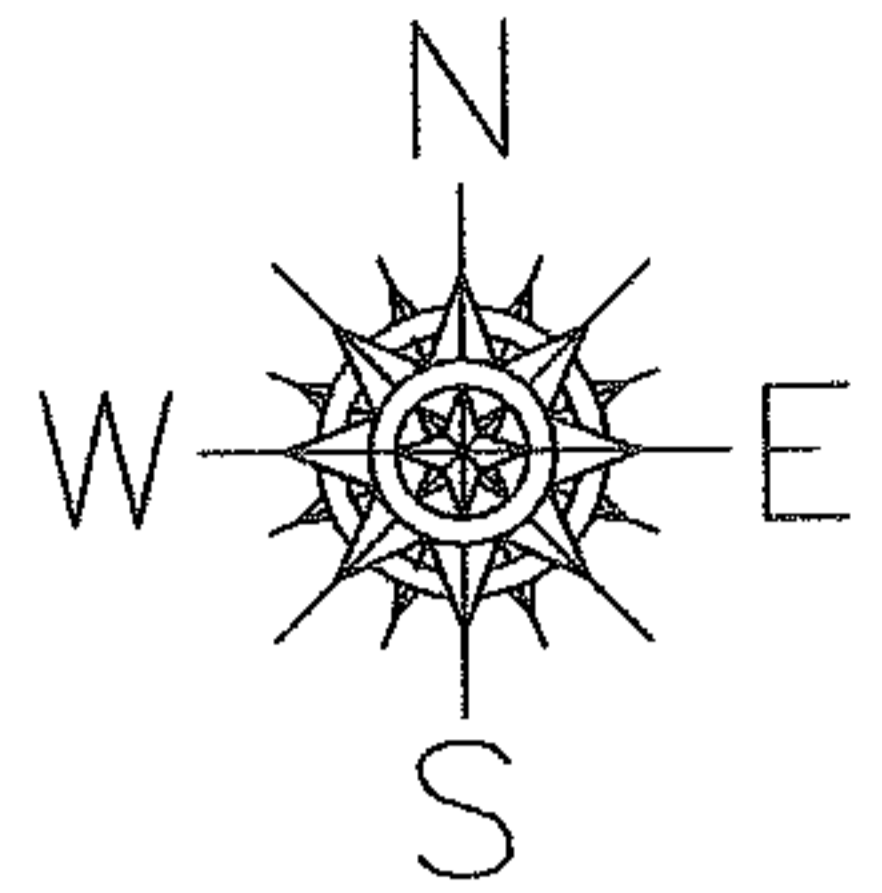

SPLITS/DEEDS PROCESSED

LORAIN COUNTY TAX MAP DEPARTMENT  
226 MIDDLE AVE. ELYRIA, OHIO

SURVEYED BY: WILLIAM R WALLACE

CLOSURE: 0.00 : 10,000

MAP PAGE(S): 04-25-08 04-00-013-C

APPROVED BY: JAH DATE: 4-25-08

SCALE: 1" = 200 PRIOR INSTRUMENT: 20070218882