
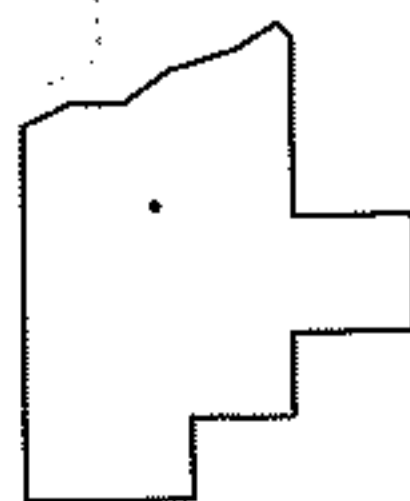
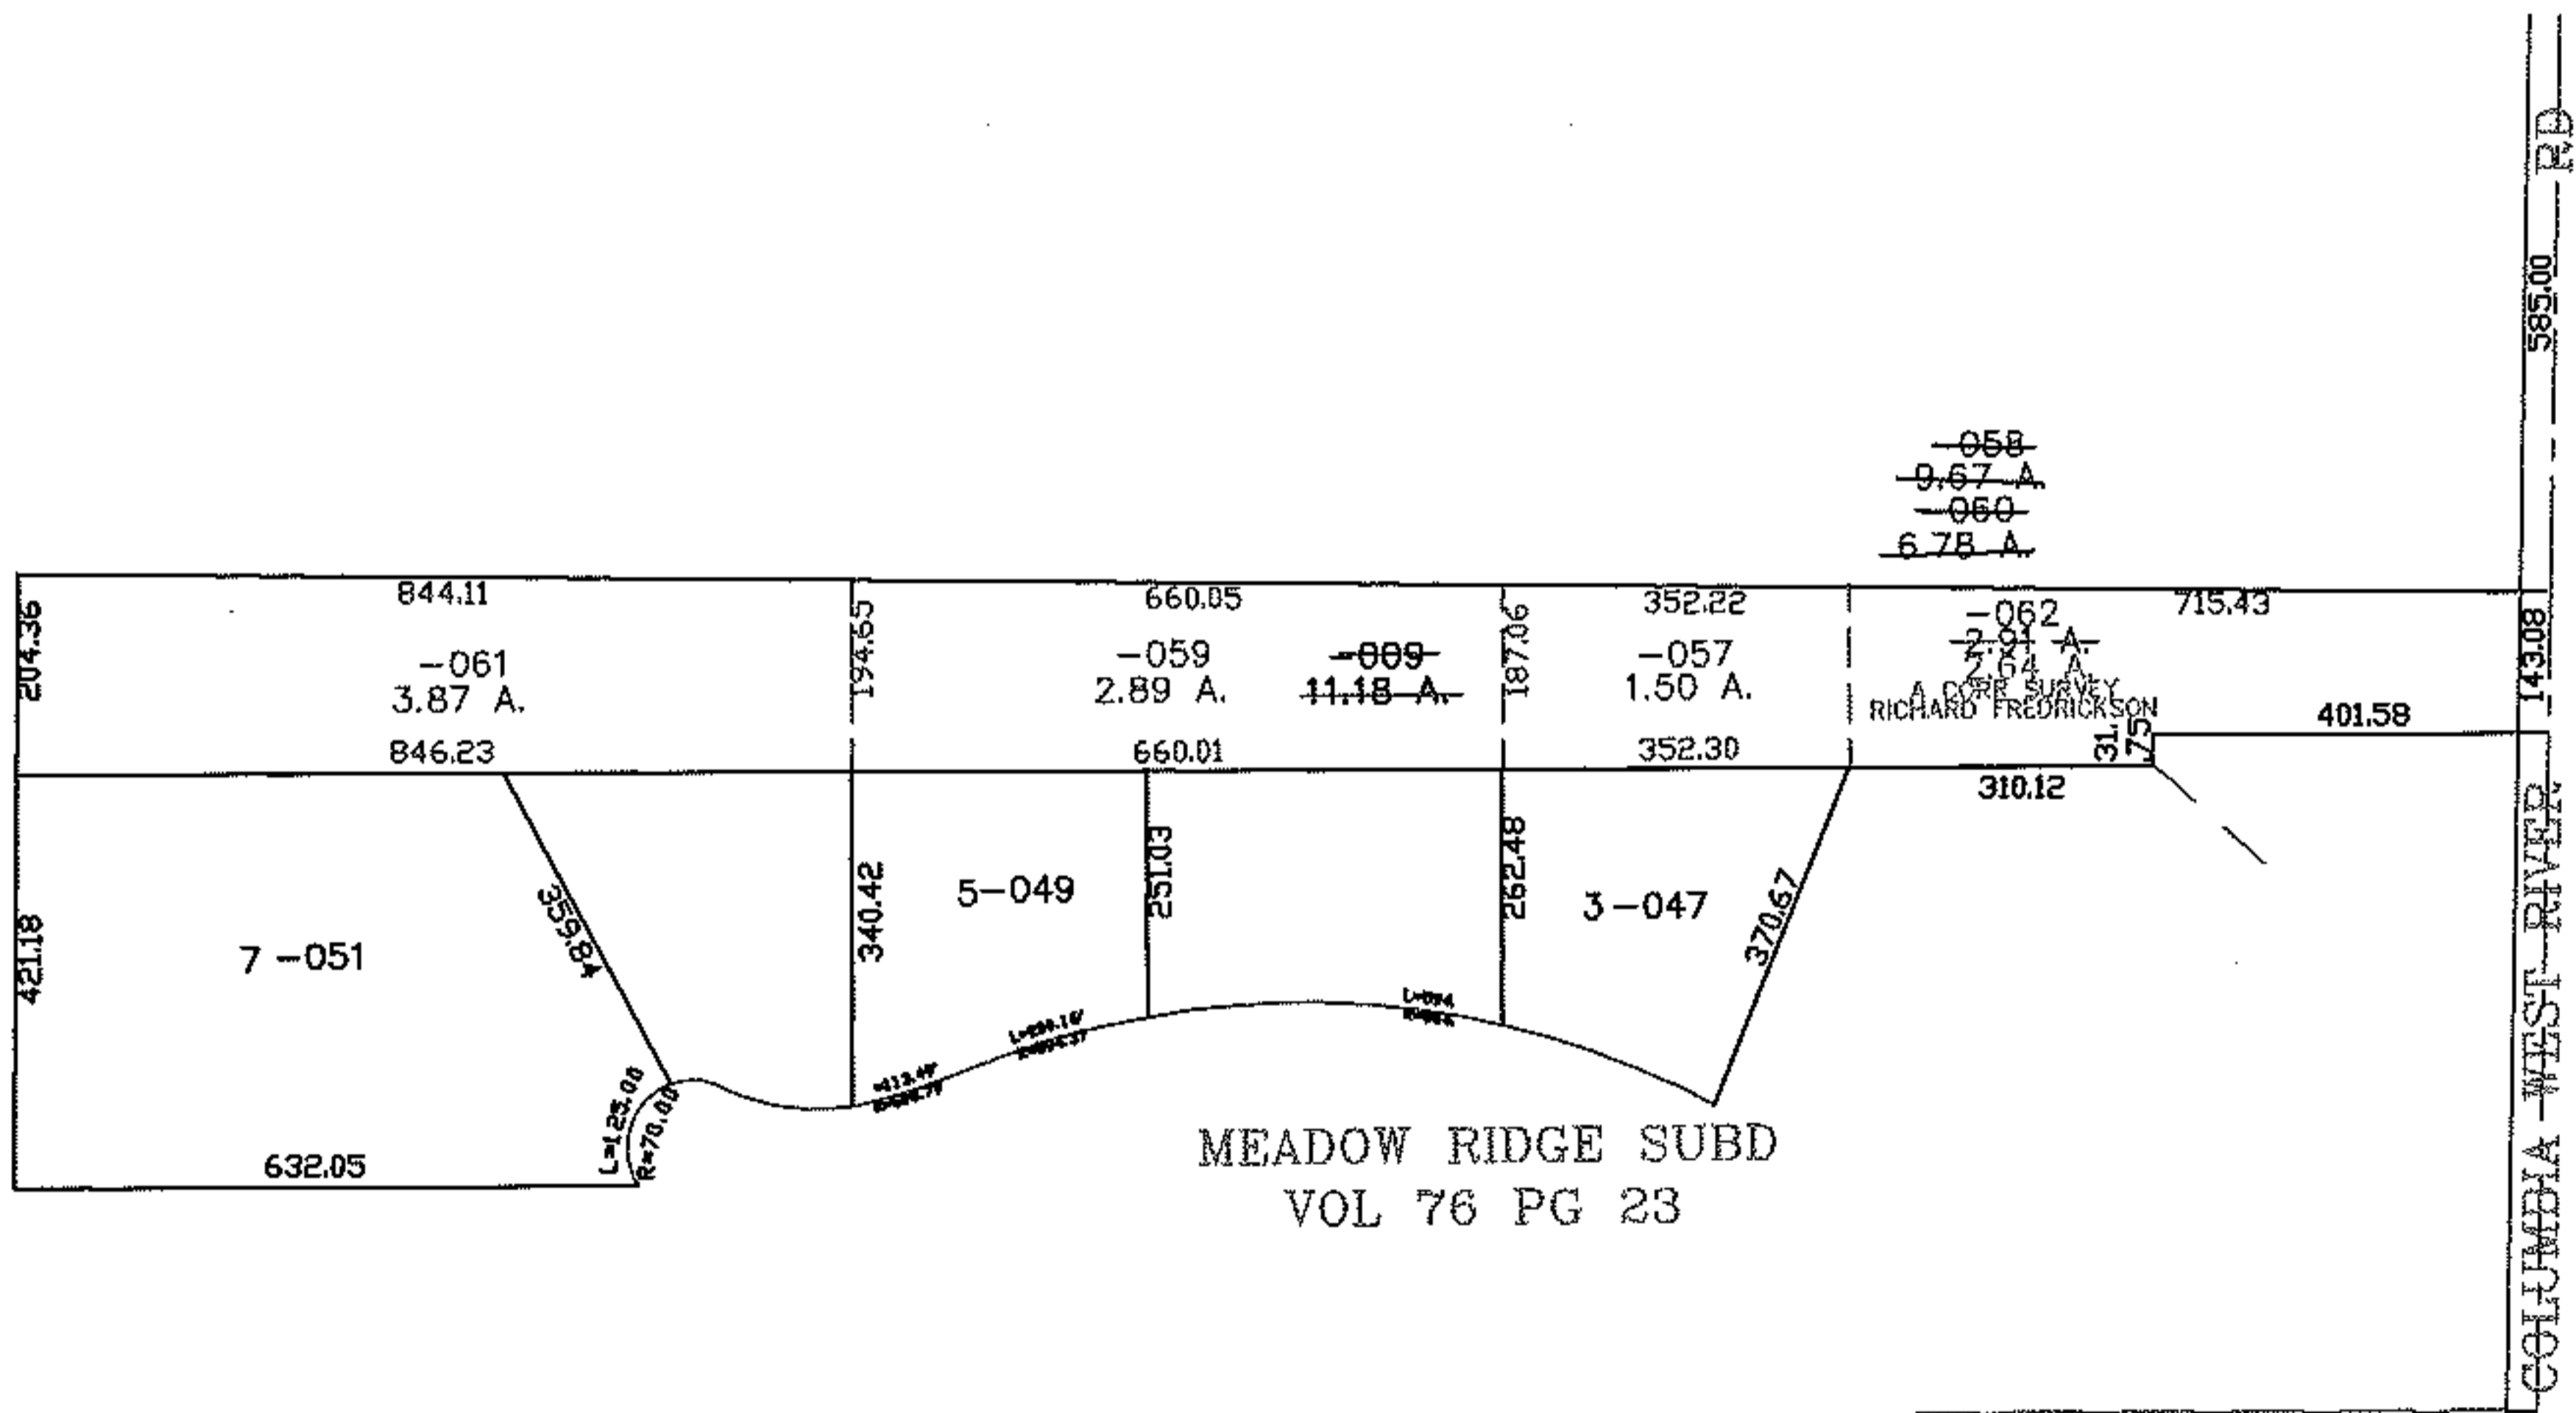


RASTER

PARENT PARCEL: 12-00-054-000-009, -047, -049, -051
CHILD PARCEL: 12-00-054-000-057 THRU -062
STARTING POINT: CENTERLINE OF COLUMBIA WEST RIVER RD & SE CORNER OF MEADOW RIDGE

08-02562

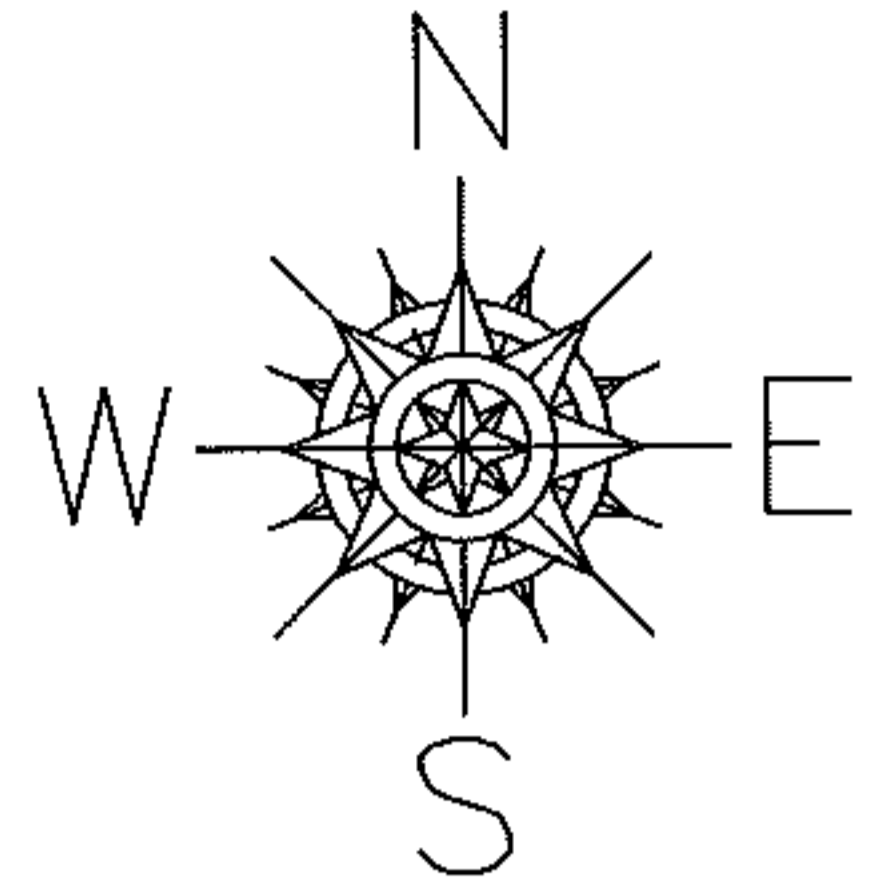

SPLITS/DEEDS PROCESSED
LORAIN COUNTY TAX MAP DEPARTMENT
226 MIDDLE AVE. ELYRIA, OHIO

SURVEYED BY: RICHARD FREDRICKSON
CLOSURE: 0.00 : 10.000
MAP PAGE(S): 12-00-054-A
APPROVED BY: JAH DATE: 7-28-08
SCALE: 1" = 400 PRIOR INSTRUMENT: DV 1186/402